


B.M. 189.48, City Std. @ Woodlawn & 25th St. N.E. Side of Woodlawn.
 B.M. 186.04 Step bench E-face H.L.P. N. Side Woodlawn NE cor. Old English Manor.
 B.M. 188.73 "M" in Mueller Fire Hydrant W-side Woodlawn NE cor. Old English Manor.

Plan Scale 1" = 40'
 Profile Scale 1" = 40' Horiz.
 1" = 5' Vert.

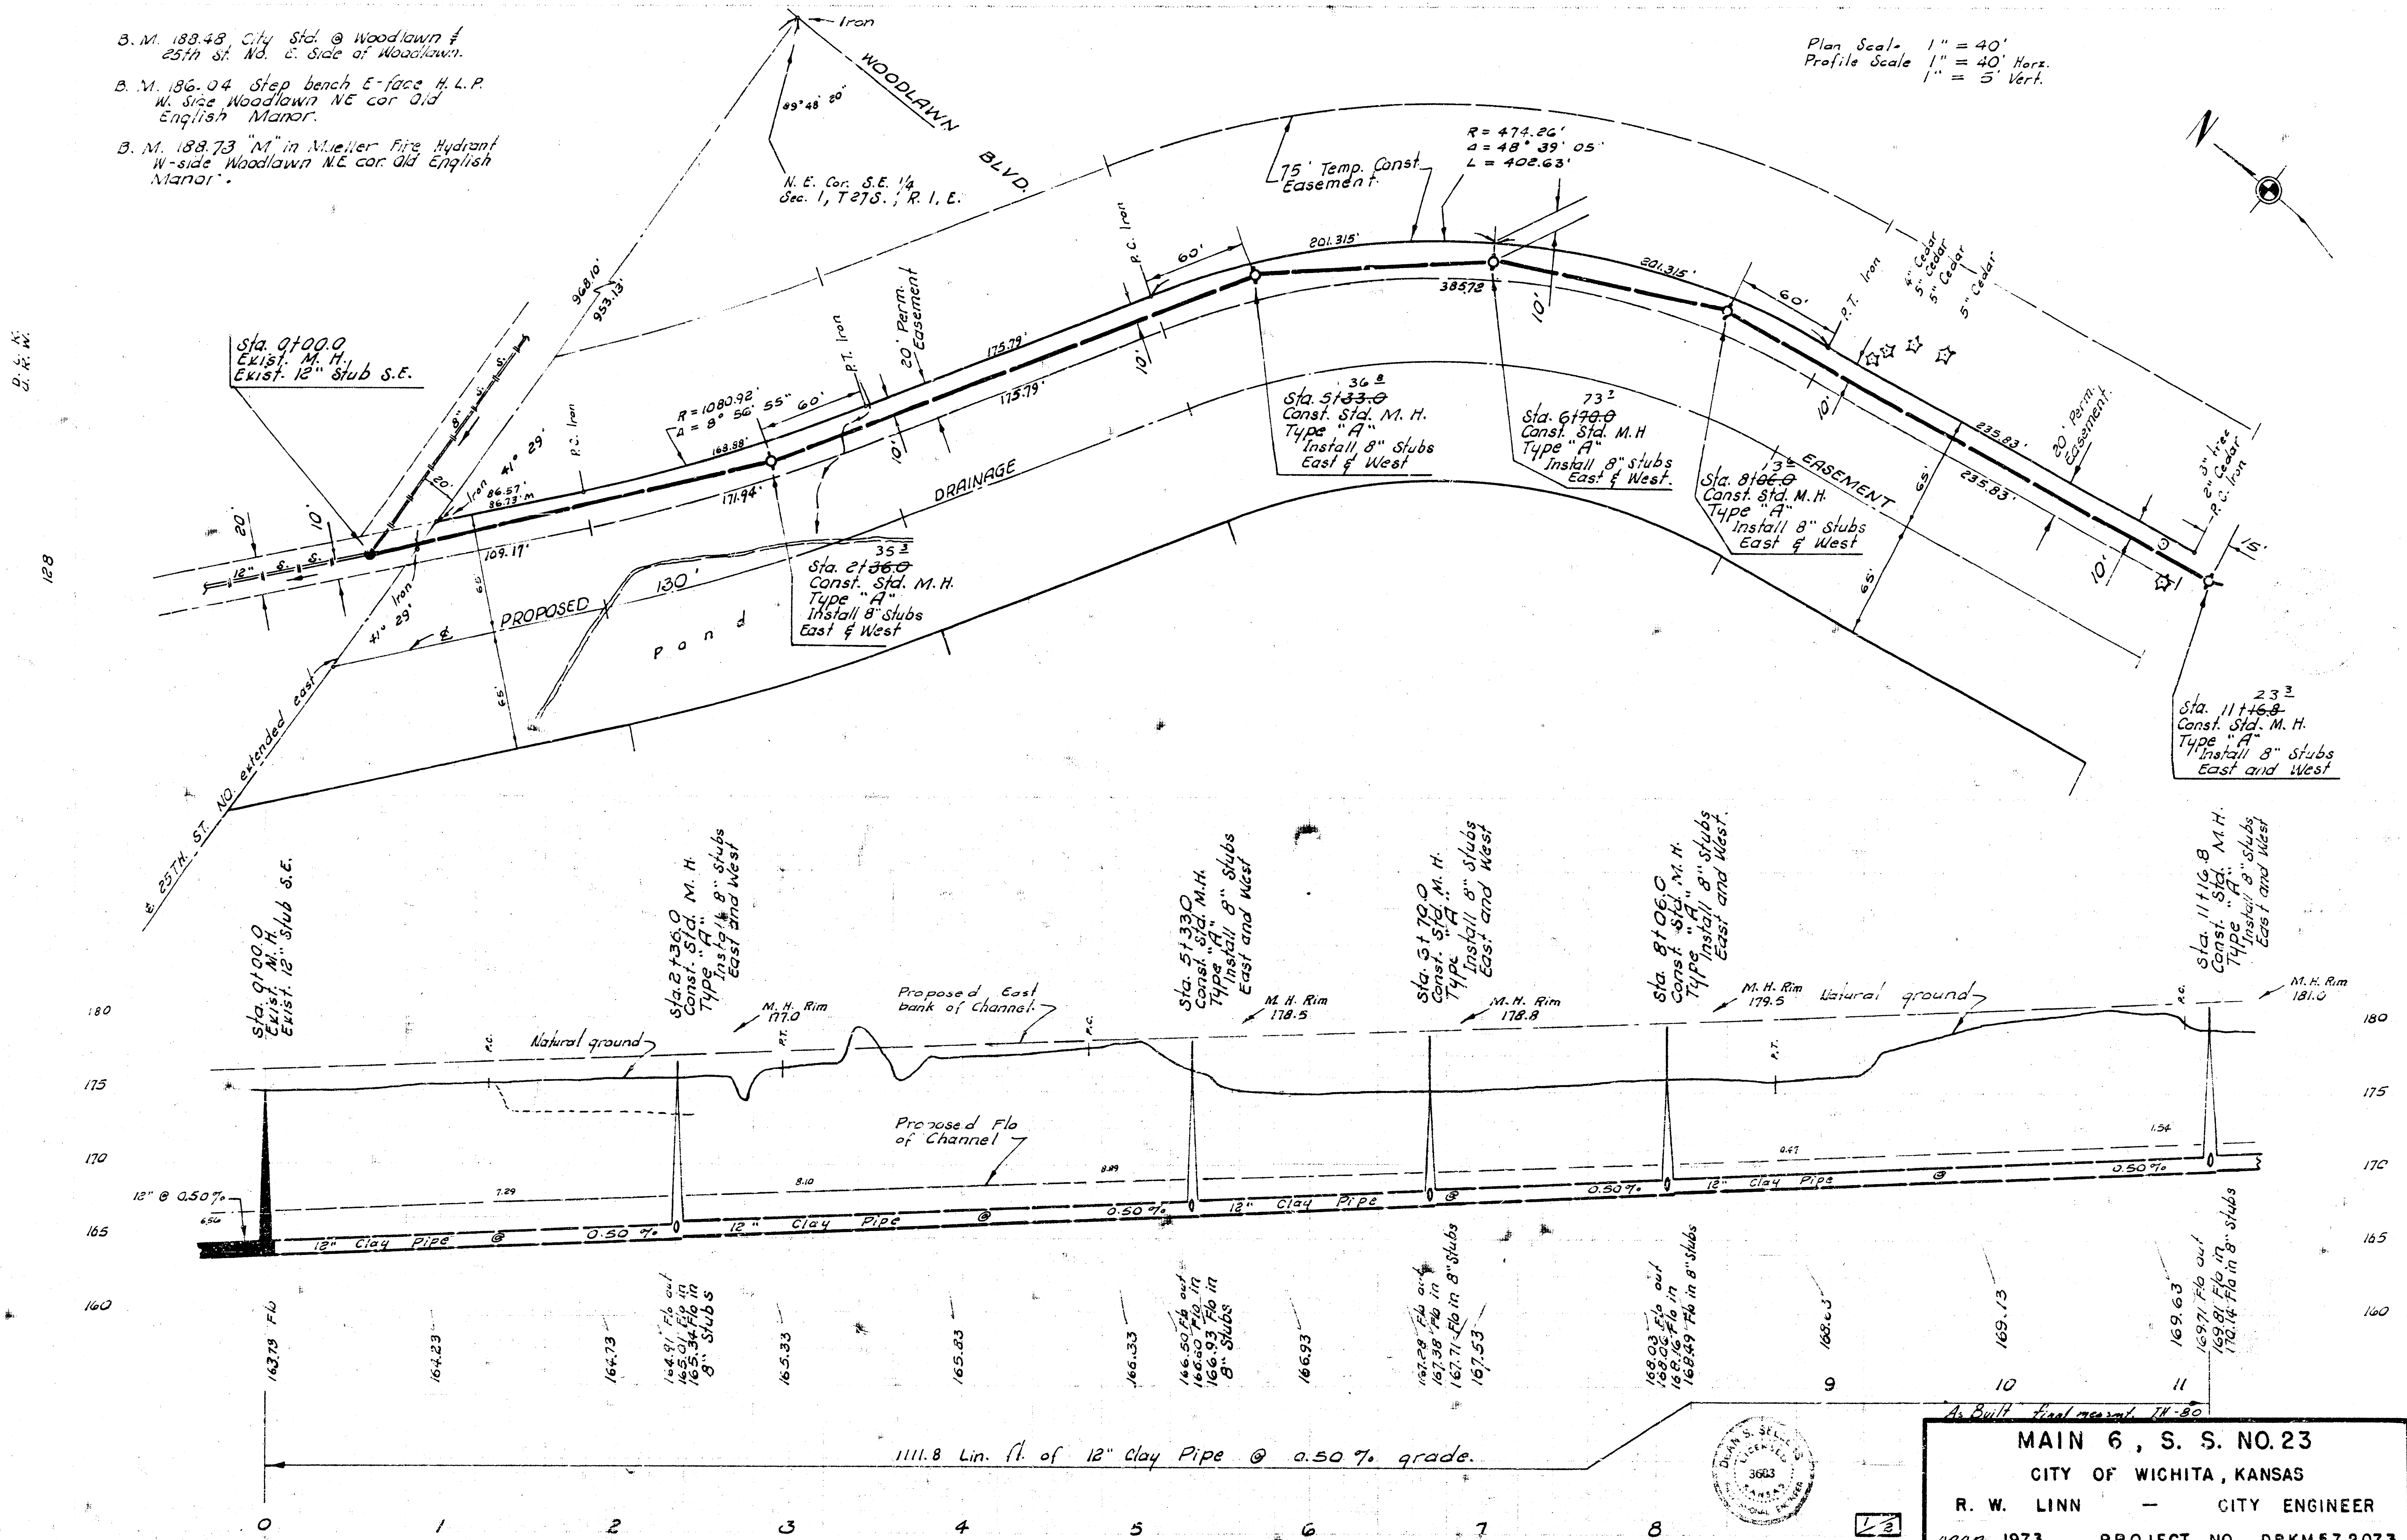

B. M. 186.04 Step bench E-face H. L. P.
W-side Woodlawn N.E. cor. Old English
Manor.

NOTE: Contractor to retain sufficient select backfill material from sewer excavation to be used as trench backfill at wooden sewer. Trench backfill through right of way limits on wooden sewer shall be compacted to 90% standard density between the bottom of the trench and elevation 104.00 and to 95% standard density between elevation 104.00 and 105.50 or the top of the existing ground. This item of work shall not be paid for directly and shall be considered as incidental to the project.

