




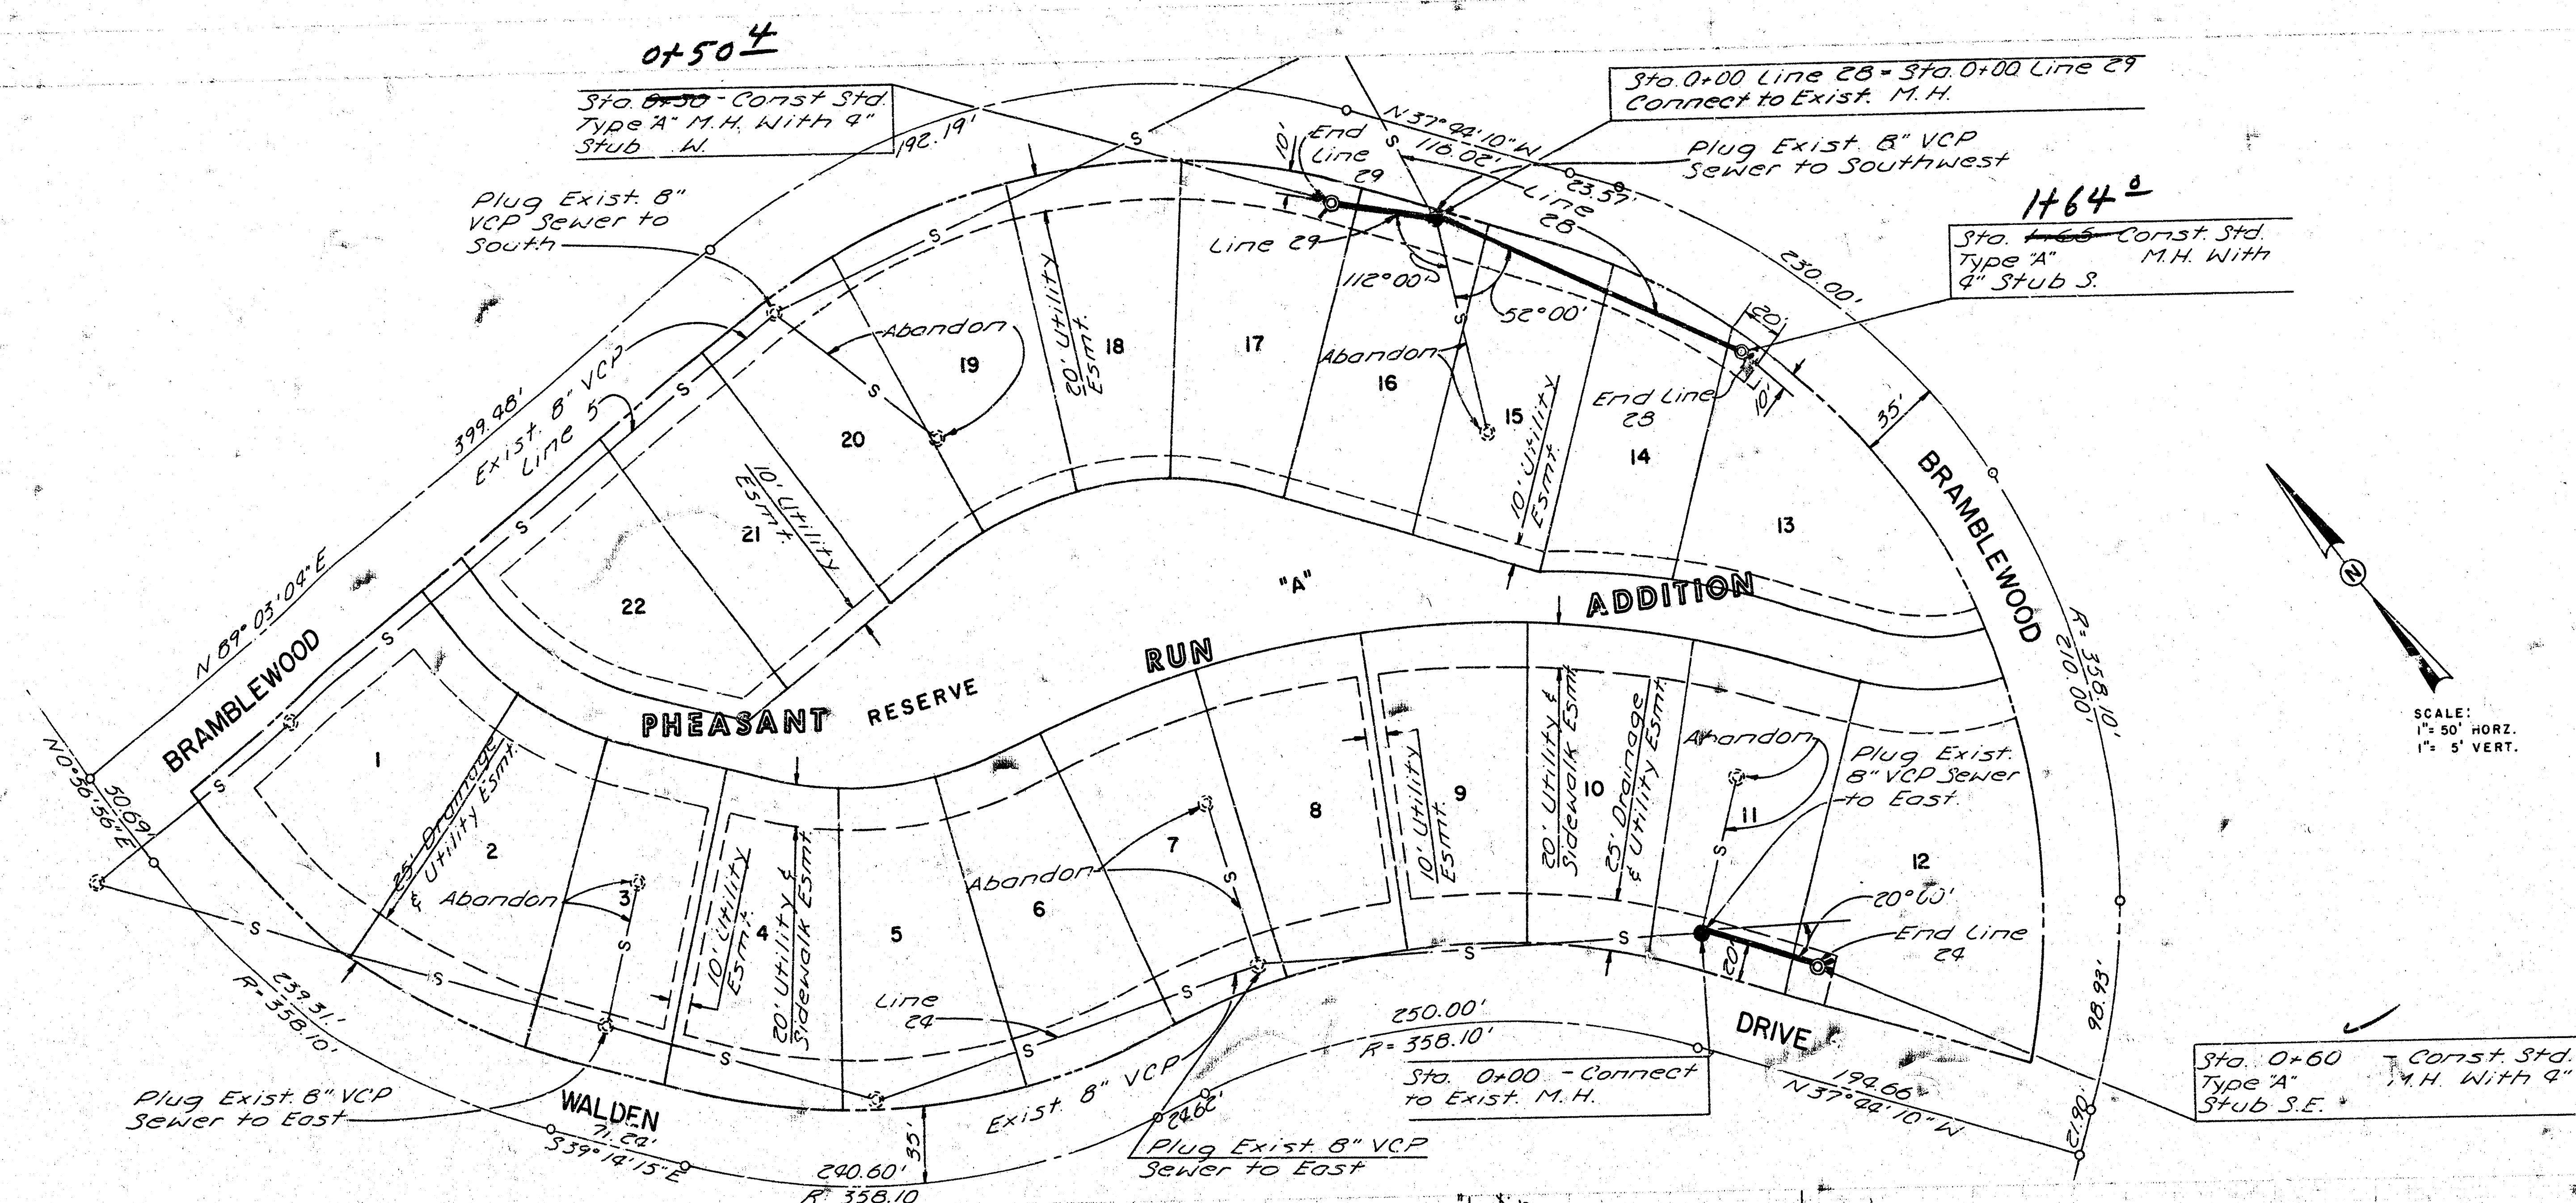

SCALE:
1" = 50' HORIZ.
1" = 5' VERT.

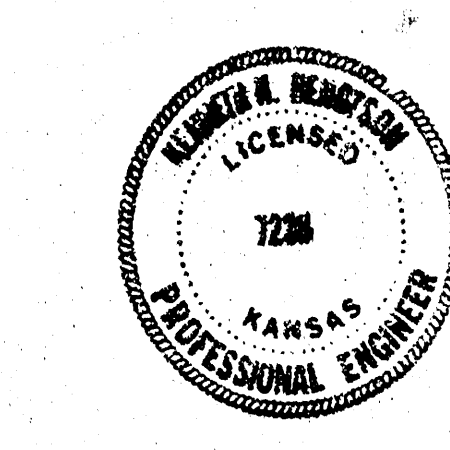

B.M. - R.R. Spike Imbedded in N. Key Wall of Outlet Structure on Comotara Lake. Elev. - 188.00

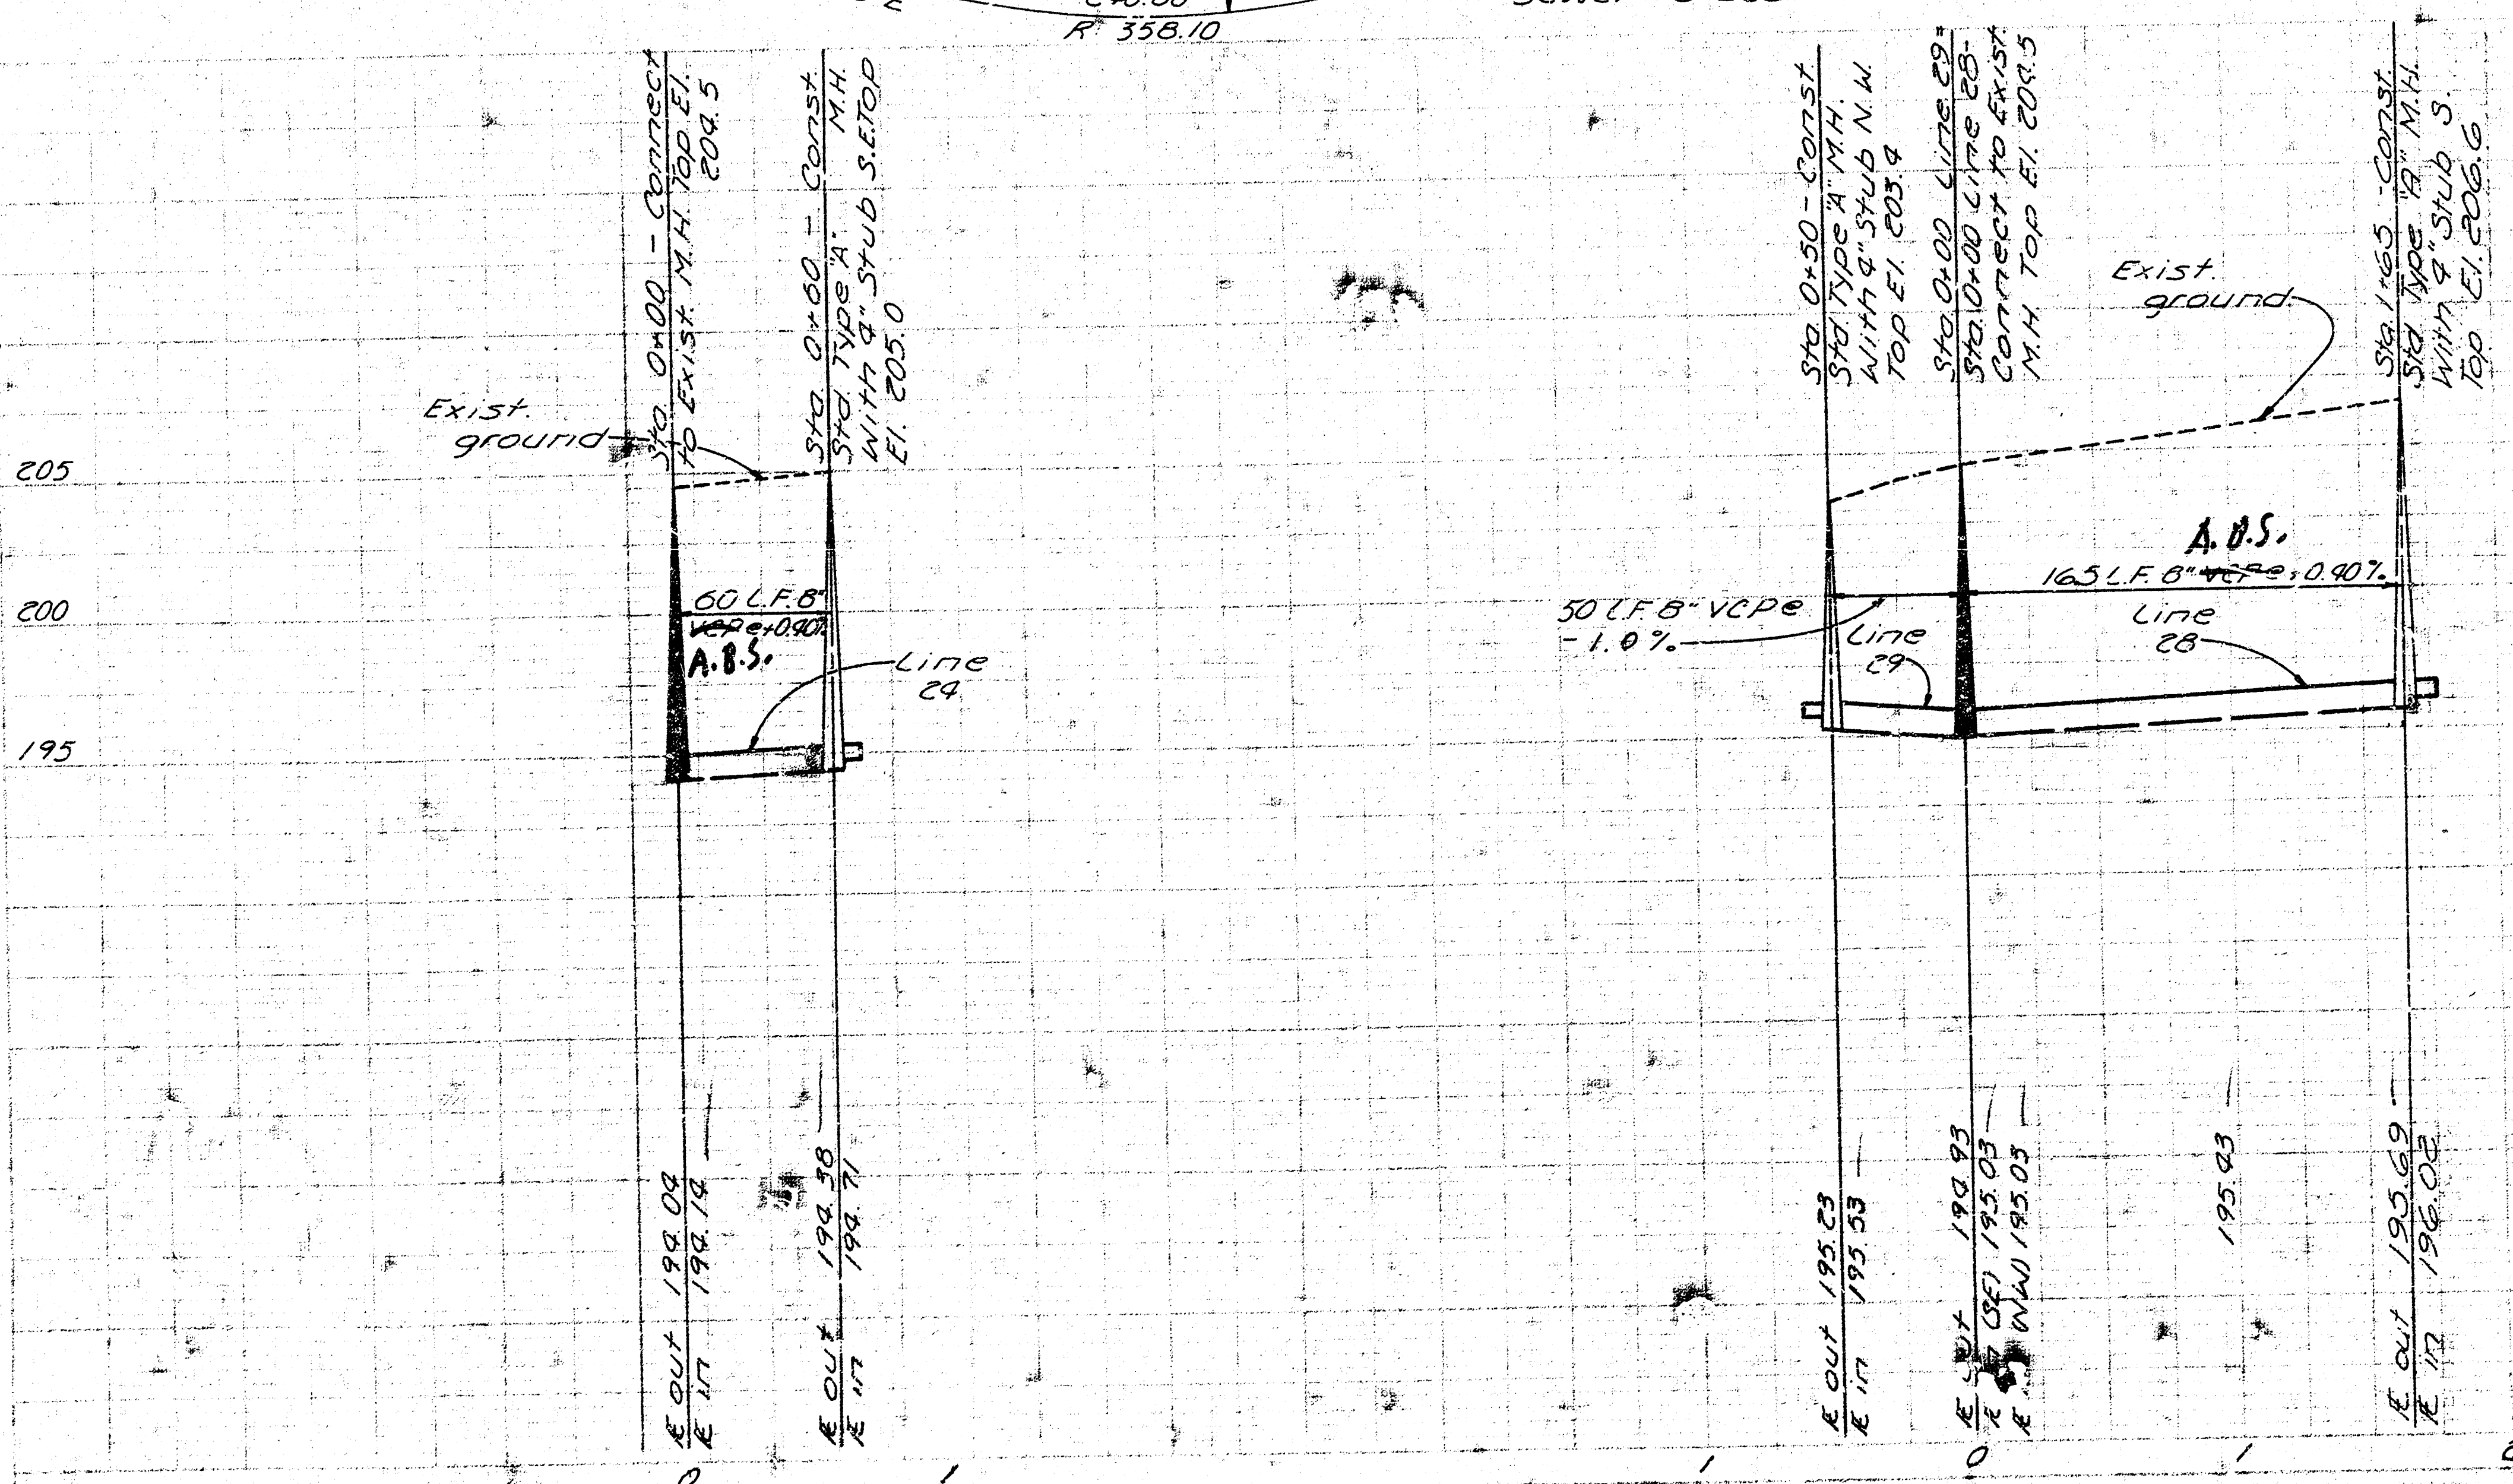

As b. 17 8-15-77
PHEASANT RUN ADDITION
 WICHITA, KANSAS
 LAT. 6 MAIN 6 S.S. NO. 23
 PROJ. NO. DBKL 576001
 SHEET 1 OF 1 LINE NO. 24 & 29