
Lateral 7, Southwest Main

Project No. DBKL 568030

R. W. Linn City Engineer

City of Wichita, Kansas

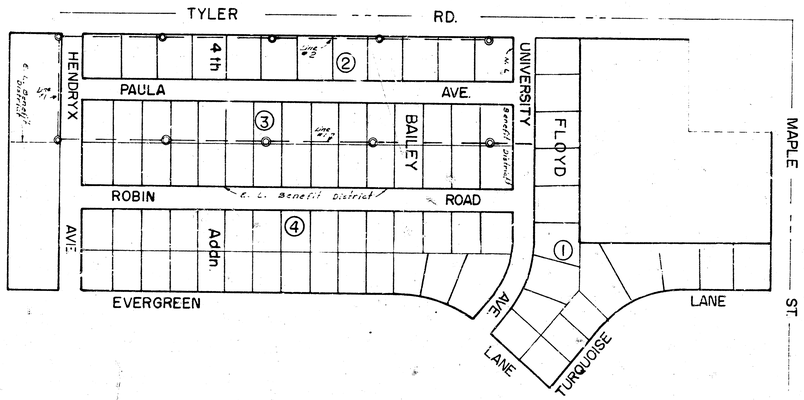

Line No. Sheet No.

1 2 & 3

2 4

B.M. 148.53 Std. 34.2'E. & 27.2'S. & South 15' of E. Maple
B.M. 148.20 R.R. Spk. 5.5' ends E.F. 1.0'W. Cor. Tyler & Bellview
B.M. 141.92 S.E. Cor. Conc. Porch Tyler Rd. Baptist Ch. S.W. Cor. Tyler & Bryan Rd.

PAULA AVE.

FOURTH

ADDN.

ROBIN RD.

PLAN SCALE 1"=40'
PROFILE SCALE 1"=4' V.
1"=40' H.

RD.

FLOYD

AVE.

BAILEY

PAULA

ROBIN

HENDRYX AVE.

TYLER

UNPLATTED

297.2'

Install 8" Stub east
Flo in 128.88

LINE # 1


288.2 L.F. 8" C.P. @ 2.250%

911.8 L.F. 8" C.P. @ 1.20 %

150
140
130

0 1 2 3 4 5 6 7 8 9 10


LAT. 7, SOUTHWEST MAIN
CITY OF WICHITA, KANSAS
R.W. LINN CITY ENGINEER
DATE SEPT. 1972
PR. NO DBAL 568030

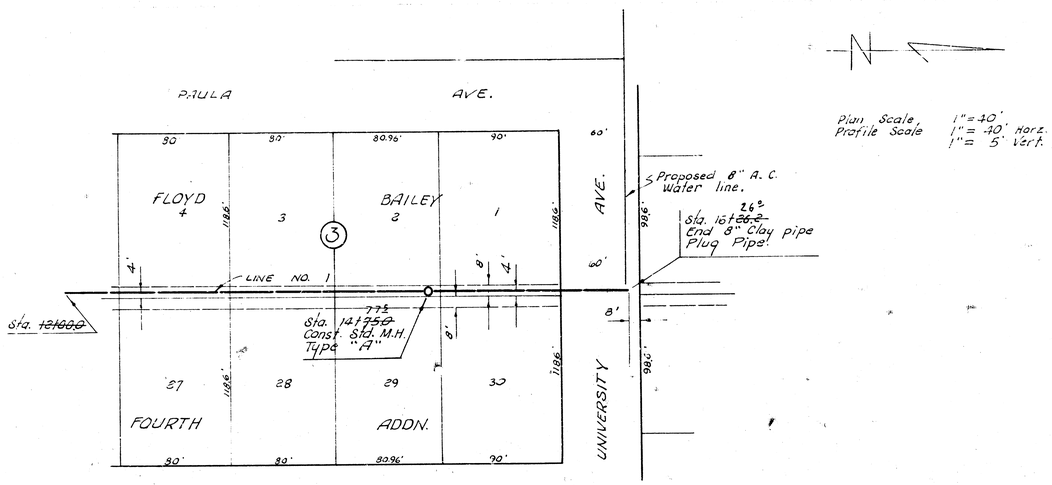


Plan Scale 1" = 40'
Profile Scale 1" = 40' Horz.
1" = 5' Vert.

3/4

LAT. 7, S. W. MAIN
PROJECT NO. D B K L 5680 30

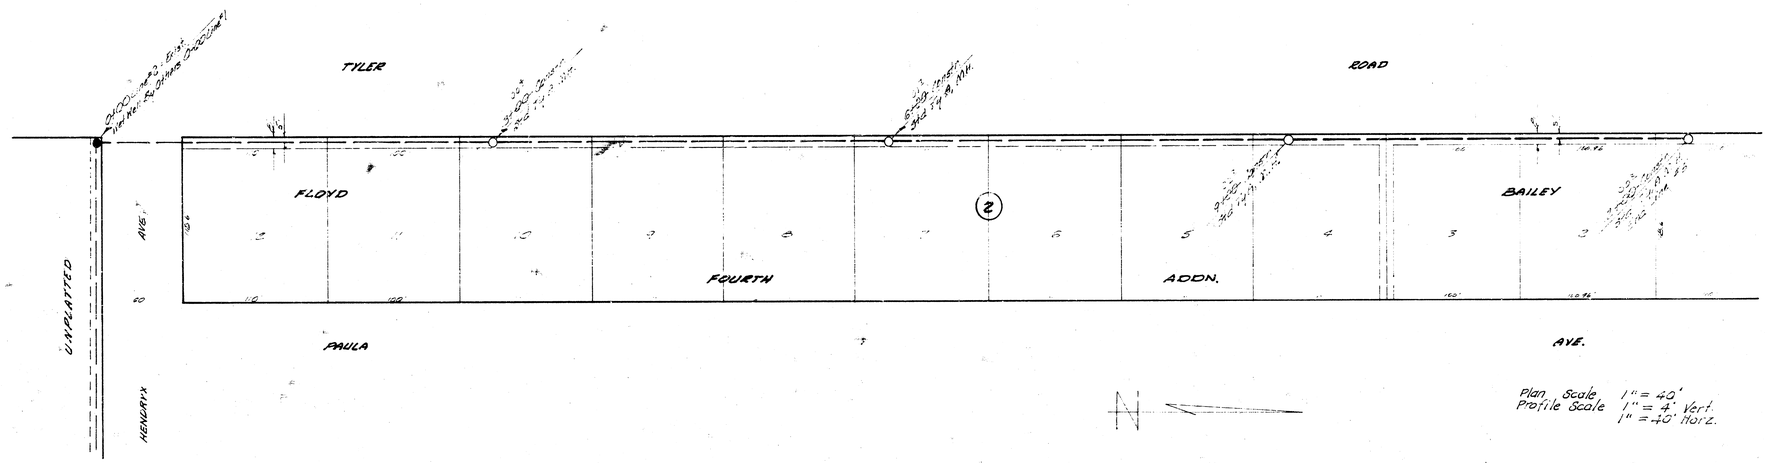

Plan Scale 1" = 40'
Profile Scale 1" = 4' Vert.
1" = 40' Horz.

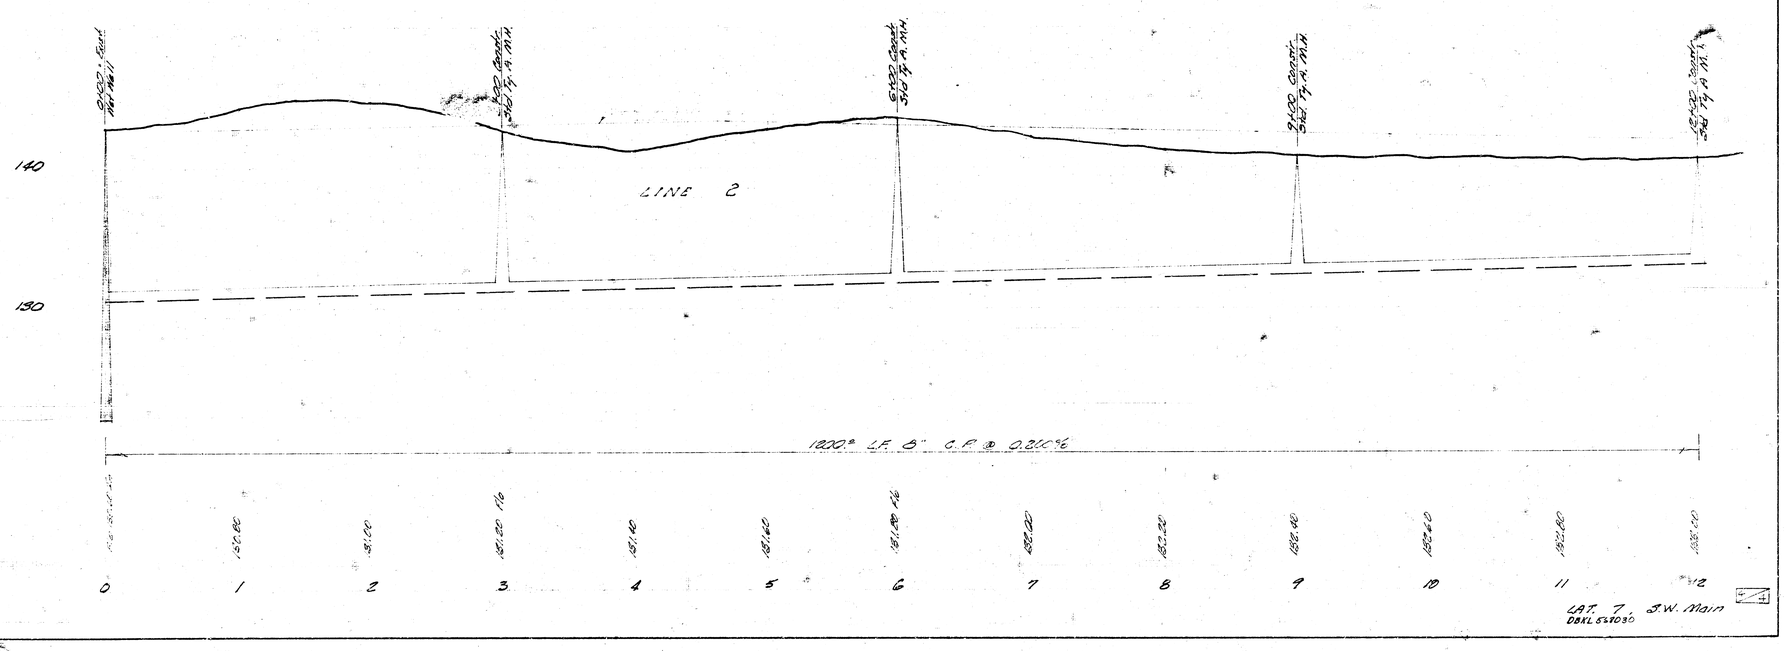

LAT. 7 - S.W. Main