ALLENS FARM PHASE 3
SANITARY SEWER PLANS
PROJ. NO. 468-76-245-8000I-000-000003

29TH. STREET NORTH

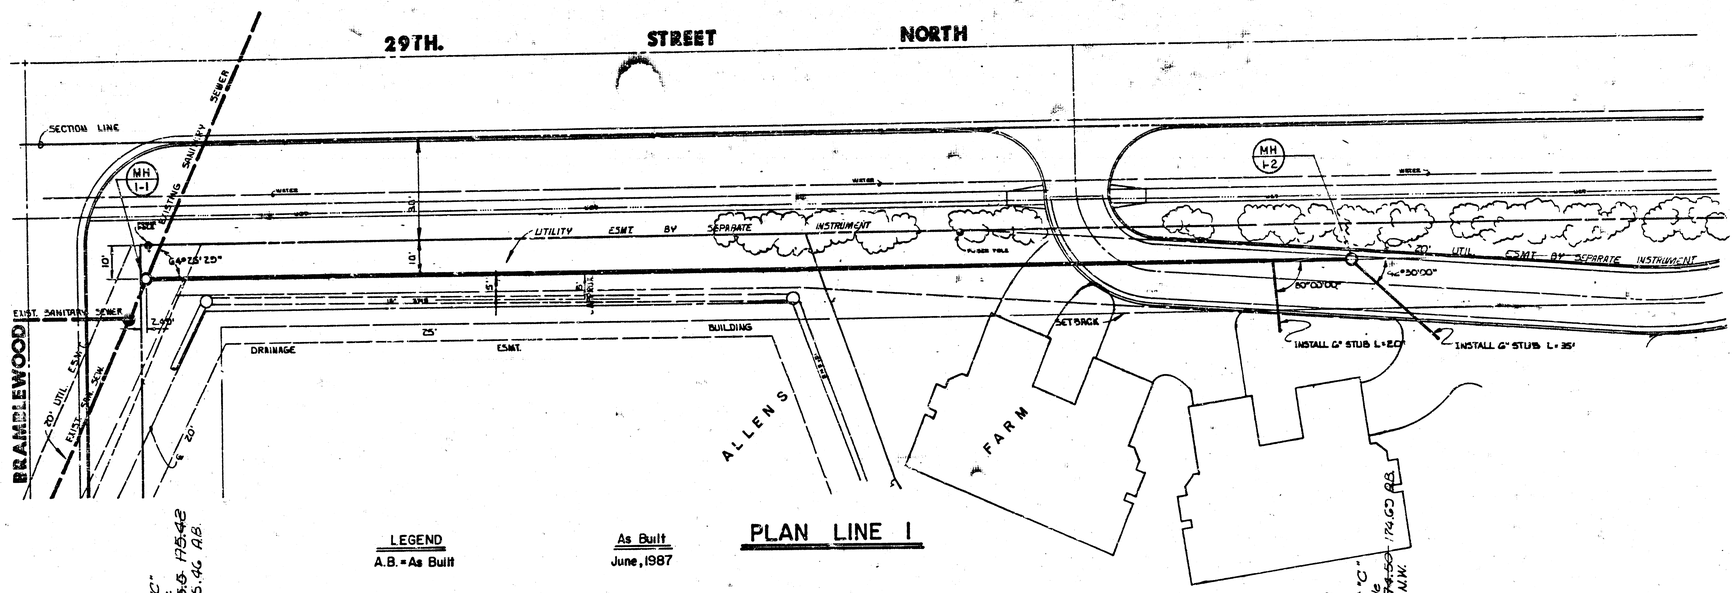

N

Scale: 1"= 20' Horiz.
1"= 5' Vert.

LEGEND
A.B. = As Built

As Built
June, 1987

PLAN LINE 1

REVISED 10-13-86 - AS BUILT
REVISED 5-5-86

PROFILE LINE 1

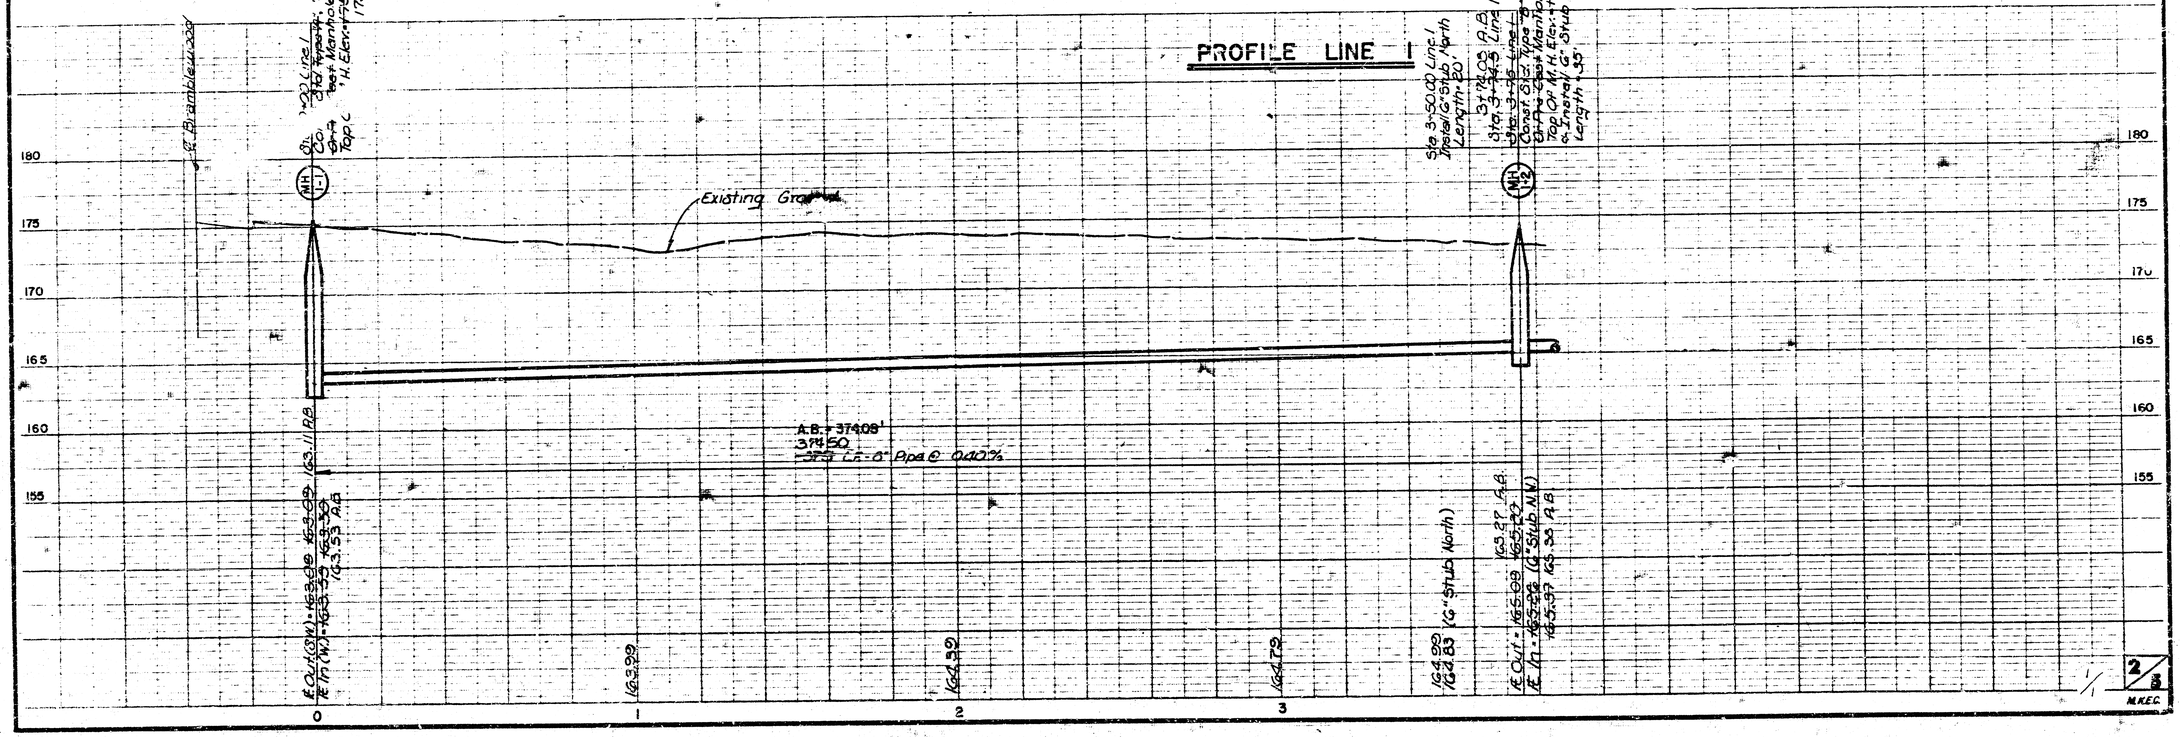

FILMED FROM THE BEST AVAILABLE COPY