ALLENS FARM PHASE 3
SANITARY SEWER PLANS 026
PROJ. NO. 468-76-245-800GI-000-000-~~003~~

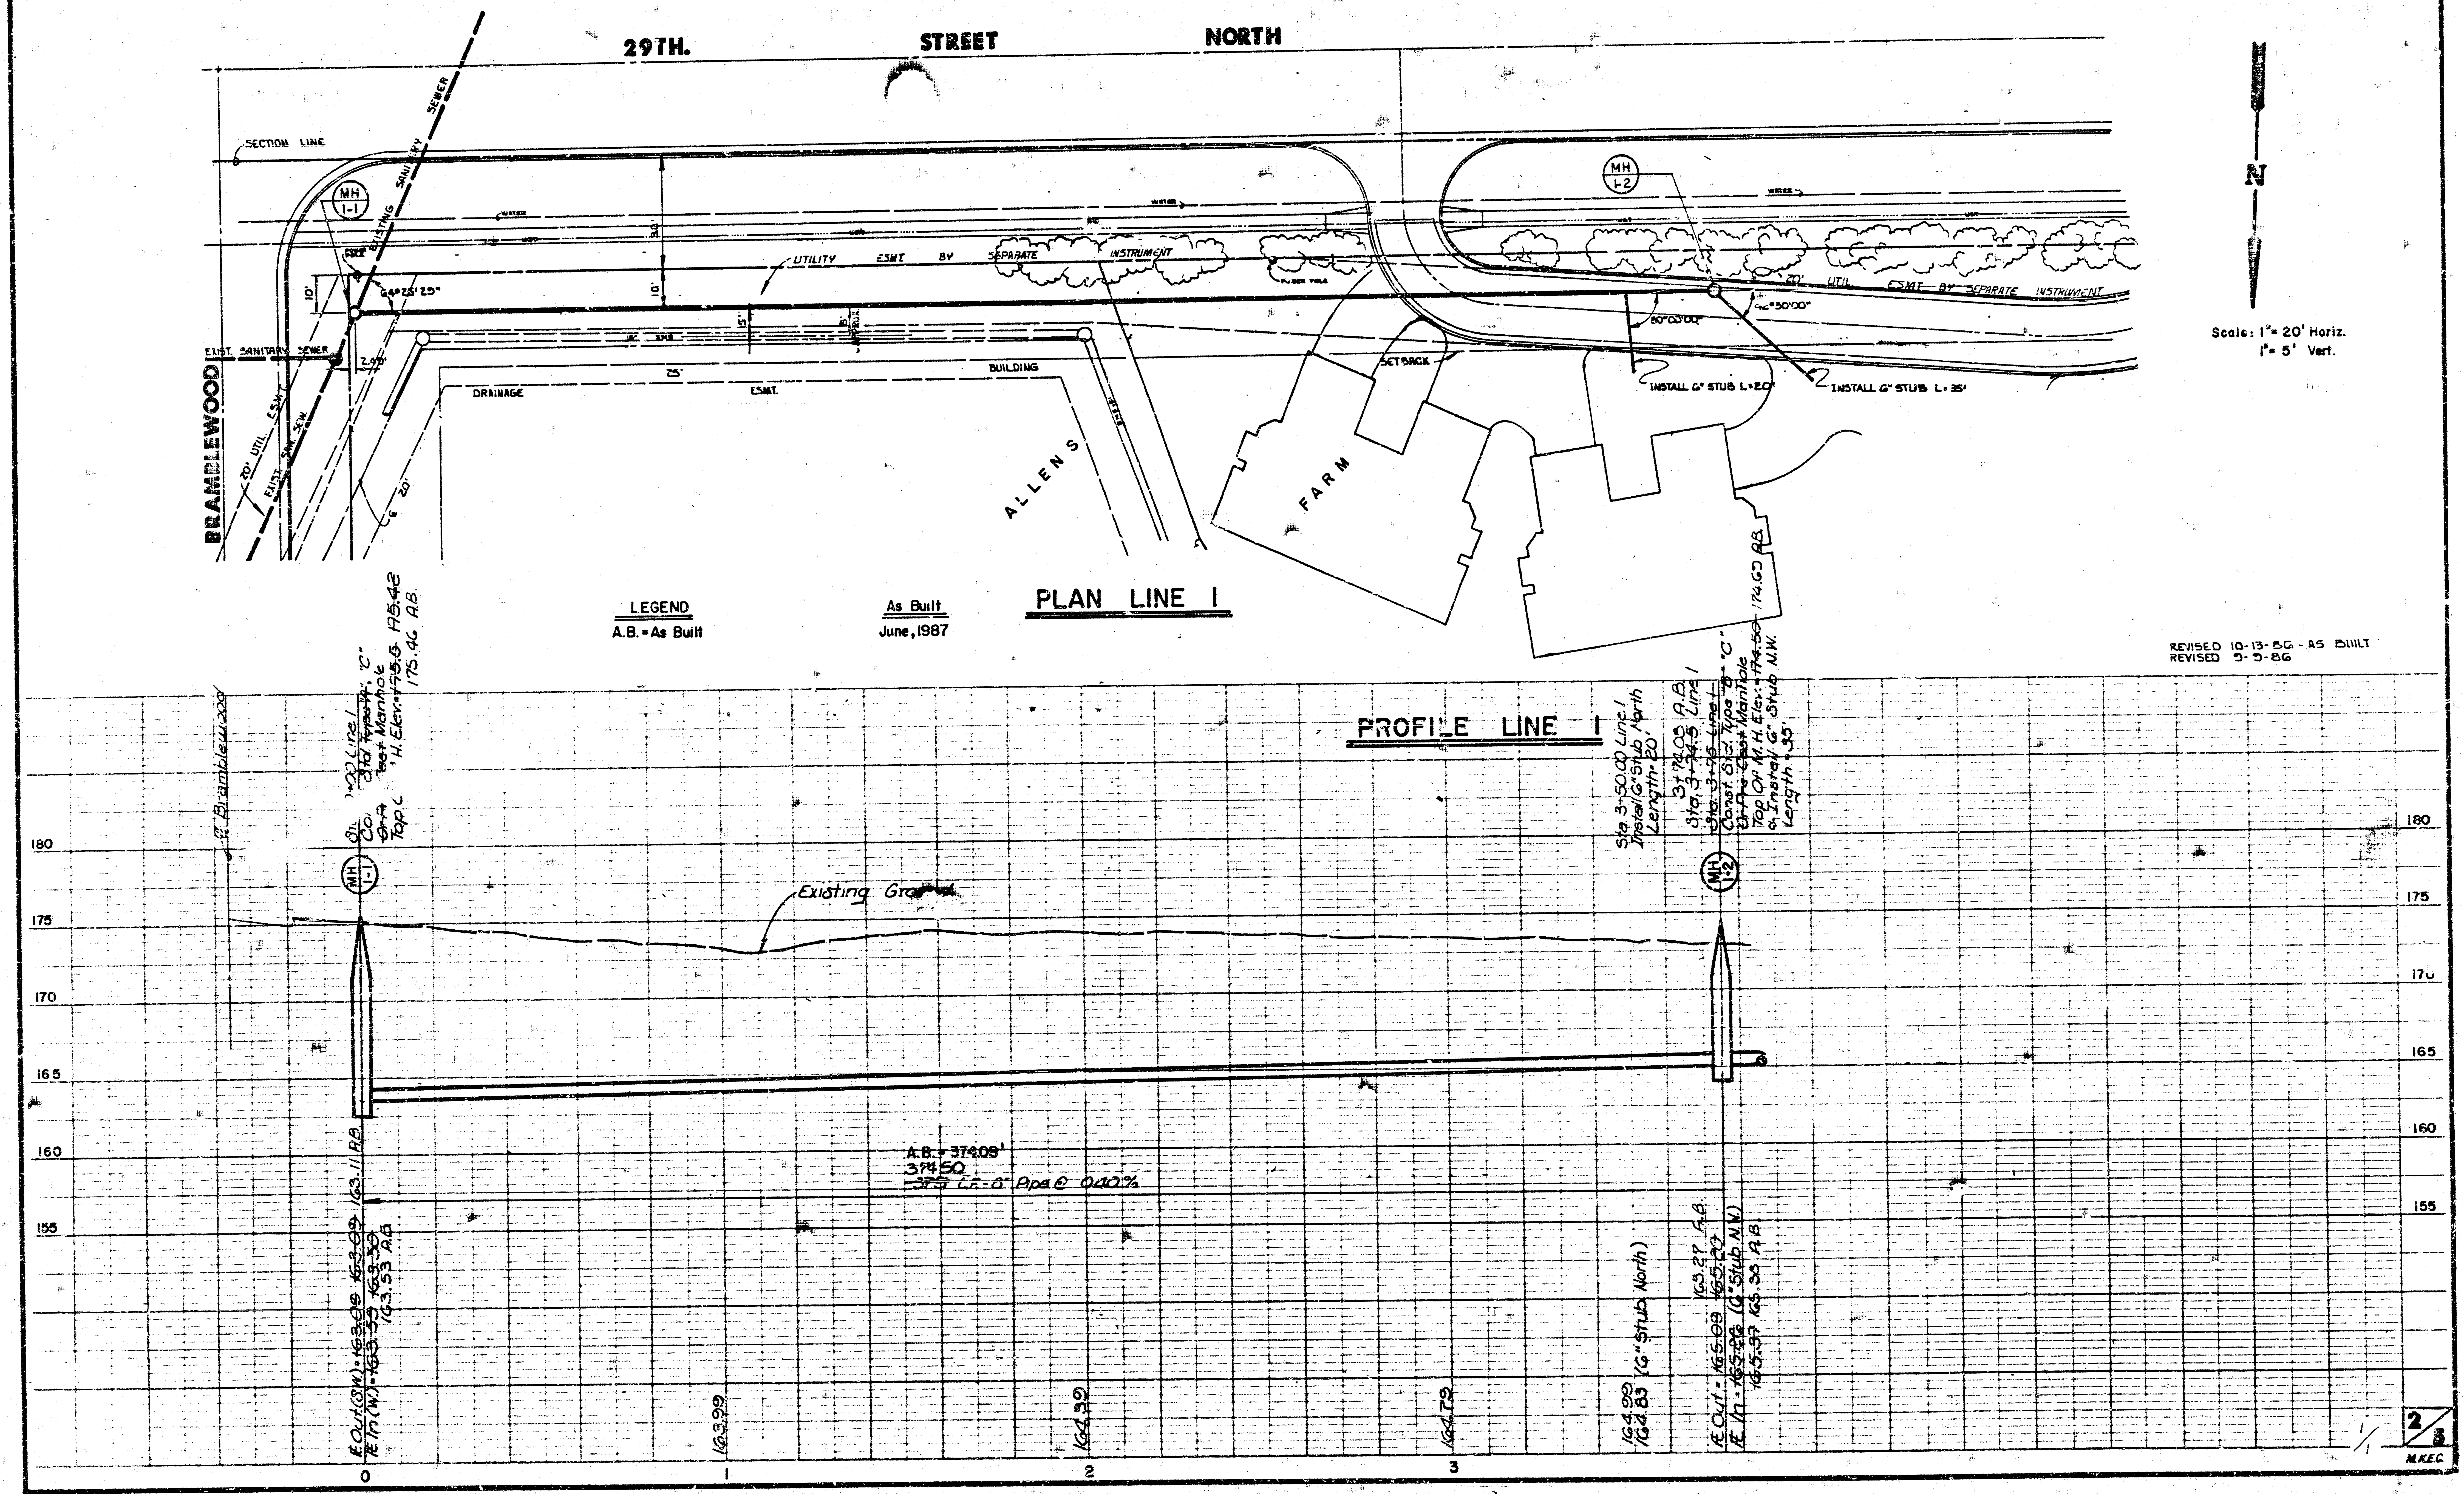
29TH. STREET NORTH
SECTION LINE
MH 1-1
MH 1-2
EXISTING SANITARY SEWER
WATER
UTILITY ESMT BY SEPARATE INSTRUMENT
20' UTIL ESMT BY SEPARATE INSTRUMENT
EXIST. SANITARY SEWER
BRAMBLEWOOD
20' UTIL. ESMT
EXIST. SAN. SEW.
DRAINAGE 25' ESMT.
BUILDING SETBACK
ALLENS FARM
INSTALL 6" STUB L=20'
INSTALL 6" STUB L=35'
N
Scale: 1" = 20' Horiz.
1" = 5' Vert.
LEGEND
A.B. = As Built
As Built
June, 1987
PLAN LINE I
REVISED 10-13-86 - AS BUILT
REVISED 9-5-86
PROFILE LINE I
℄ Bramblewood
Sta. 0+00 Line 1
Const. Std. ~~Type "A"~~ "C"
~~Drop~~ Cast Manhole
Top of M.H. Elev. = ~~175.6~~ ~~175.42~~ 175.46 A.B.
Existing Ground
Sta. 3+50.00 Line 1
Install 6" Stub North
Length = 20'
3+74.08 A.B.
Sta. 3+~~74.5~~ Line 1
~~Sta. 3+75 Line 1~~
Const. Std. Type ~~"B"~~ "C"
~~Drop~~ Cast Manhole
Top of M.H. Elev. = ~~174.50~~ 174.60 A.B.
& Install 6" Stub N.W.
Length = 35'
A.B. = 374.08'
~~374.50~~
~~375~~ L.F. - 8" Pipe @ 0.40%
℄ Out. (S.W.) = ~~163.09~~ ~~163.09~~ 163.11 A.B.
℄ In (W.) = ~~163.33~~ ~~163.59~~ 163.53 A.B.
163.99
164.39
164.79
164.99
164.83 (6" Stub North)
℄ Out = ~~165.09~~ ~~165.27~~ 165.27 A.B.
℄ In = ~~165.26~~ (6" Stub N.W.)
165.37 165.38 A.B.
0
1
2
3
155
160
165
170
175
180
2/3
M.K.E.C.

FILMED FROM THE BEST
AVAILABLE COPY