PLAN

PROFILE

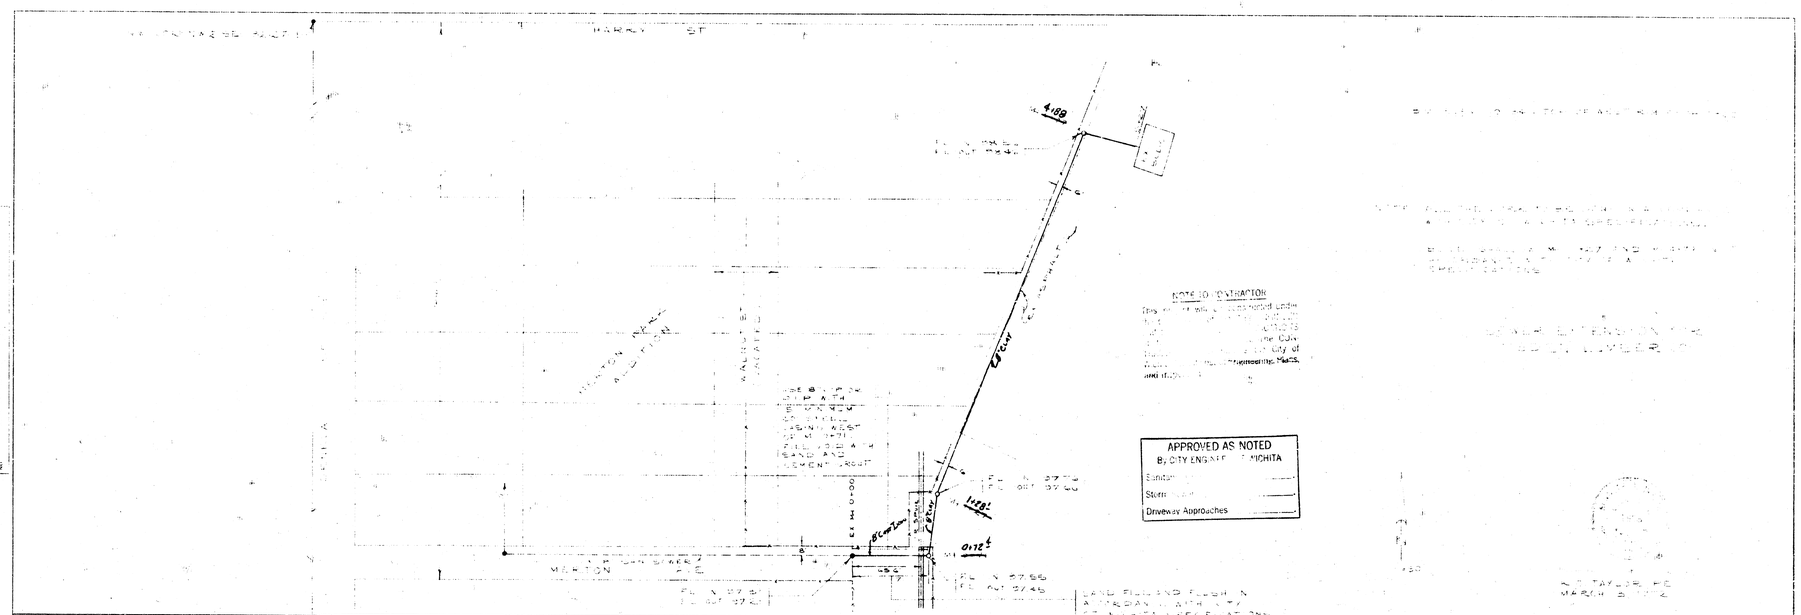


