




APPROVED AS NOTED
By CITY ENGINEER OF WICHITA
Sanitary Sewers D.E.S.
Storm Sewers _____
Driveway Approaches _____

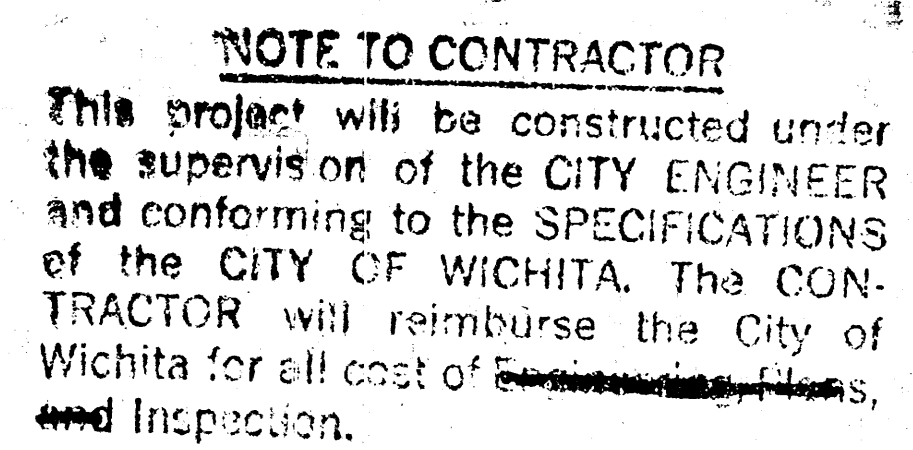