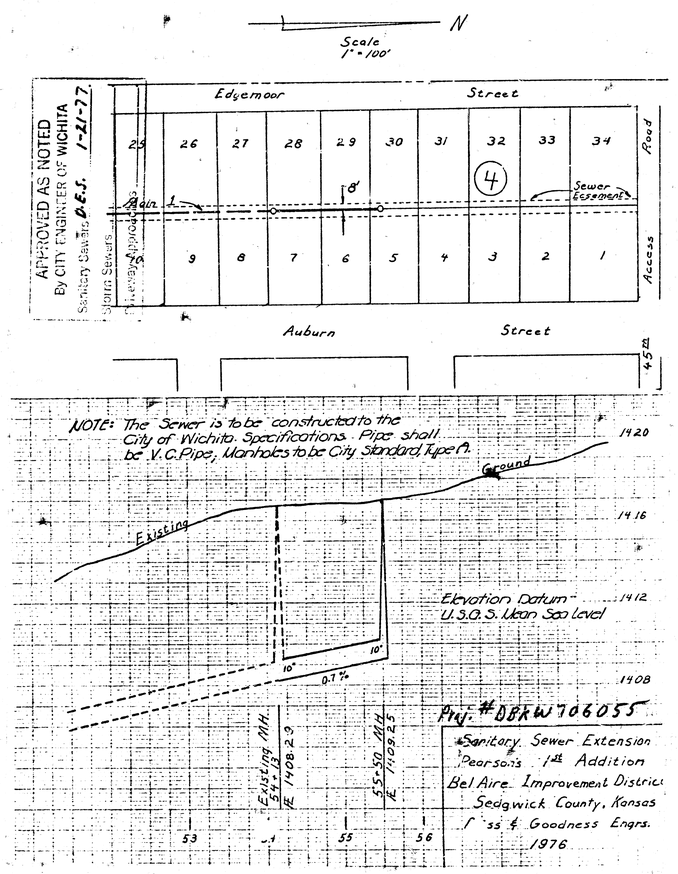


Project # DBKW 706055

Sanitary Sewer Extension
Pearson 1st Addition
Bell Aire Improvement District
Sedgwick County Kansas
Reiss & Goodness Engrs