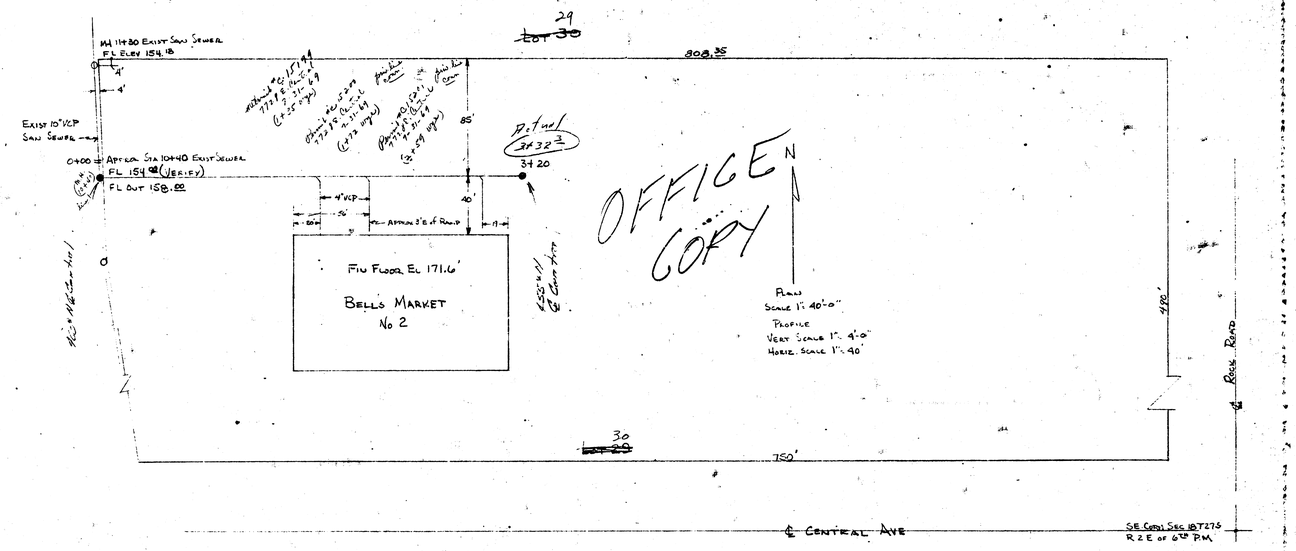
29
~~Lot 30~~
MH 11+30 Exist San Sewer
FL Elev 154.18
4'
4'
Exist 10" VCP
San Sewer
0+00 ± Approx Sta 10+40 Exist Sewer
FL 154.98 (Verify)
FL Out 150.00
808.35
85'
Defined
34 32
34 20
40'
4" VCP
50'
Approx 3' E of Road
Fin Floor El 171.6'
Bell's Market
No 2
OFFICE COPY
N
Plan
Scale 1" = 40'-0"
Profile
Vert Scale 1" = 4'-0"
Horiz. Scale 1" = 40'
178'
Rock Road
30
~~Lot 29~~
750'
℄ Central Ave
SE Corn Sec 18 T27S
R2E of 6th PM

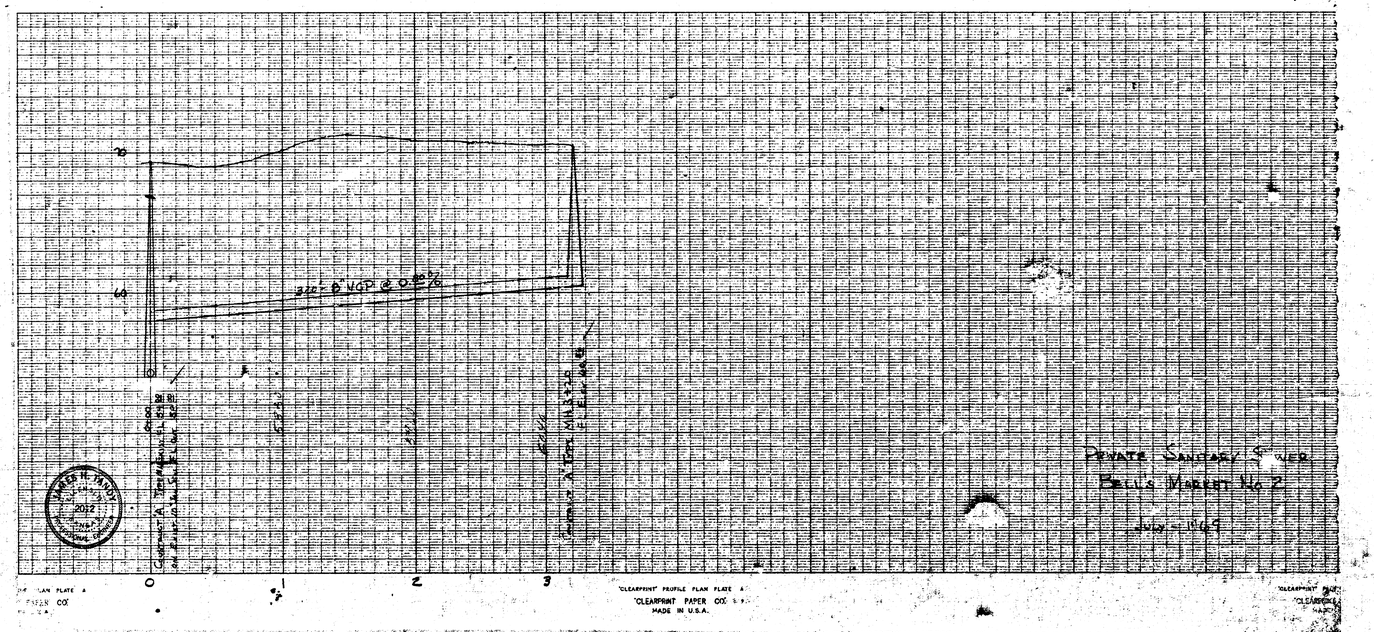
320' 8" VCP @ 0.0032
Connect to Exist MH 3+25
Elev 148.18
Connect to Exist MH 0+00
Elev 150.00
Invert Elev 148.00
Private Sanitary Sewer
Bell's Market No 2
July - 1969
0
1
2
3
'CLEARPRINT' PROFILE PLAN PLATE A
'CLEARPRINT' PAPER CO.
MADE IN U.S.A.