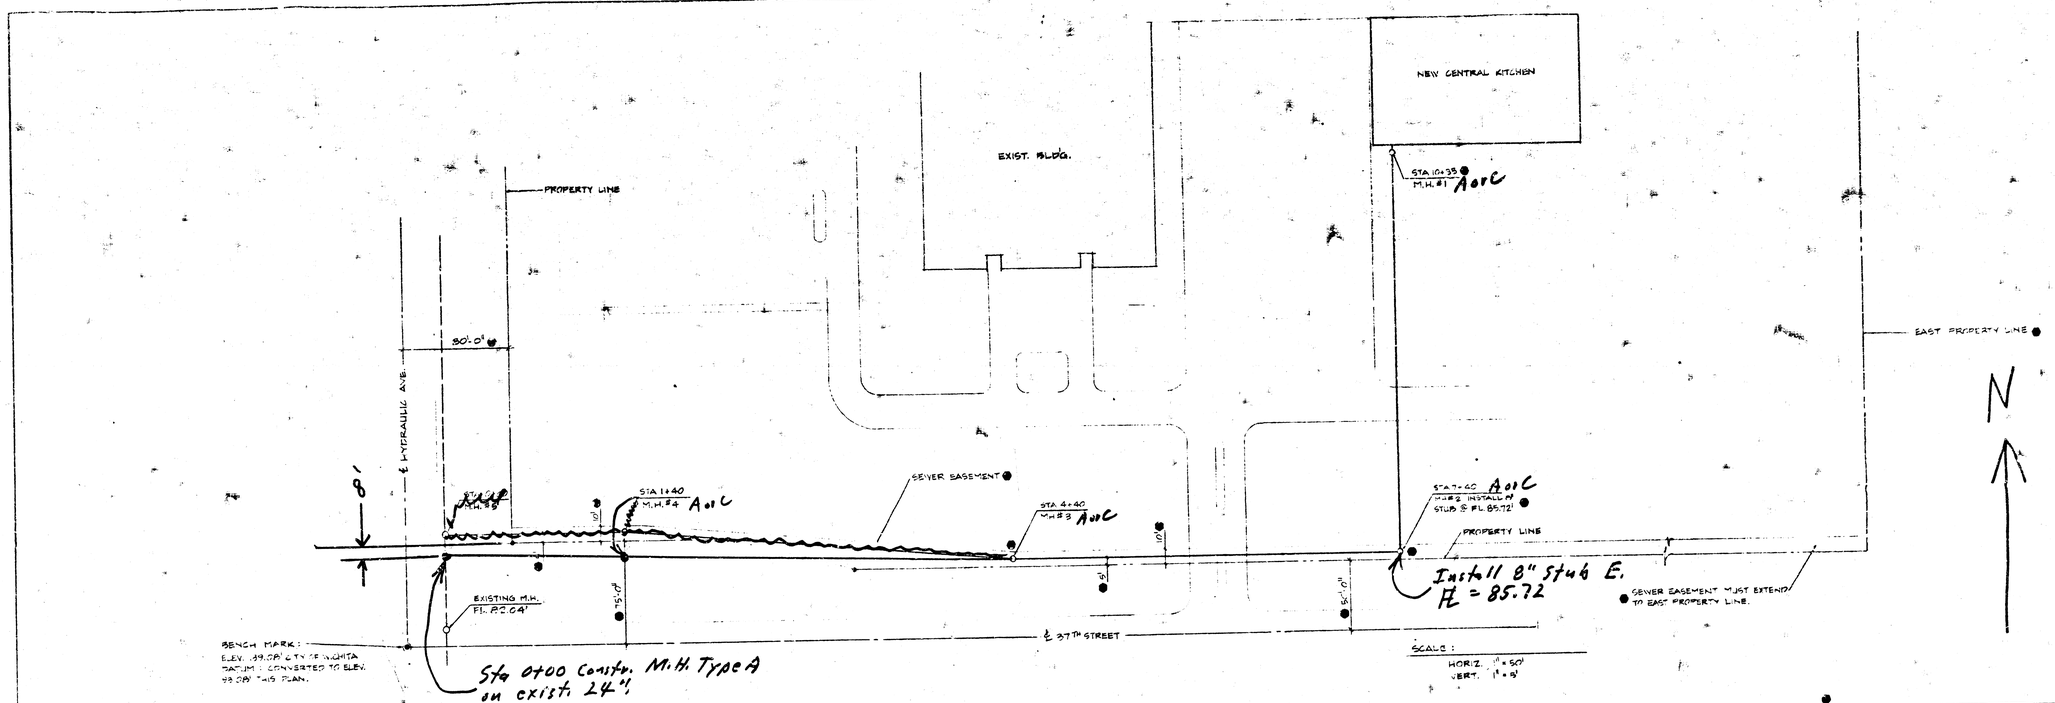

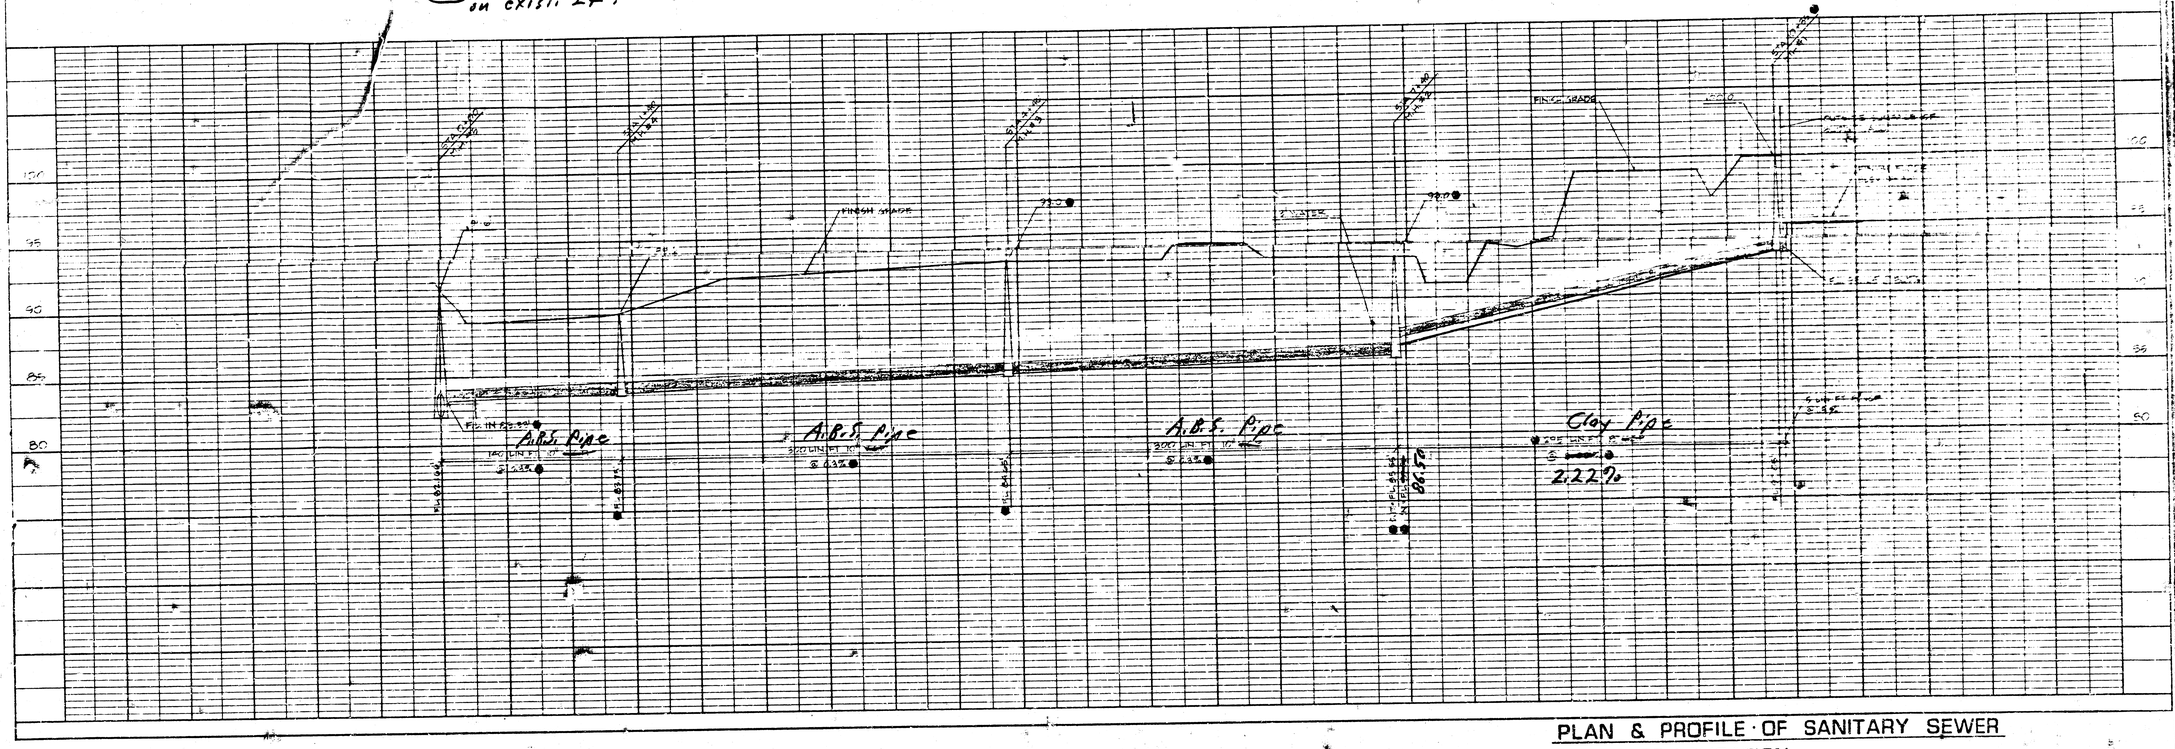
FINISH GRADE
A.B.S. Pipe
300 LIN FT 10"
@ 0.33%
A.B.S. Pipe
300 LIN FT 10"
@ 0.33%
Clay Pipe
205 LIN FT 8"
@ 2.22%
