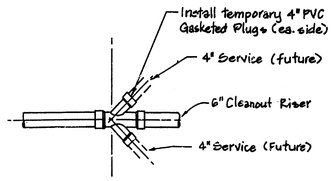

PLAN

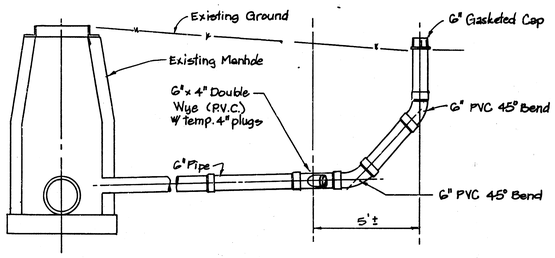

ELEVATION

CLEANOUT RISER ASSEMBLY DETAIL

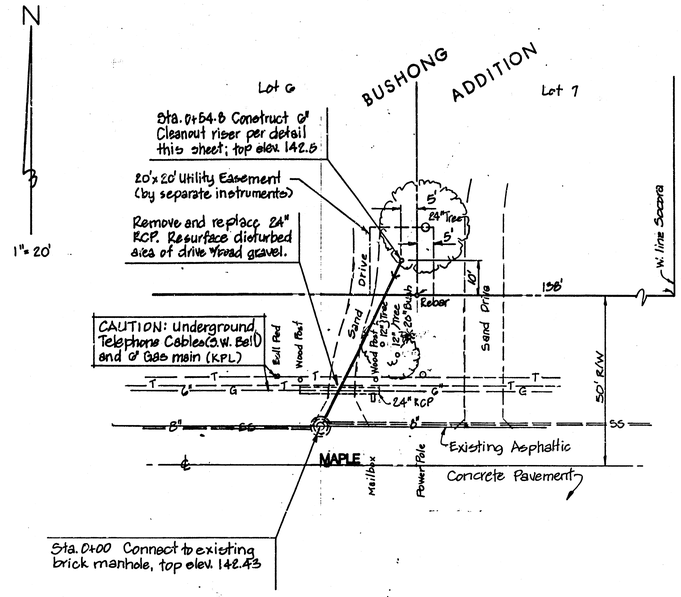

LOCATION MAP

GENERAL NOTES

1. Contractor will be required to provide a minimum advance notice of twenty-four (24) hours to utility companies prior to starting any excavation as follows:

Kansas One-Call	1-800-344-7233

The Contractor must notify the following in case of an emergency:

Cablevision	262-4270 or 263-2061
K.P.& L. Gas Service Company	263-7511
Kansas Gas & Electric	264-1141
Arkla Gas Company	942-8350 or 263-8161
Southwest Bell Telephone Company	1-571-2611
City of Wichita Water Department	268-4908
City of Wichita Sewer Maintenance	268-4071

2. The Contractor shall give all property owners and/or tenants of developed property directly abutting the construction of this project a minimum of ten (10) days advance notice prior to start of construction.

3. The Contractor shall be responsible for preserving property irons. The Contractor will be required to re-establish any property irons which are damaged or destroyed by his construction operations. Such irons shall be re-established by a licensed land surveyor in accordance with state law.

4. Traffic will not be affected by construction on this project.

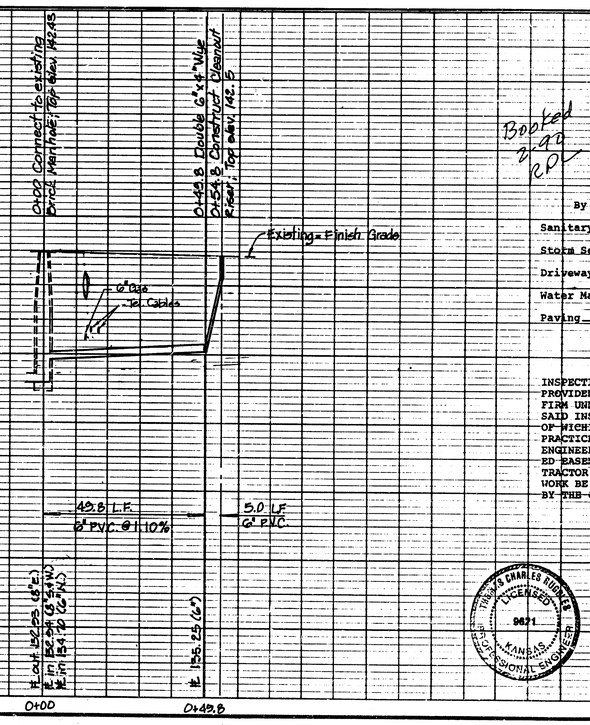

PROFILE SCALE
1" = 20' H.
1" = 5' V.

Booked 2-92 RP

APPROVED AS NOTED
By CITY ENGINEER OF WICHITA
Sanitary Sewers VRH 11/7/89
Storm Sewers
Driveway Approaches
Water Mains
Paving

NOTE TO CONTRACTOR

INSPECTION AND TESTING FOR THIS PROJECT IS TO BE PROVIDED BY A LICENSED CONSULTING ENGINEERING FIRM UNDER CONTRACT WITH THE OWNER/DEVELOPER. SAID INSPECTION TO BE IN ACCORDANCE WITH THE CITY OF WICHITA STANDARD CONSTRUCTION ENGINEERING PRACTICES AND CERTIFIED BY A LICENSED PROFESSIONAL ENGINEER. NO WORK SHALL BE PERFORMED IN DEDICATED EASEMENTS OR PUBLIC RIGHT-OF-WAY BY THE CONTRACTOR WITHOUT SUCH INSPECTION NOR SHALL ANY WORK BE COMMENCED WITHOUT WRITTEN AUTHORIZATION BY THE CITY ENGINEER.

As built - no revisions 11-22-89

THOMAS CHARLES AUGHTRY LICENSED 9621 KANSAS PROFESSIONAL ENGINEER

Title
PRIVATE SANITARY SEWER EXTENSION TO SERVE LOTS 6 & 7, BUSHONG ADD. 229PPS (607861)

BAUGHMAN COMPANY, P.A.
SURVEYING & ENGINEERING
316/262-7271 • 315 ELLIS • WICHITA, KANSAS 67211

Design:	Drawn:	Approved:	Date:	Scale:	Sheet
TCR	TCR		10-26-89	1" = 20'	1 of 1

89-08-8963

PLAN — NOTE BOOK No. — SURVEYED — PLOTTED — AUTOMATIC CHECKED — R. W. N. NOTED — ST. PLAN CHECKED — DATE — BY

PROFILE — NOTE BOOK No. 59 — SURVEYED — PLOTTED — AUTOMATIC CHECKED — R. W. N. NOTED — STRUCTURE INSTALLATIONS CHECKED — DATE — BY

1/2

FILMED FROM THE BEST AVAILABLE COPY

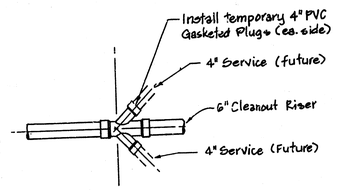

PLAN

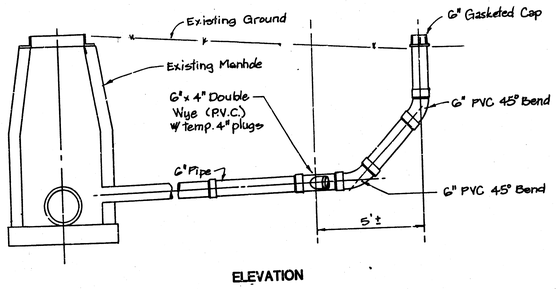

ELEVATION

CLEANOUT RISER ASSEMBLY DETAIL

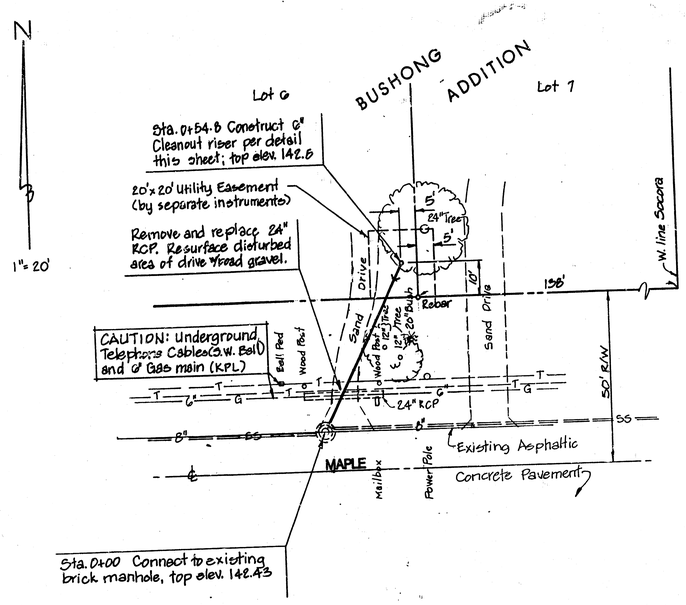

LOCATION MAP

GENERAL NOTES

1. Contractor will be required to provide a minimum advance notice of twenty-four (24) hours to utility companies prior to starting any excavation as follows:

   Kansas One-Call 1-800-344-7233

   The Contractor must notify the following in case of an emergency:

Cablevision	262-4270 or 263-2061
K.P.& L. Gas Service Company	263-7511
Kansas Gas & Electric	264-1141
Arkla Gas Company	942-8350 or 263-8161
Southwest Bell Telephone Company	1-571-2611
City of Wichita Water Department	268-4908
City of Wichita Sewer Maintenance	268-4071

2. The Contractor shall give all property owners and/or tenants of developed property directly abutting the construction of this project a minimum of ten (10) days advance notice prior to start of construction.

3. The Contractor shall be responsible for preserving property irons. The Contractor will be required to re-establish any property irons which are damaged or destroyed by his construction operations. Such irons shall be re-established by a licensed land surveyor in accordance with state law.

4. Traffic will not be affected by construction on this project.

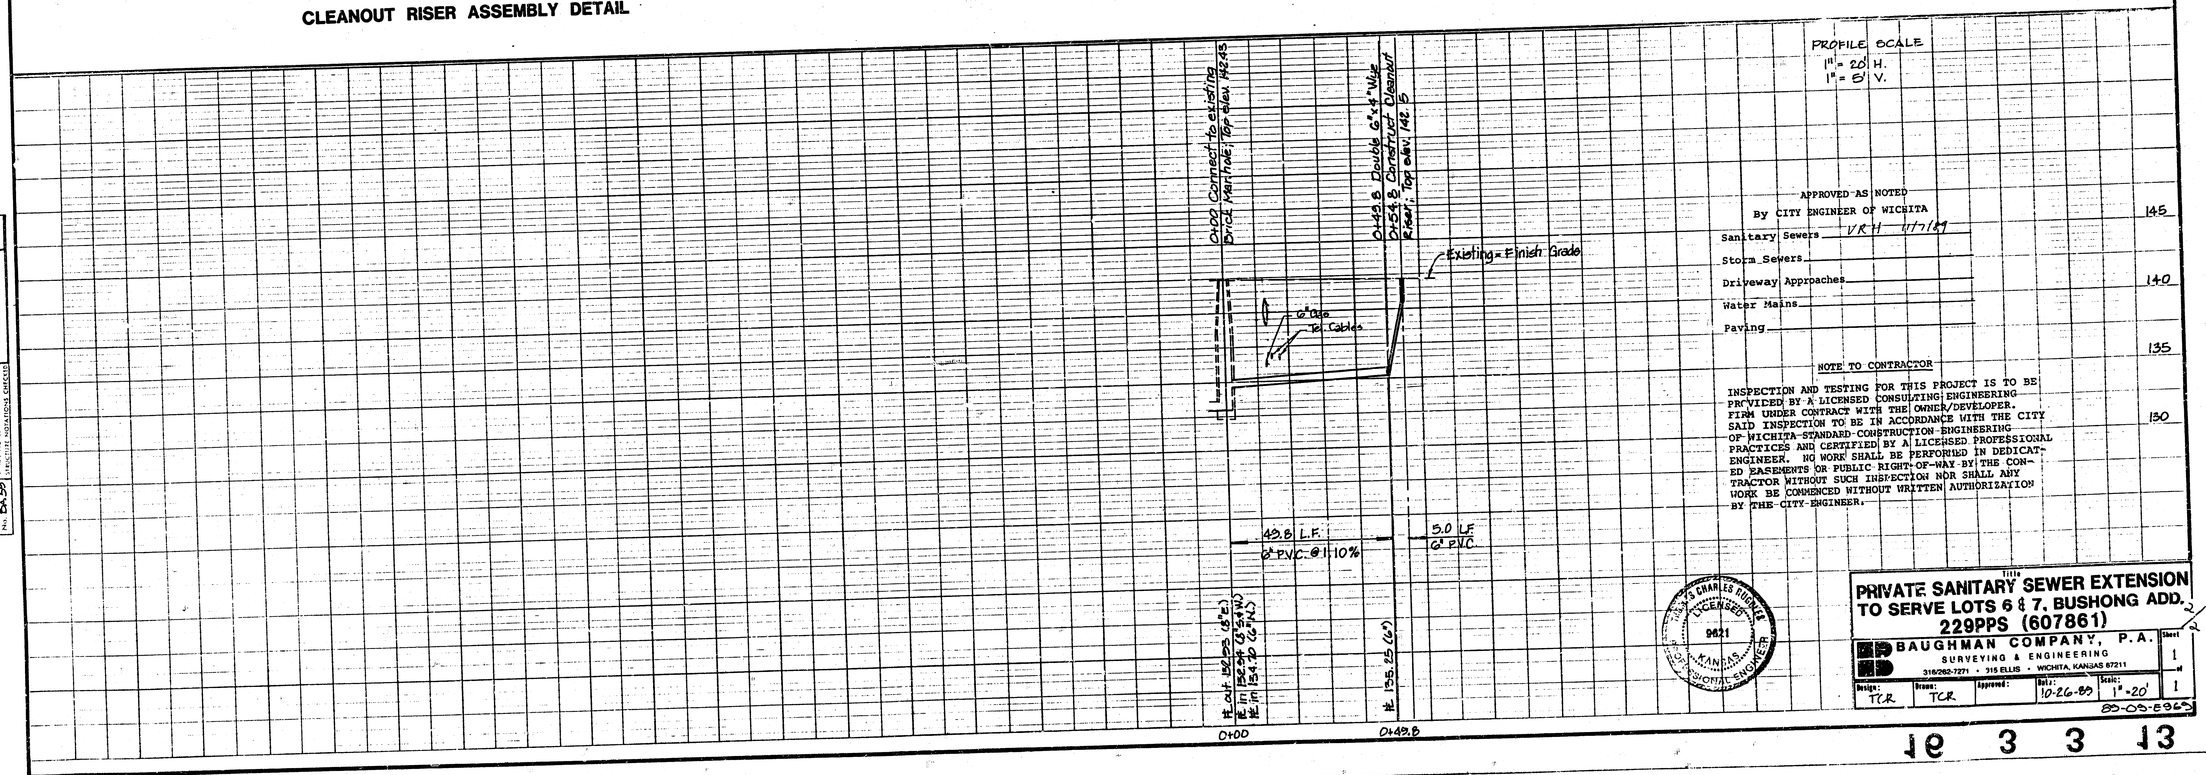

APPROVED AS NOTED
By CITY ENGINEER OF WICHITA
Sanitary Sewers VRH 11/7/89
Storm Sewers
Driveway Approaches
Water Mains
Paving

NOTE TO CONTRACTOR

INSPECTION AND TESTING FOR THIS PROJECT IS TO BE PROVIDED BY A LICENSED CONSULTING ENGINEERING FIRM UNDER CONTRACT WITH THE OWNER/DEVELOPER. SAID INSPECTION TO BE IN ACCORDANCE WITH THE CITY OF WICHITA STANDARD CONSTRUCTION ENGINEERING PRACTICES AND CERTIFIED BY A LICENSED PROFESSIONAL ENGINEER. NO WORK SHALL BE PERFORMED IN DEDICATED EASEMENTS OR PUBLIC RIGHT-OF-WAY BY THE CONTRACTOR WITHOUT SUCH INSPECTION NOR SHALL ANY WORK BE COMMENCED WITHOUT WRITTEN AUTHORIZATION BY THE CITY ENGINEER.


Title
PRIVATE SANITARY SEWER EXTENSION TO SERVE LOTS 6 & 7, BUSHONG ADD. 229PPS (607861)

BAUGHMAN COMPANY, P.A.
SURVEYING & ENGINEERING
316/262-7271 · 315 ELLIS · WICHITA, KANSAS 67211

Design:	Drawn:	Approved:	Date:	Scale:	Sheet
TCR	TCR		10-26-89	1" = 20'	1 of 1

89-09-5963

PLAN — NOTE BOOK No. — PLOTTED — POSTED — AS-BUILT CHECKED — W.O. WAS CREATED — DATE

PROFILE — NOTE BOOK No. BA-59 — PLOTTED — POSTED — GRADES CHECKED — W.O. WAS CREATED — AS-BUILT INSPECTIONS CHECKED — DATE — BY

FILMED FROM THE BEST AVAILABLE COPY