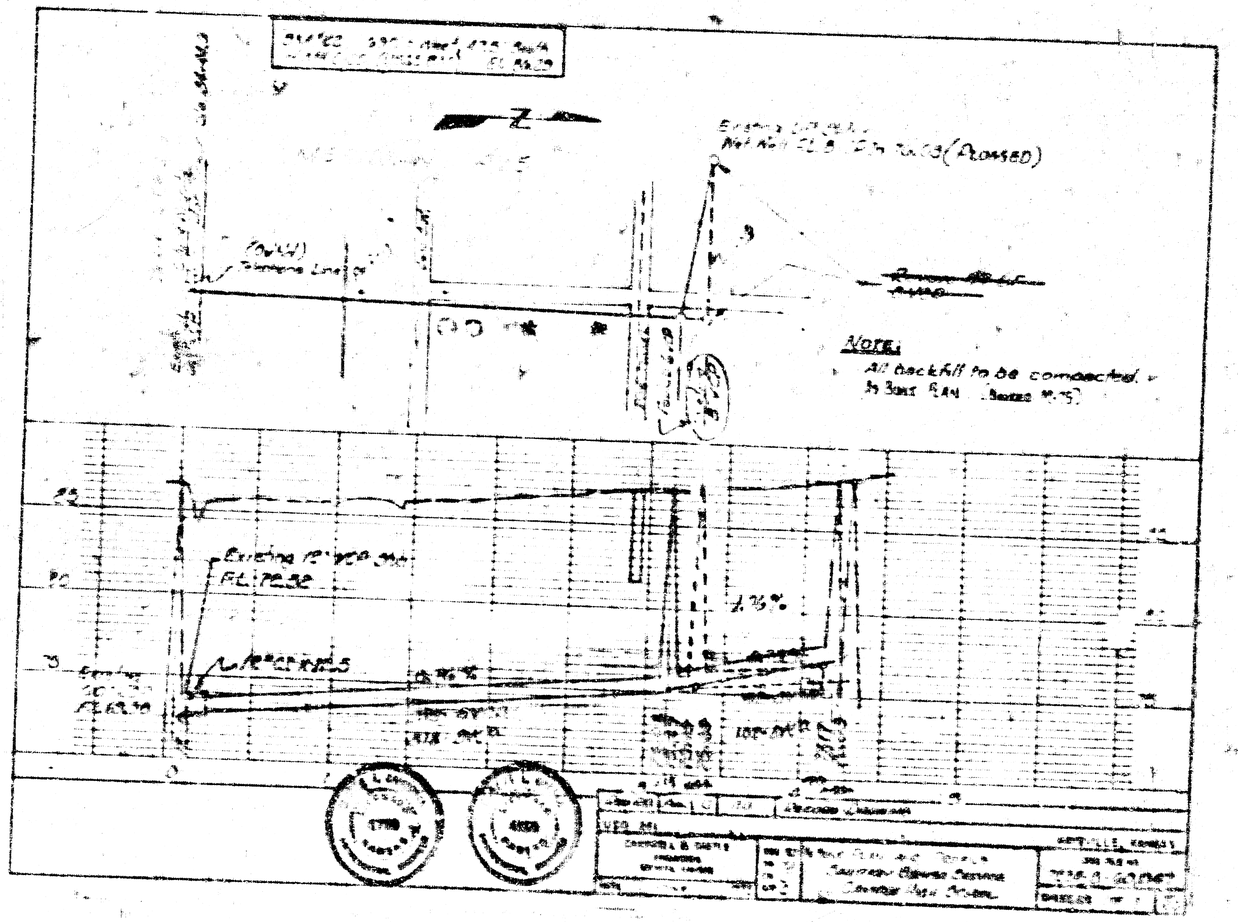
NOTE:
All backfill to be compacted.
1.35%