



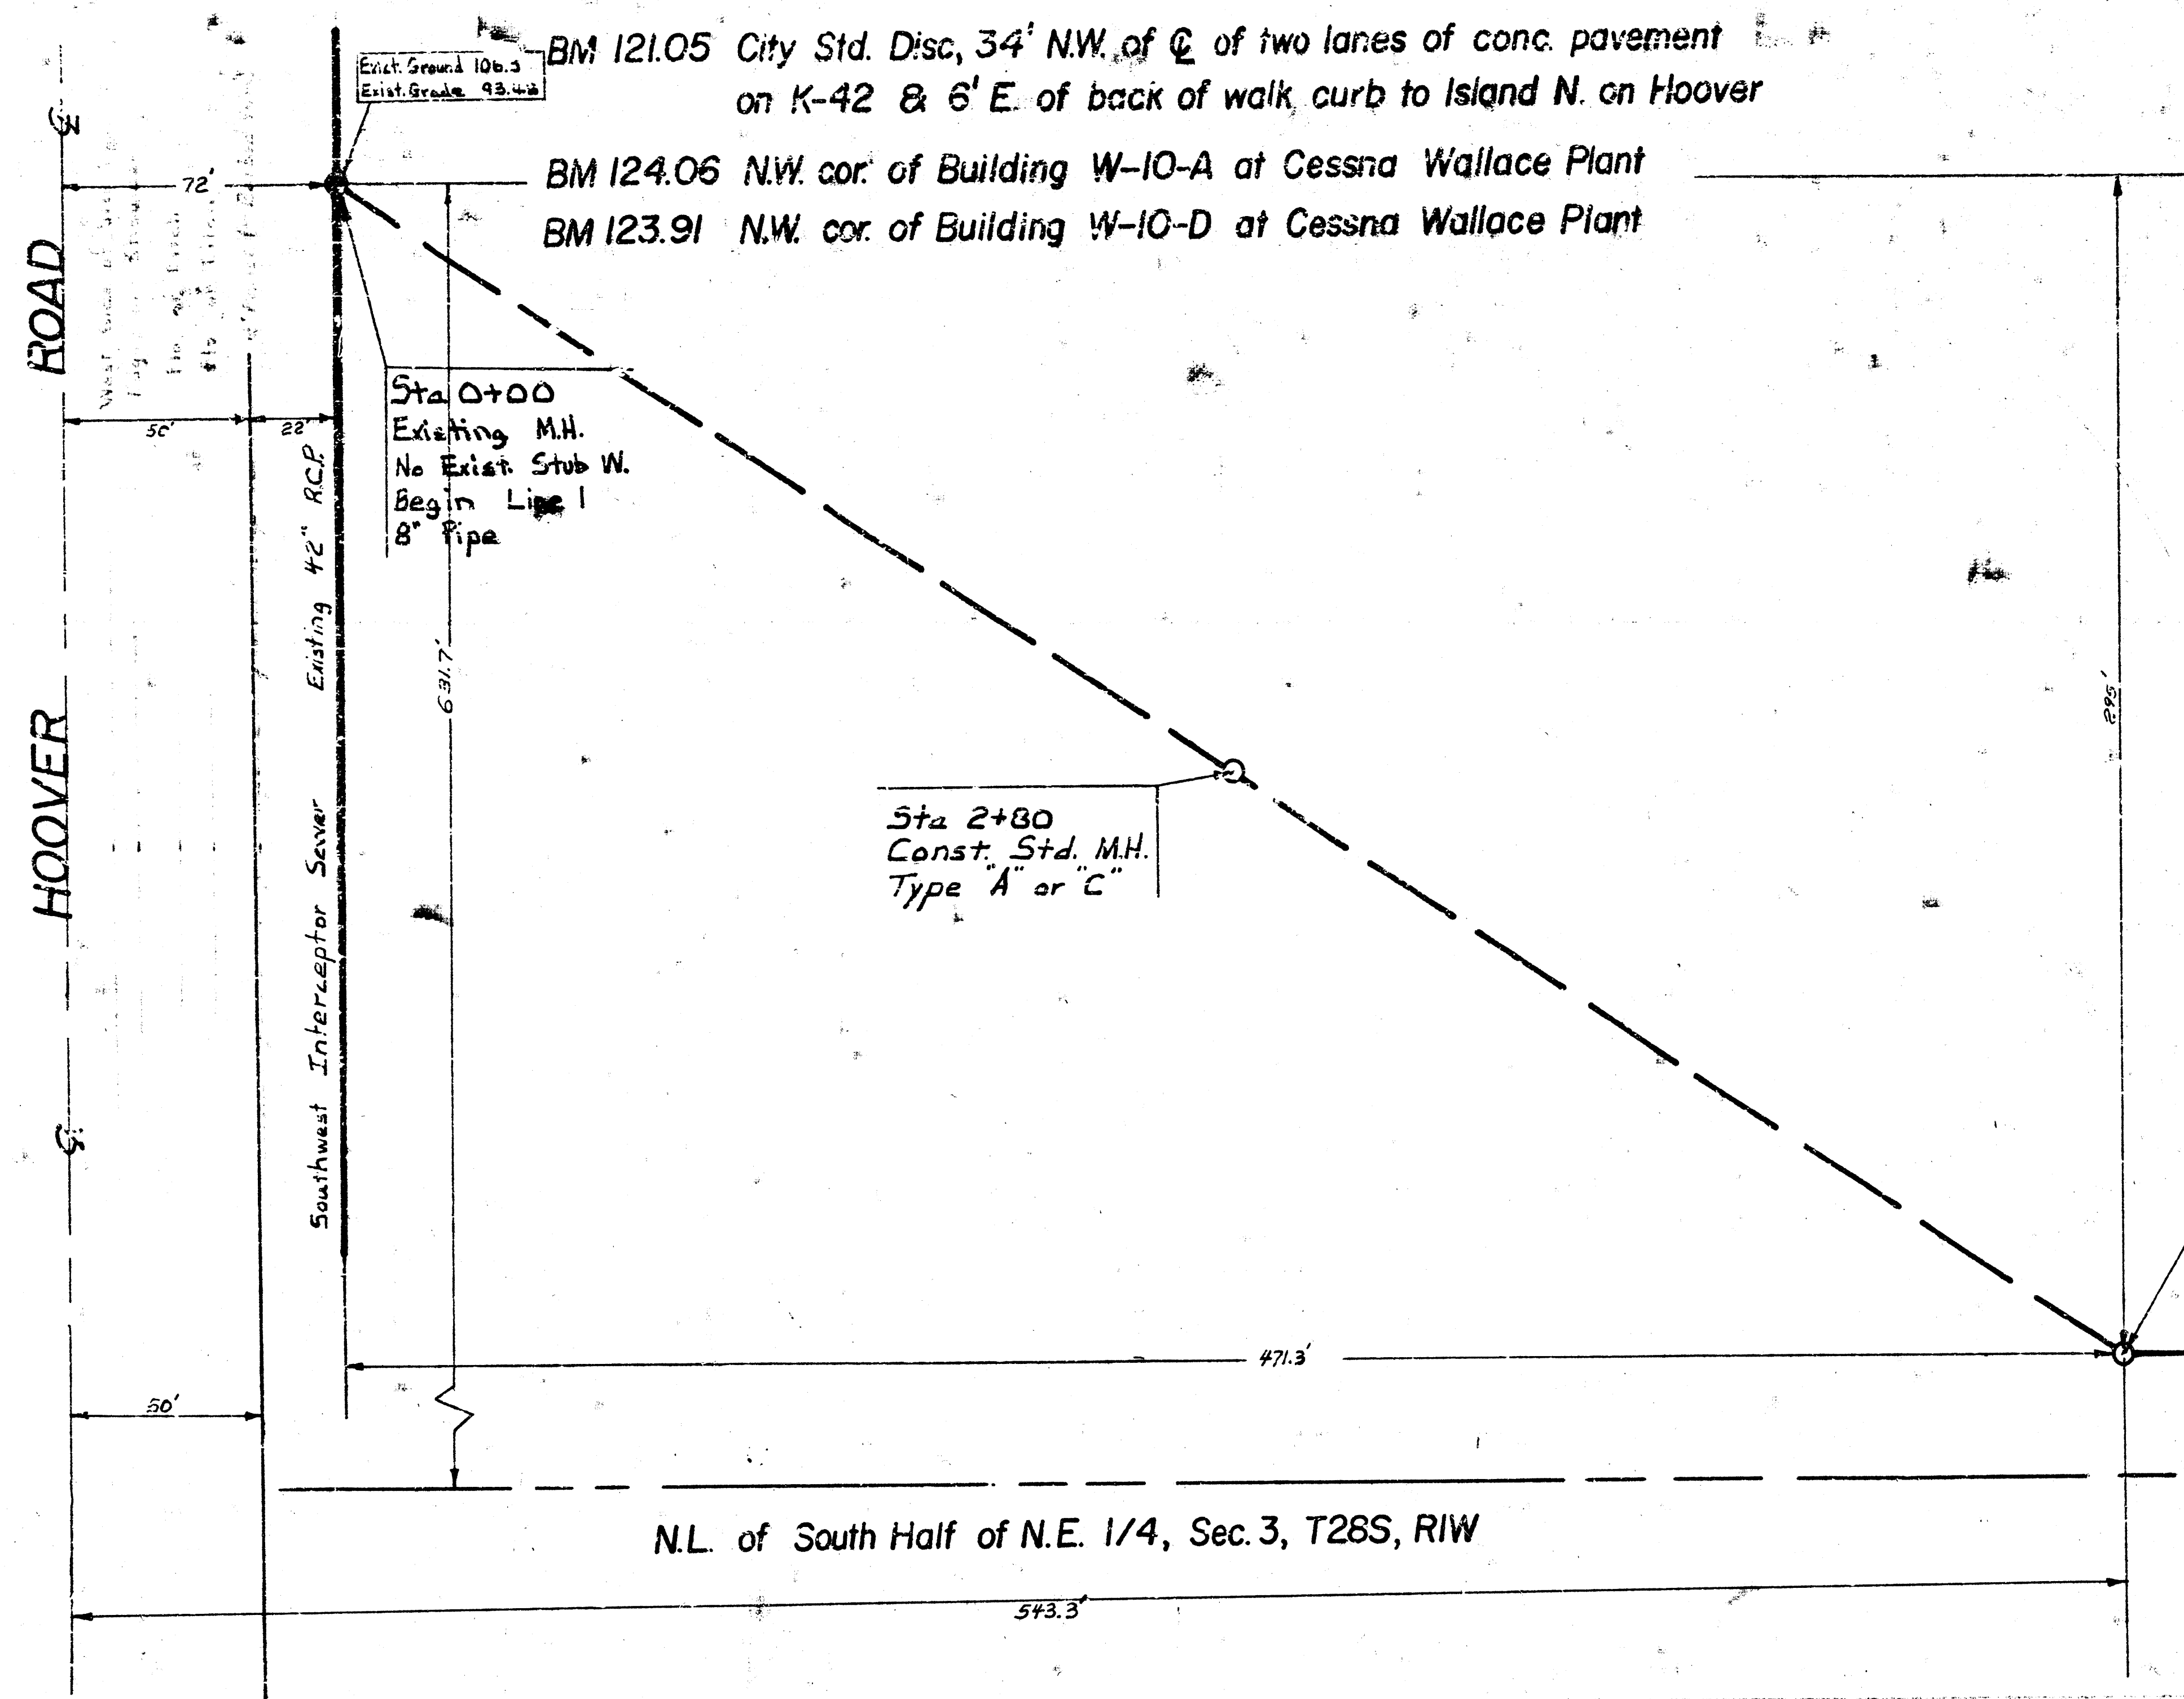




Plan Scale 1" = 40'



Profile Scale 1" = 40' Hor.
1" = 5' Vert.

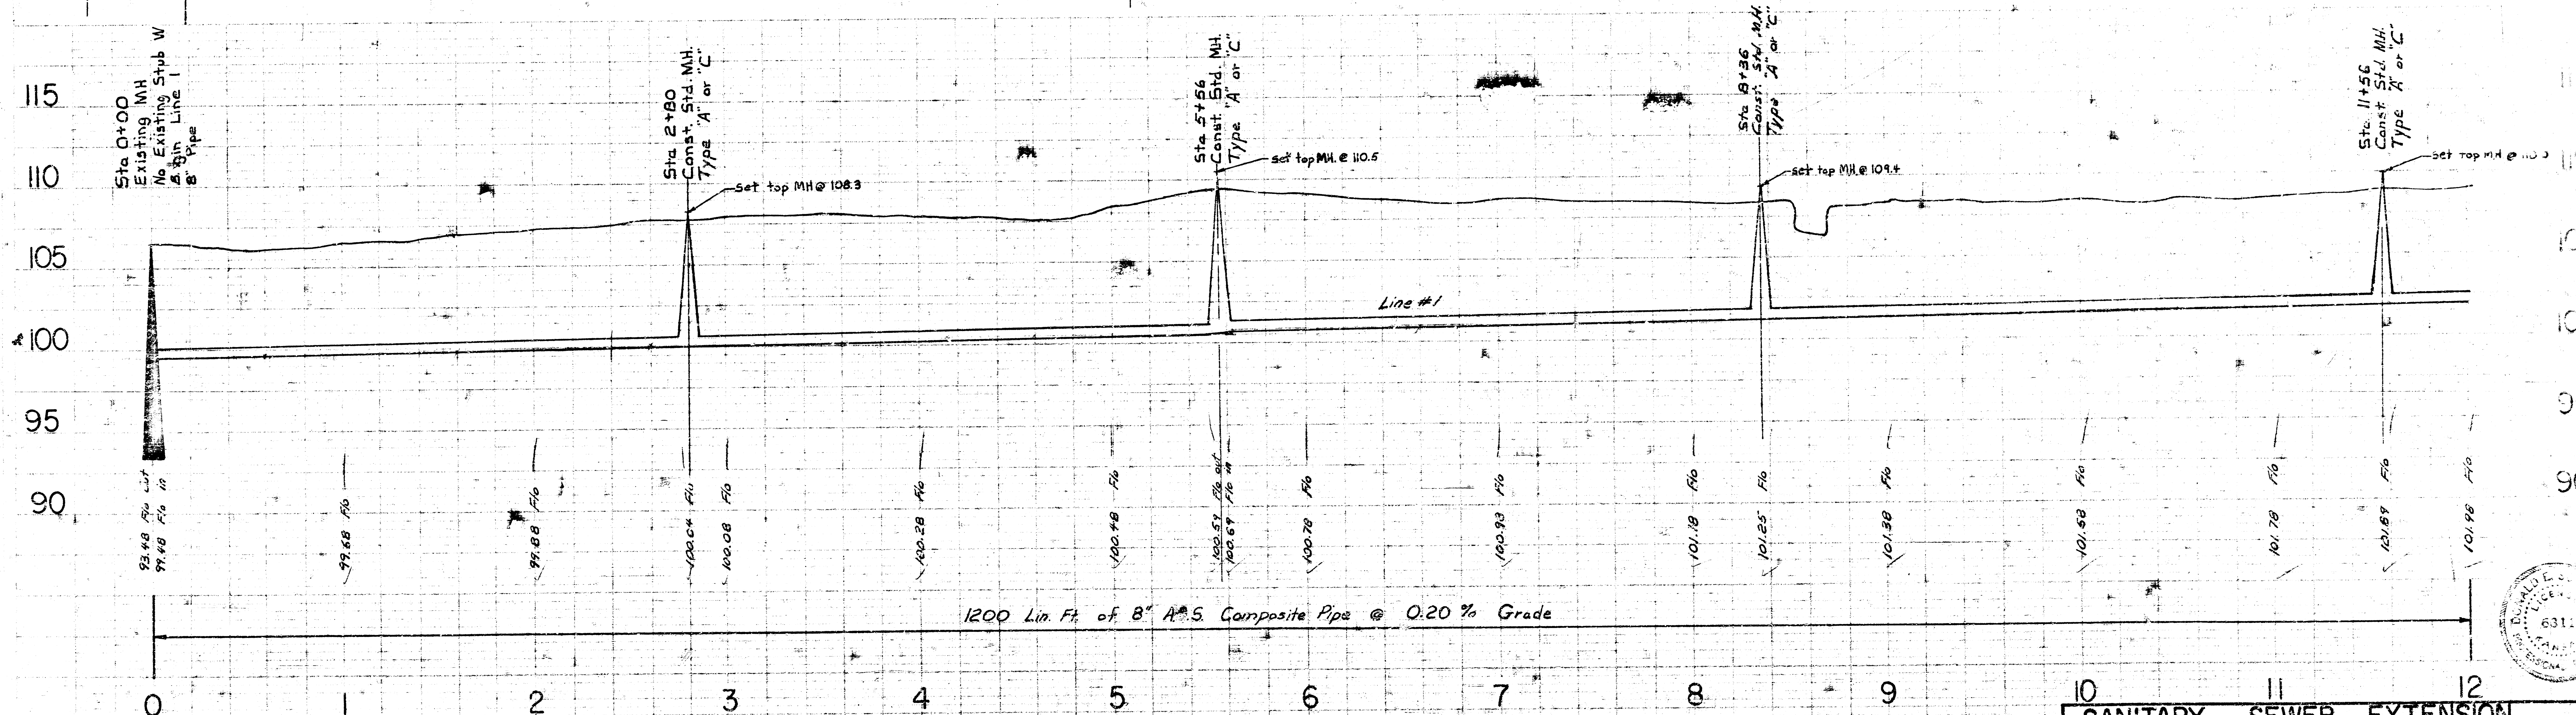



SANITARY SEWER EXTENSION
CESSNA WALLACE PLANT
 West of Hoover Rd. & North of K-42 Highway
 CITY OF WICHITA, KANSAS
 R. W. LINN — CITY ENGINEER
 Private Project No. DBKW706053

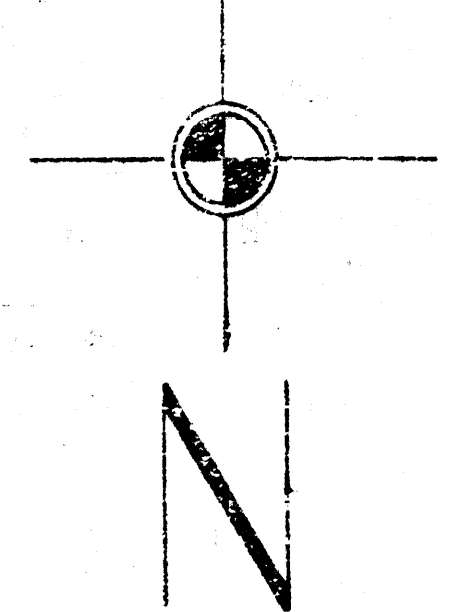

 Plan Scale 1" = 40'
 Profile Scale 1" = 40' Hor.
 1" = 5' Vert.

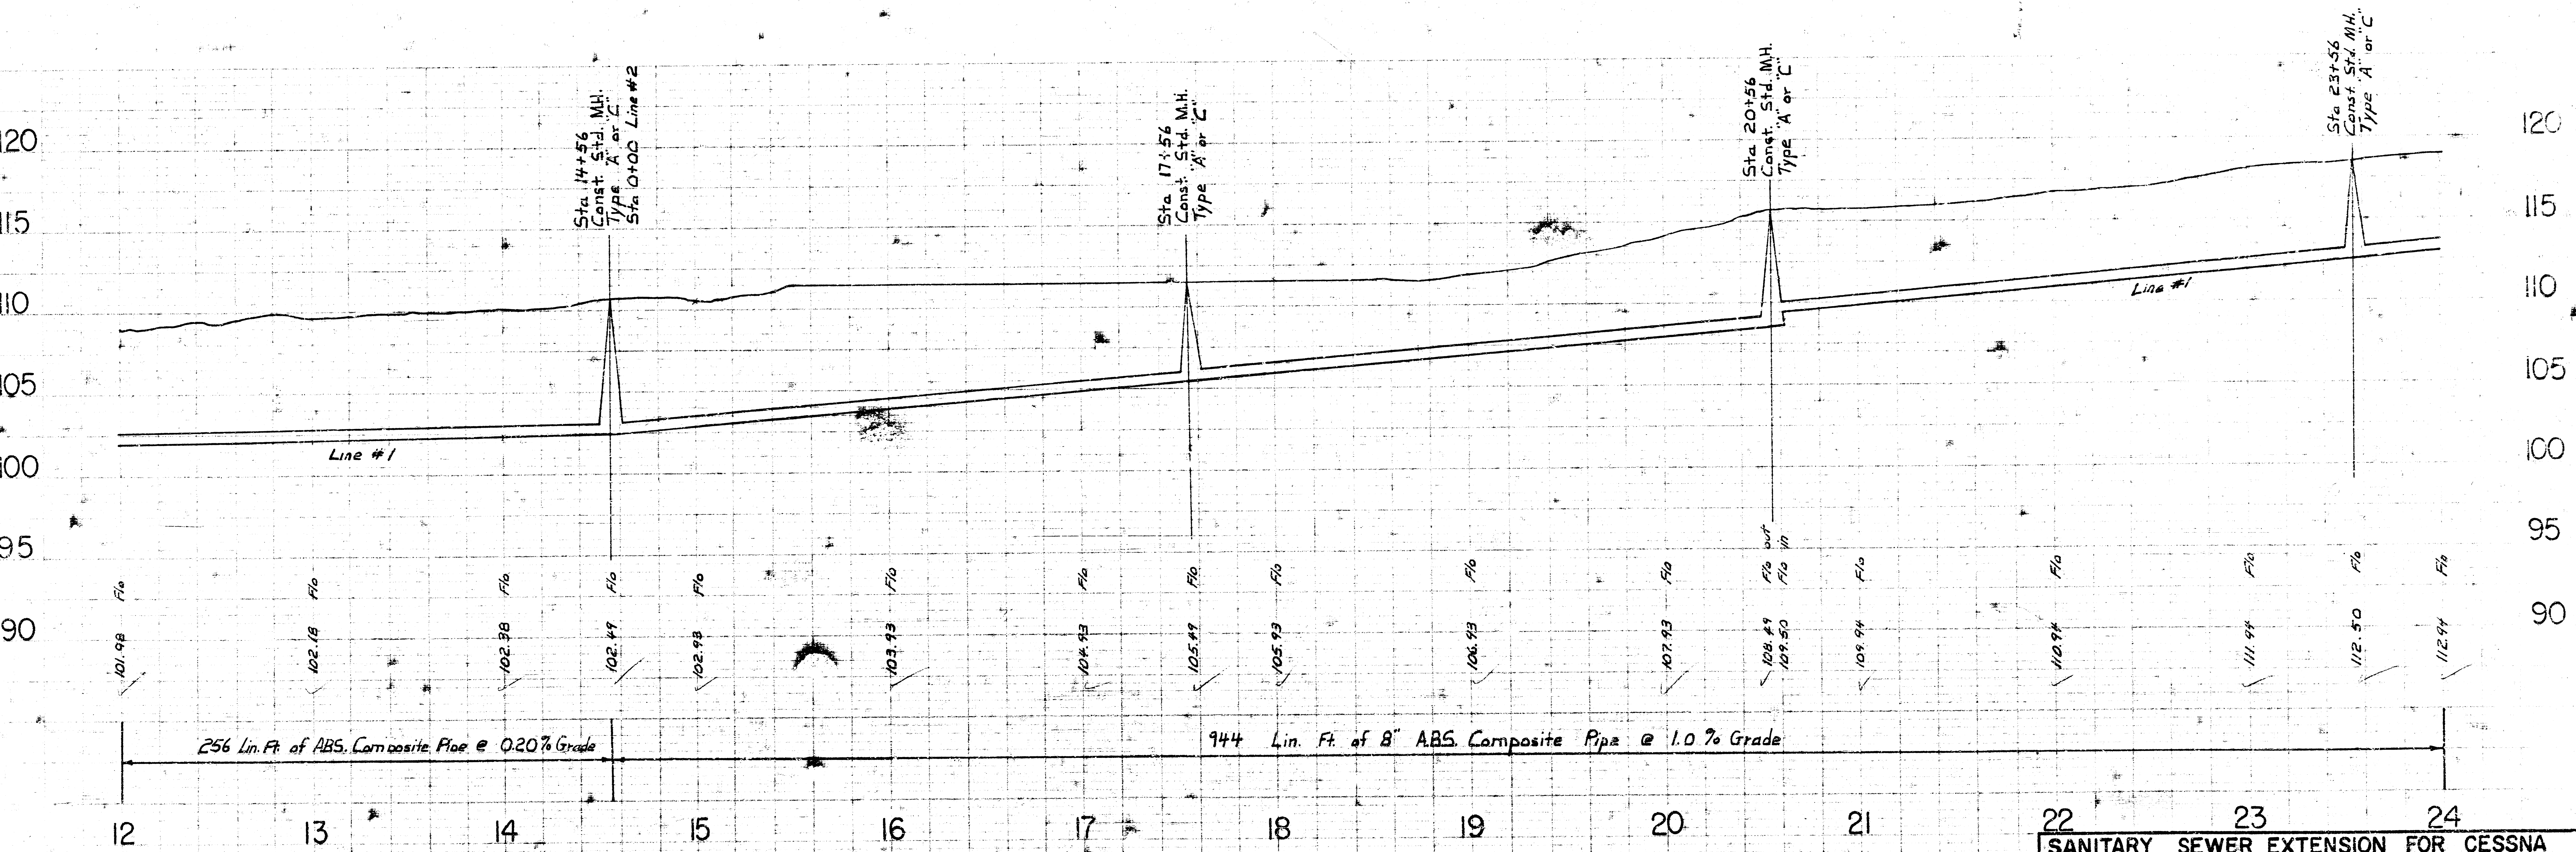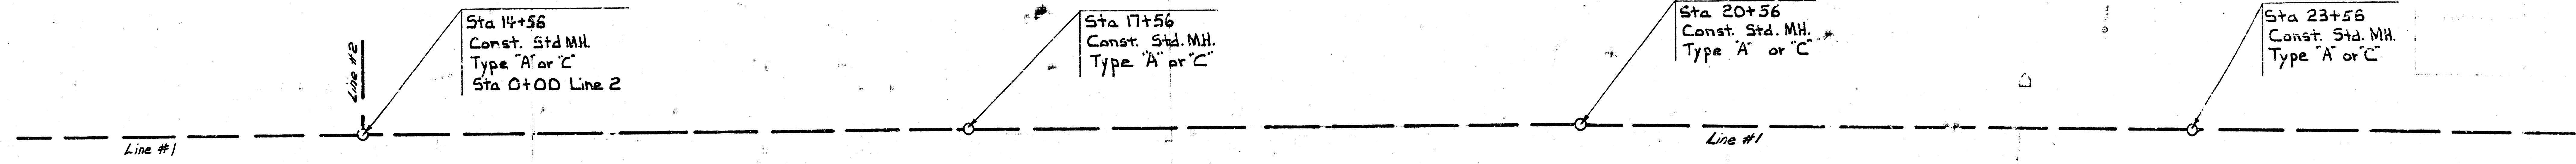

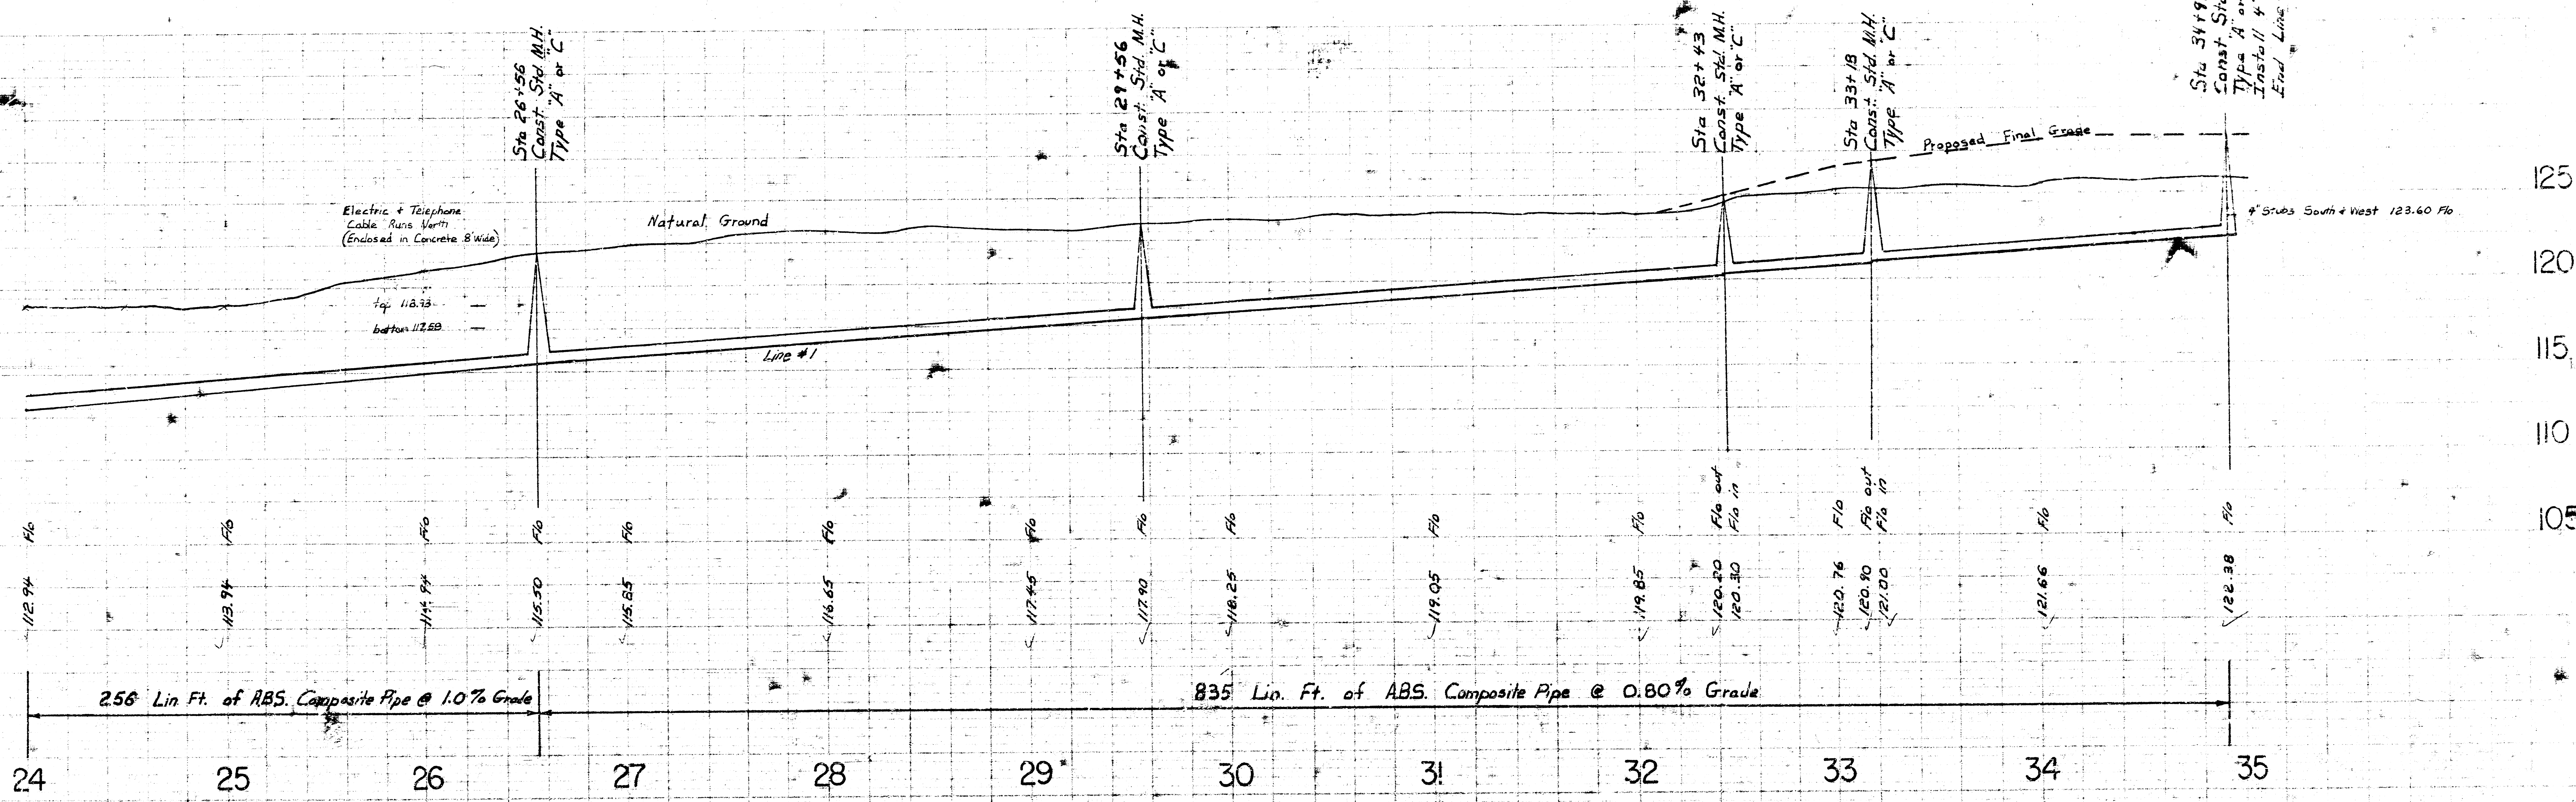
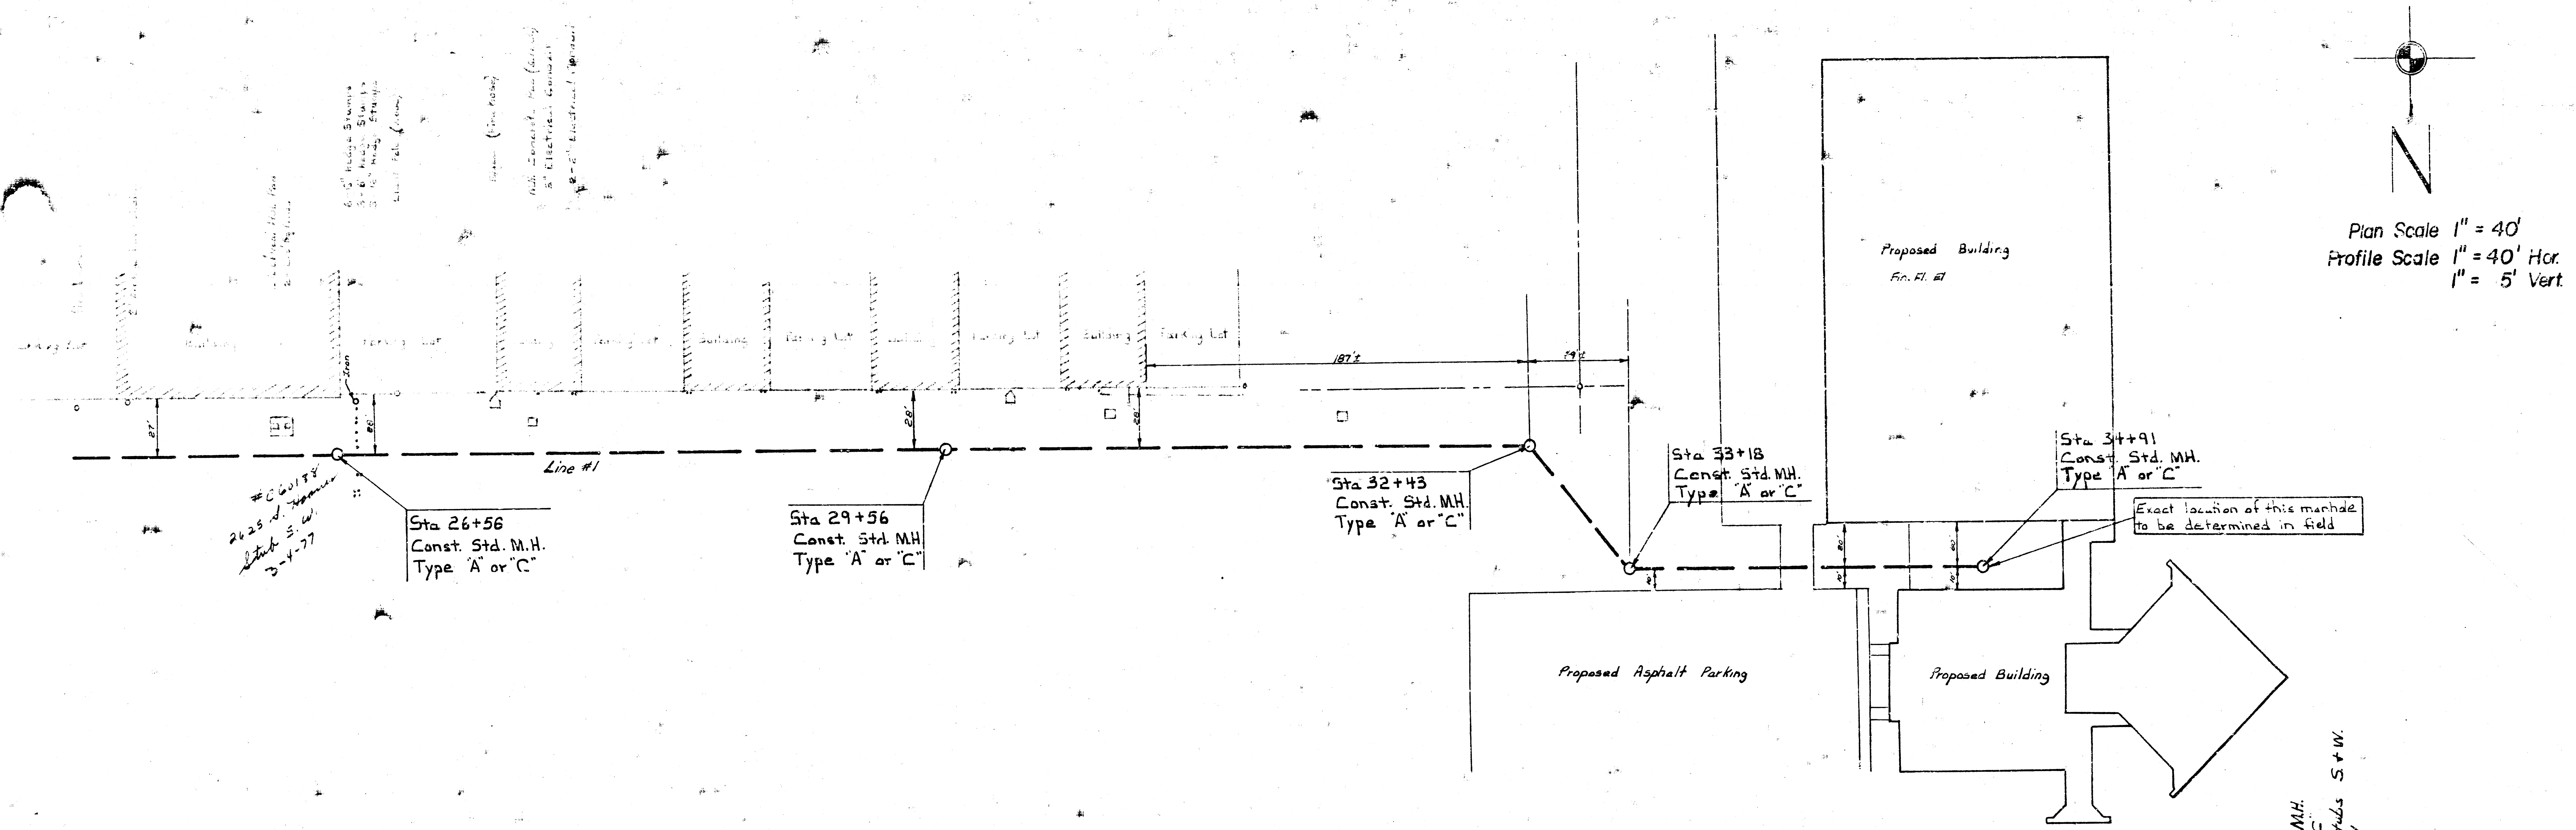


N
 Plan Scale 1" = 40'
 Profile Scale 1" = 40' Hor.
 1" = 5' Vert.

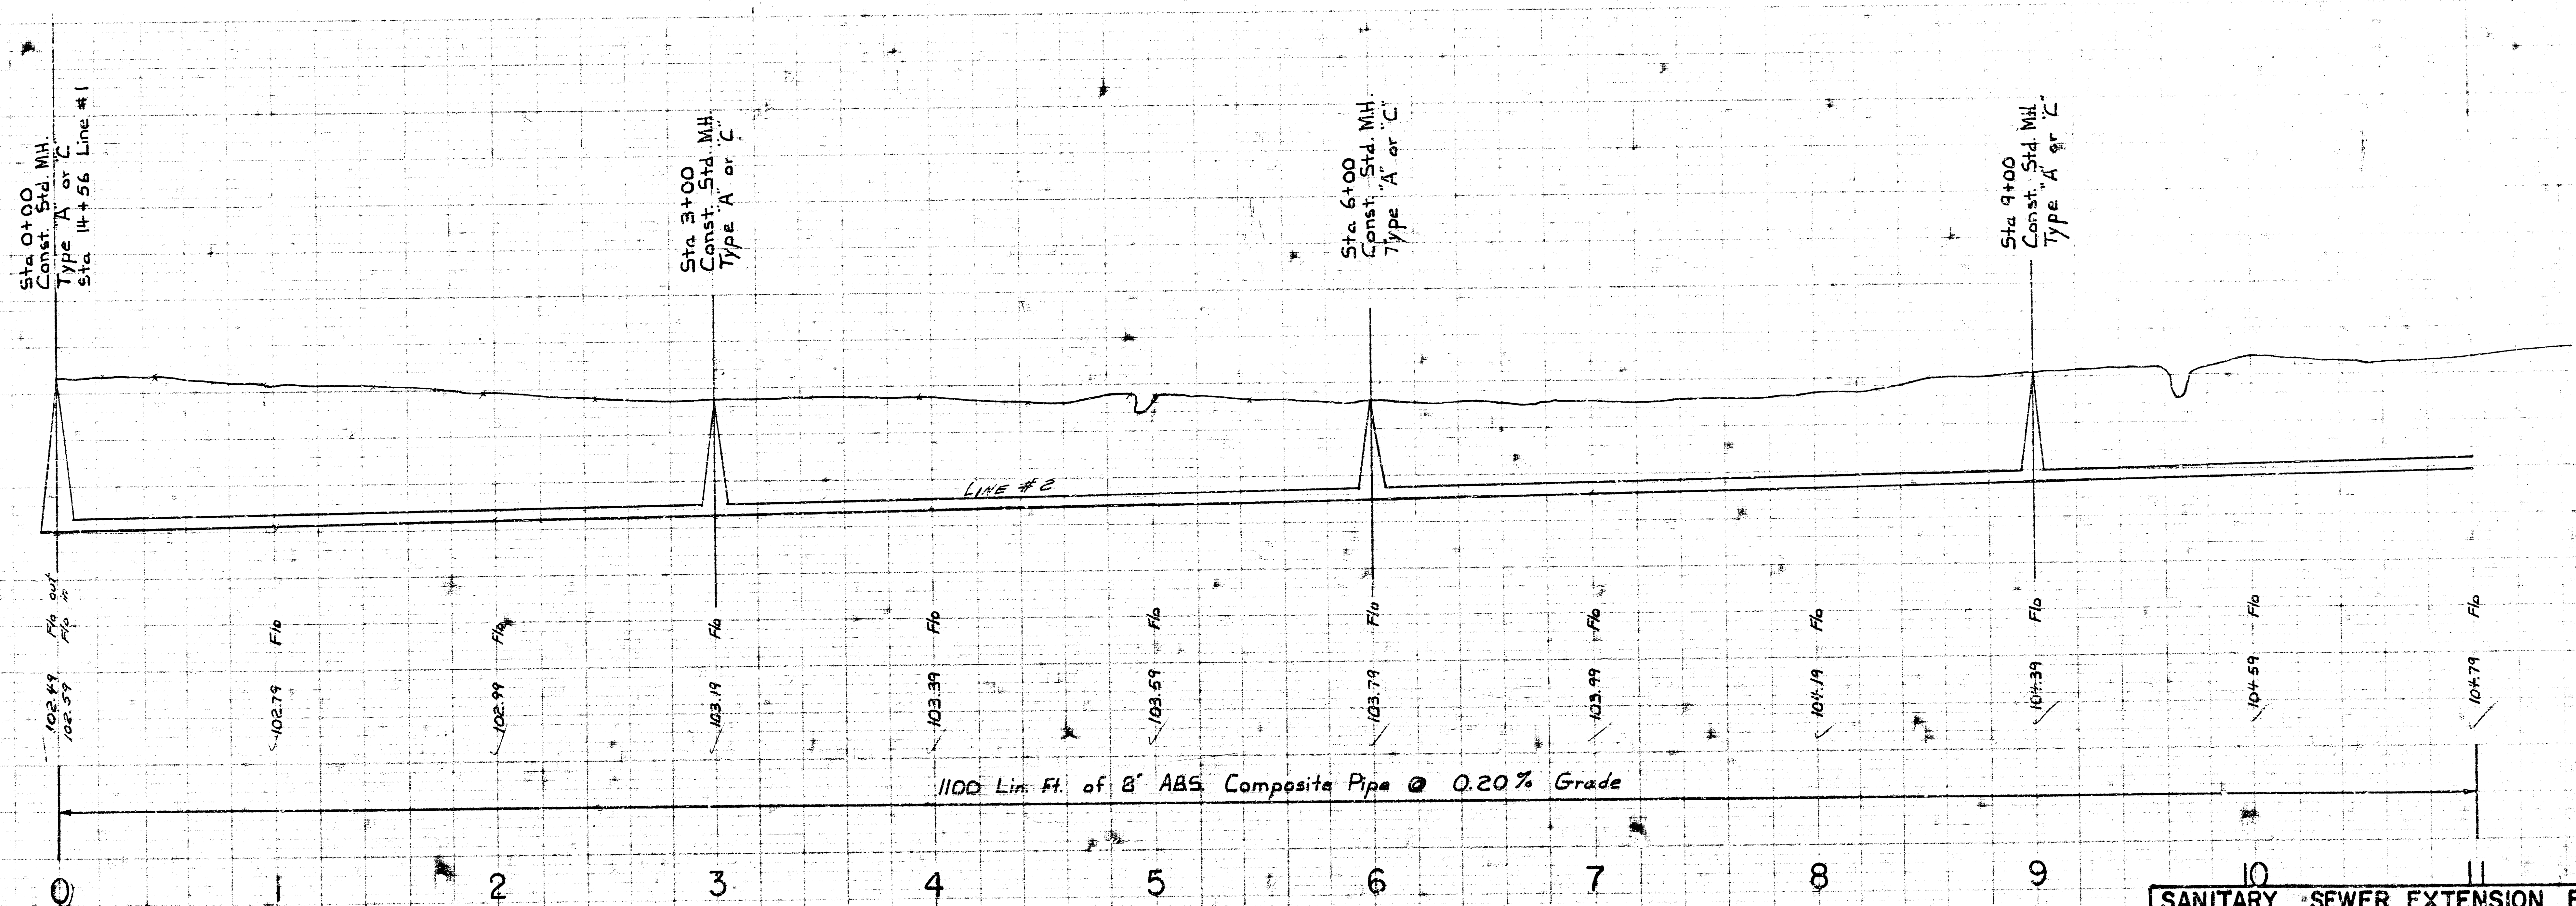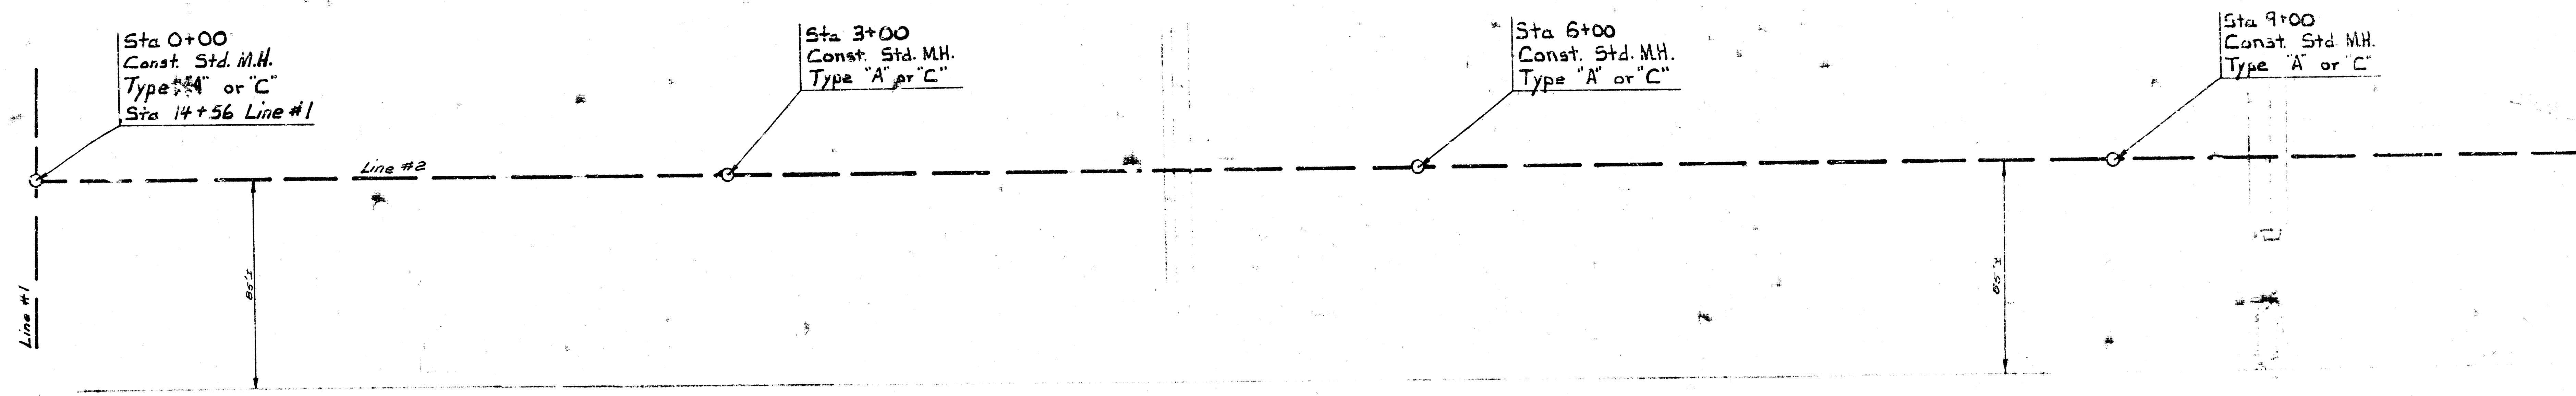

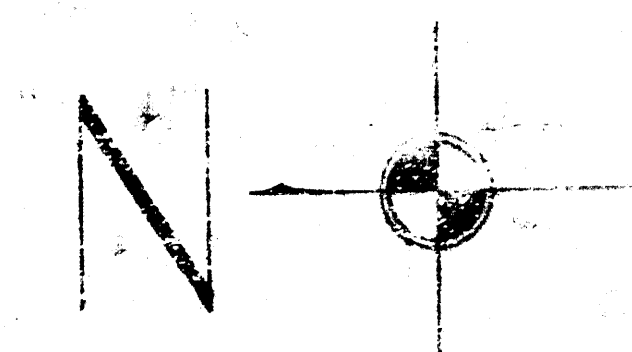



Plan Scale 1" = 40'
Profile Scale 1" = 40' hor
1" = 5' vert

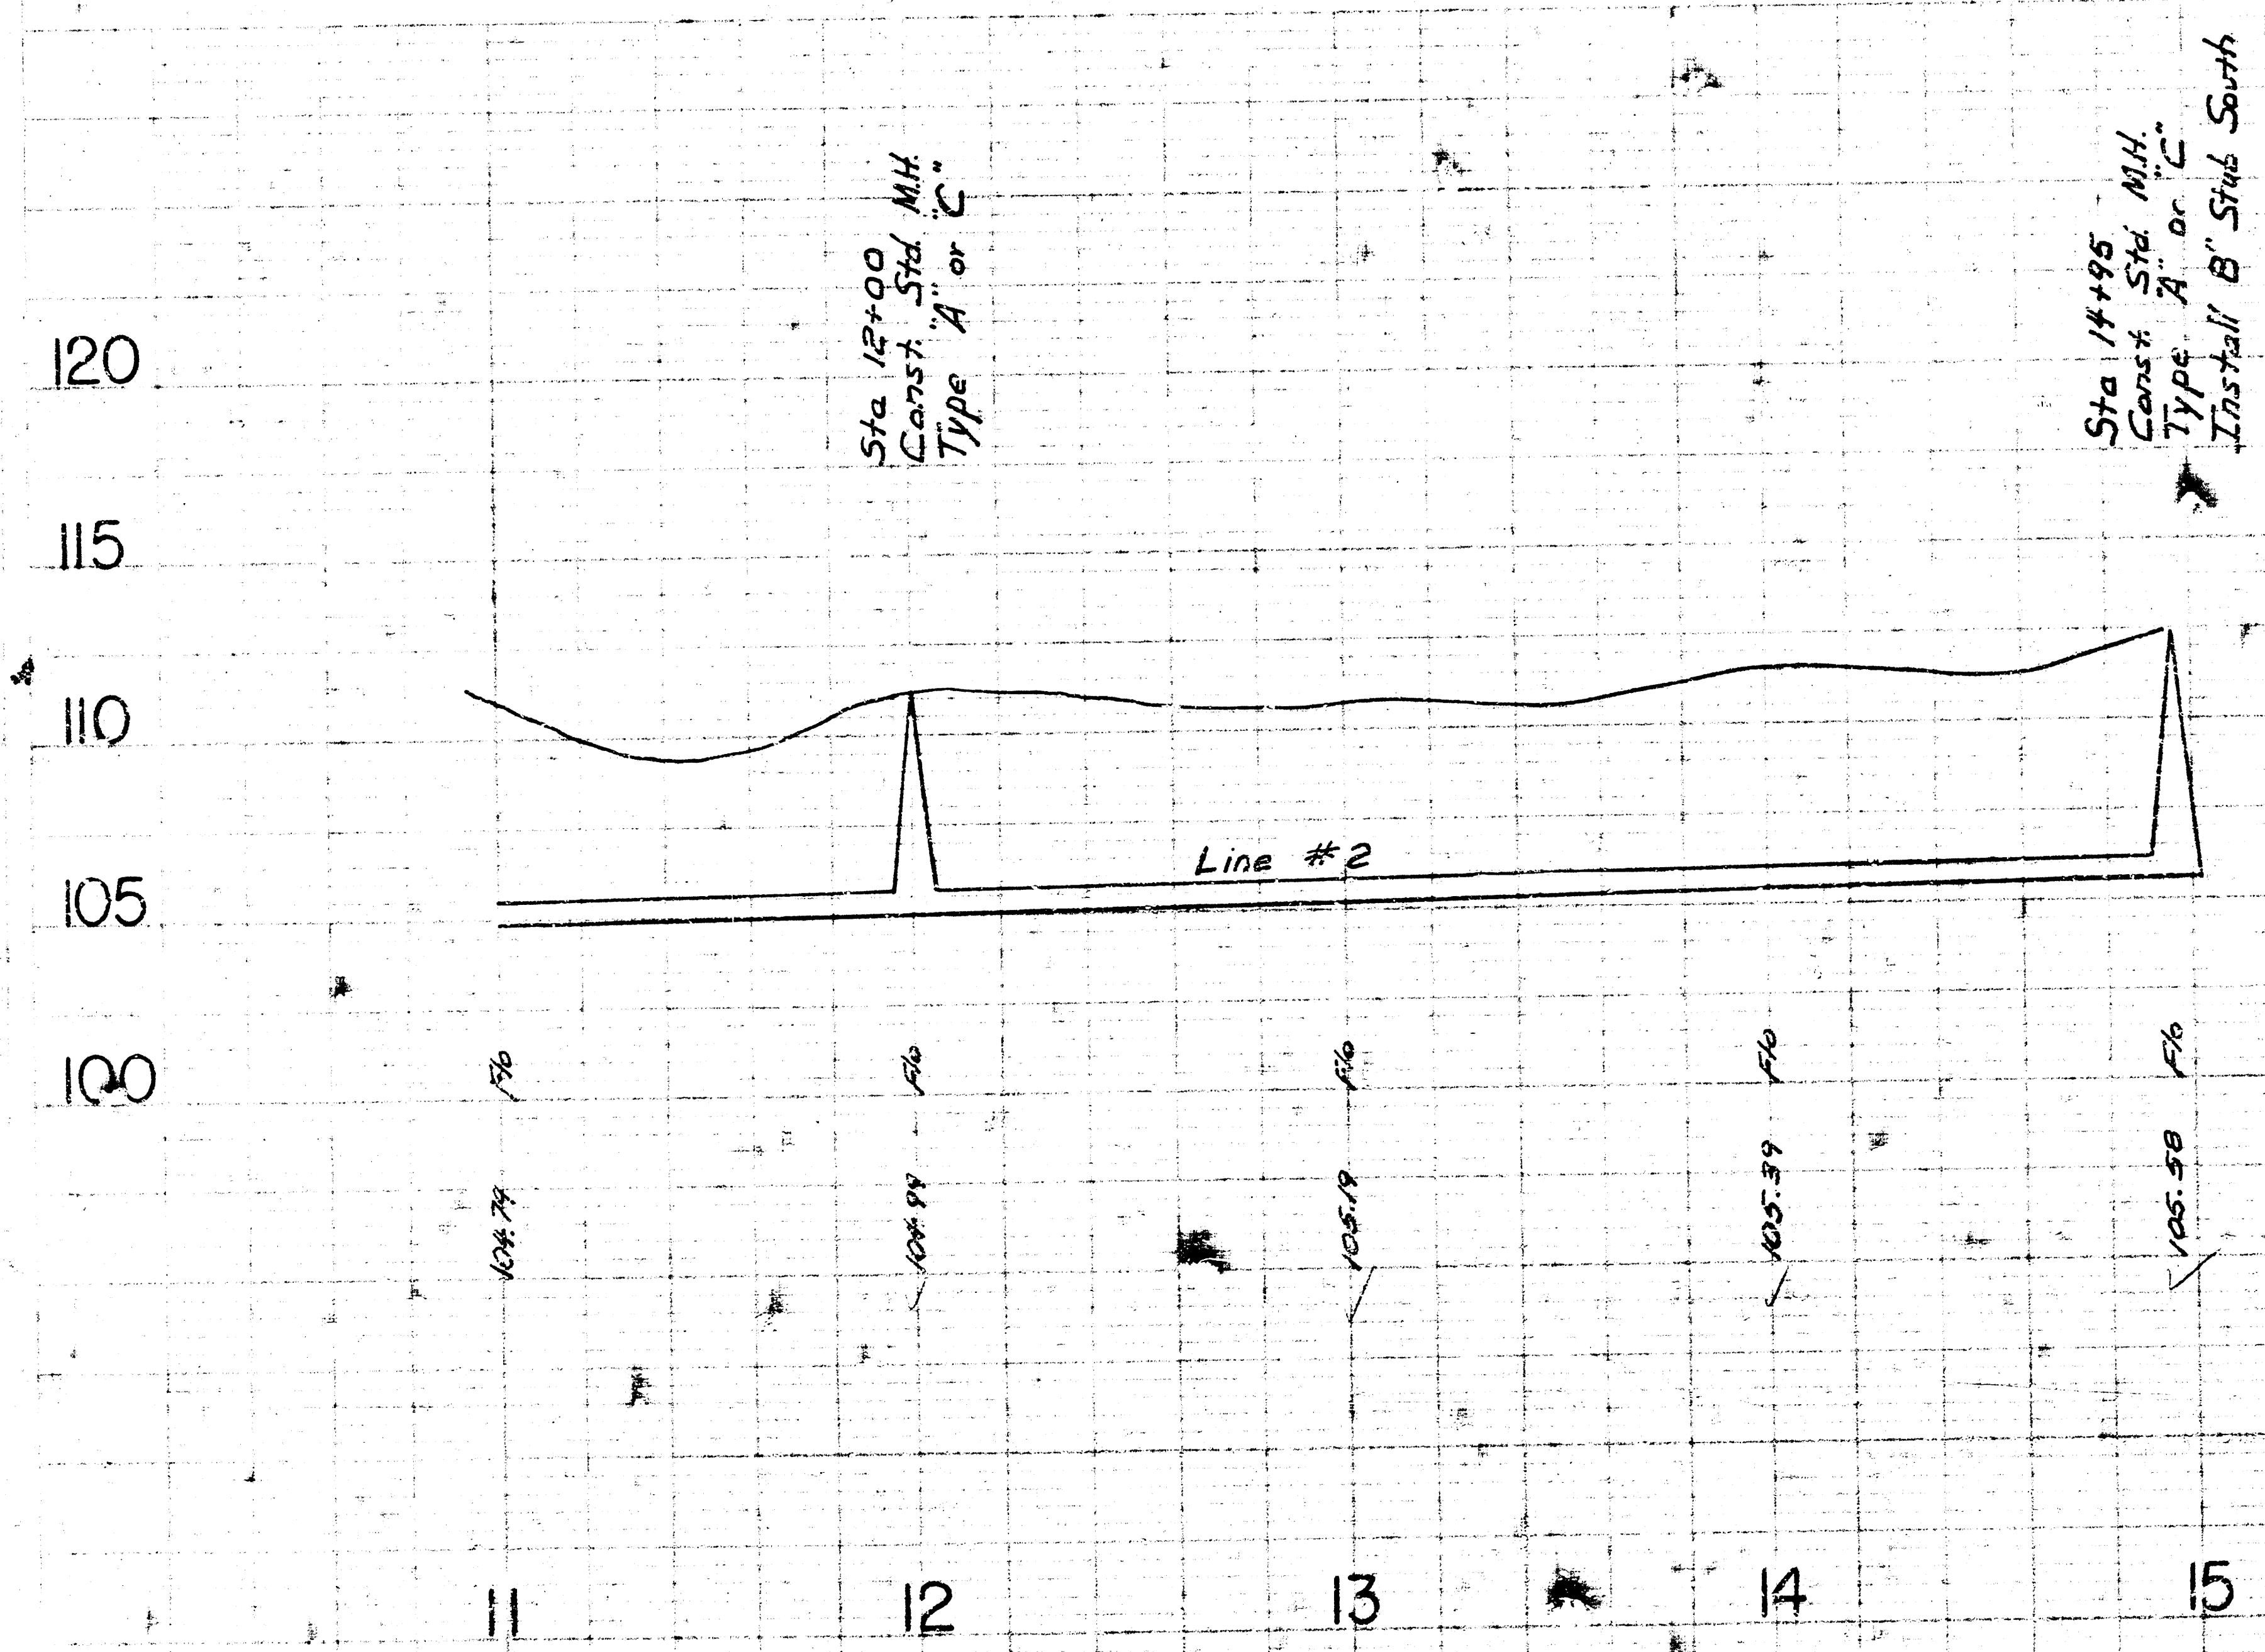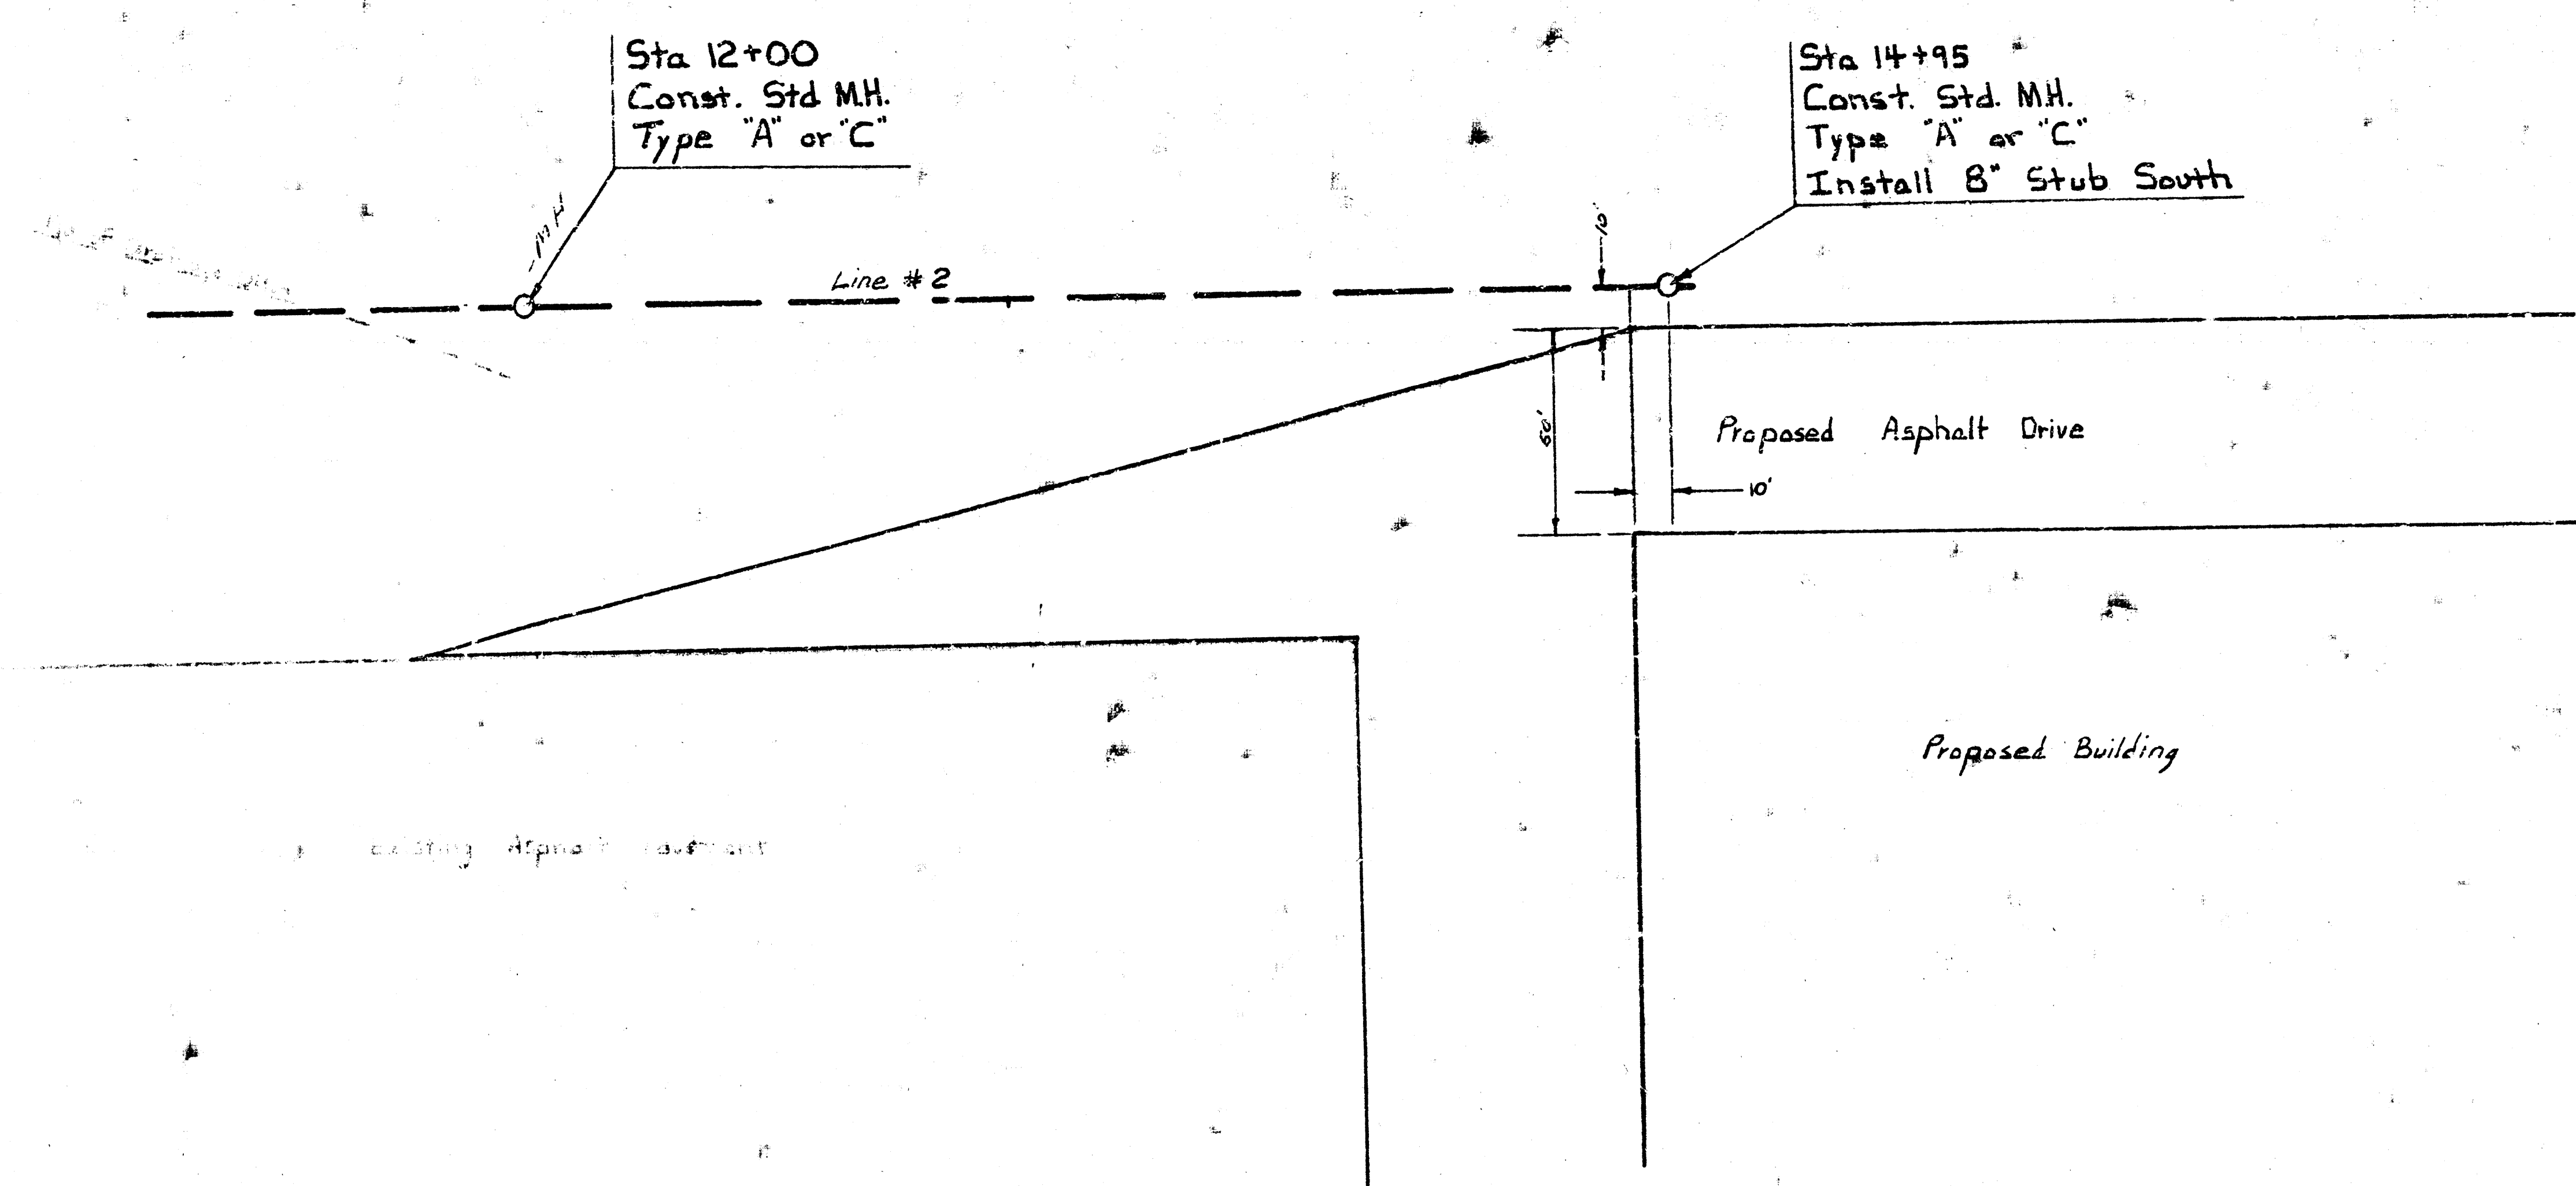

**EXTENSION FOR CESSNA
SANITARY SEWER**
West of Howe Rd. & North of 14th St.
CITY OF WICHITA, KANSAS
R. W. LINN - CITY ENGINEER
Private Project No. 141-11-1


APPROVED AS NOTED
BY CITY ENGINEER OF WICHITA
R. W. LINN
2-1-78

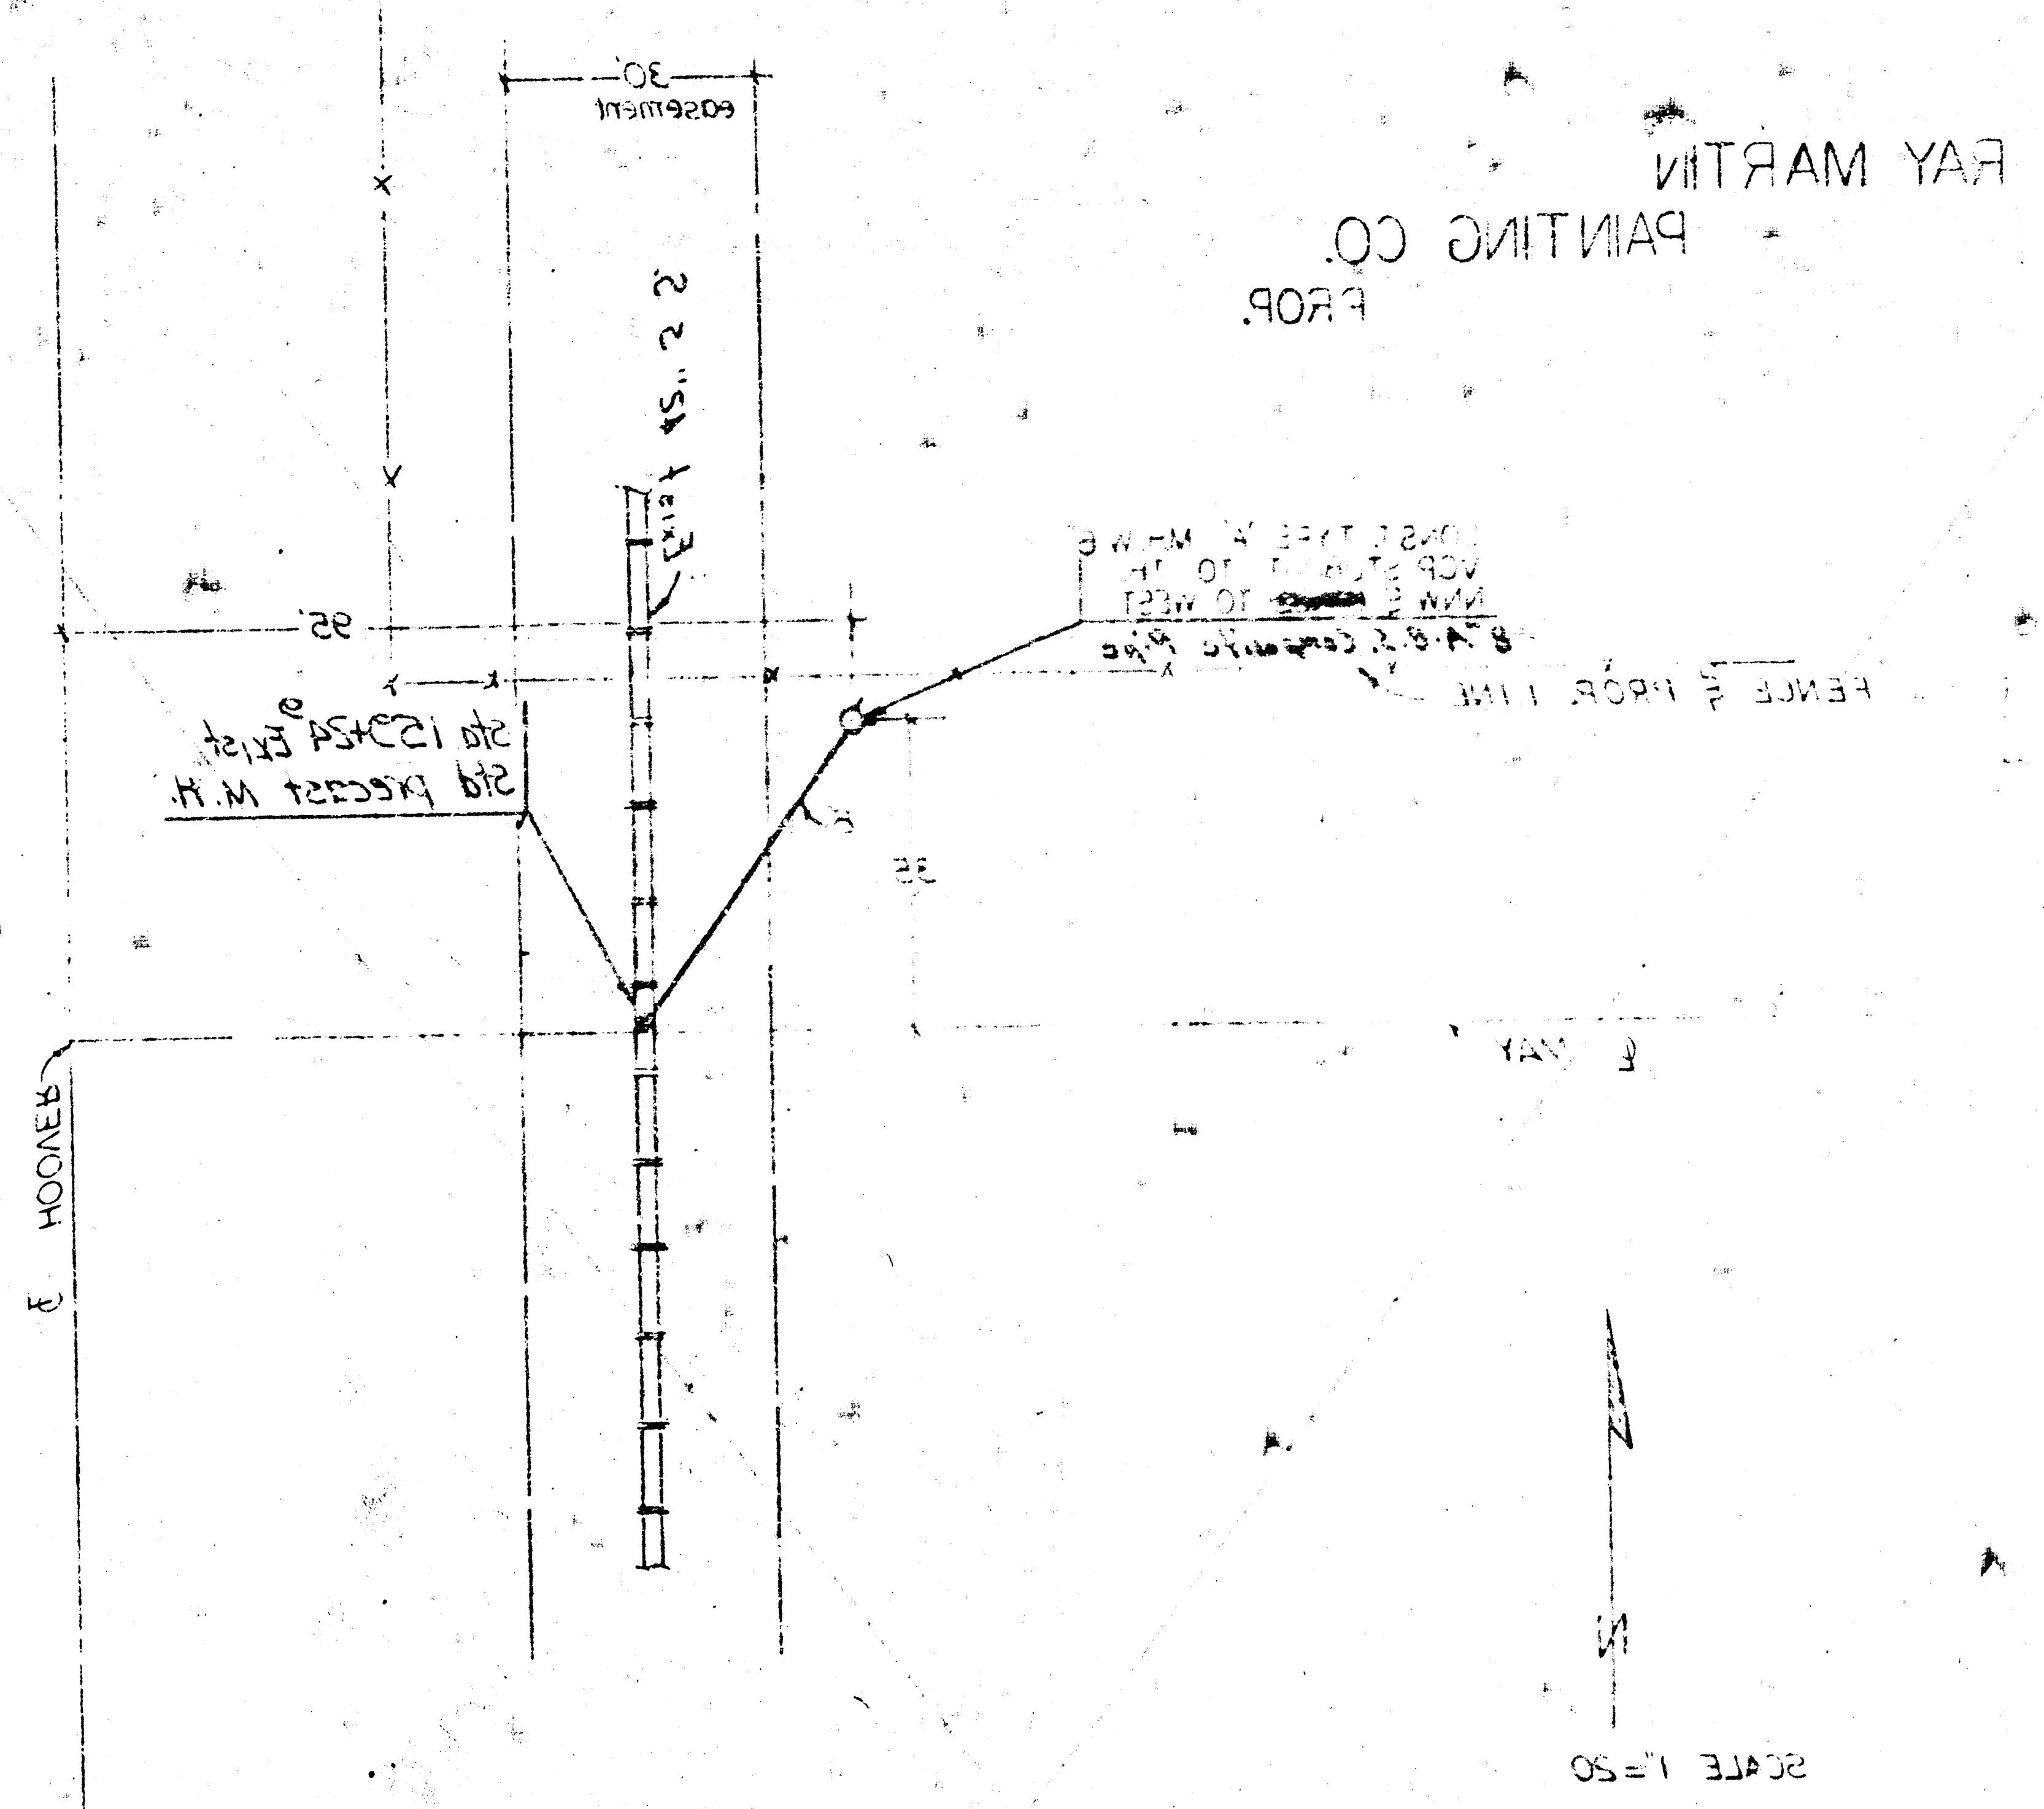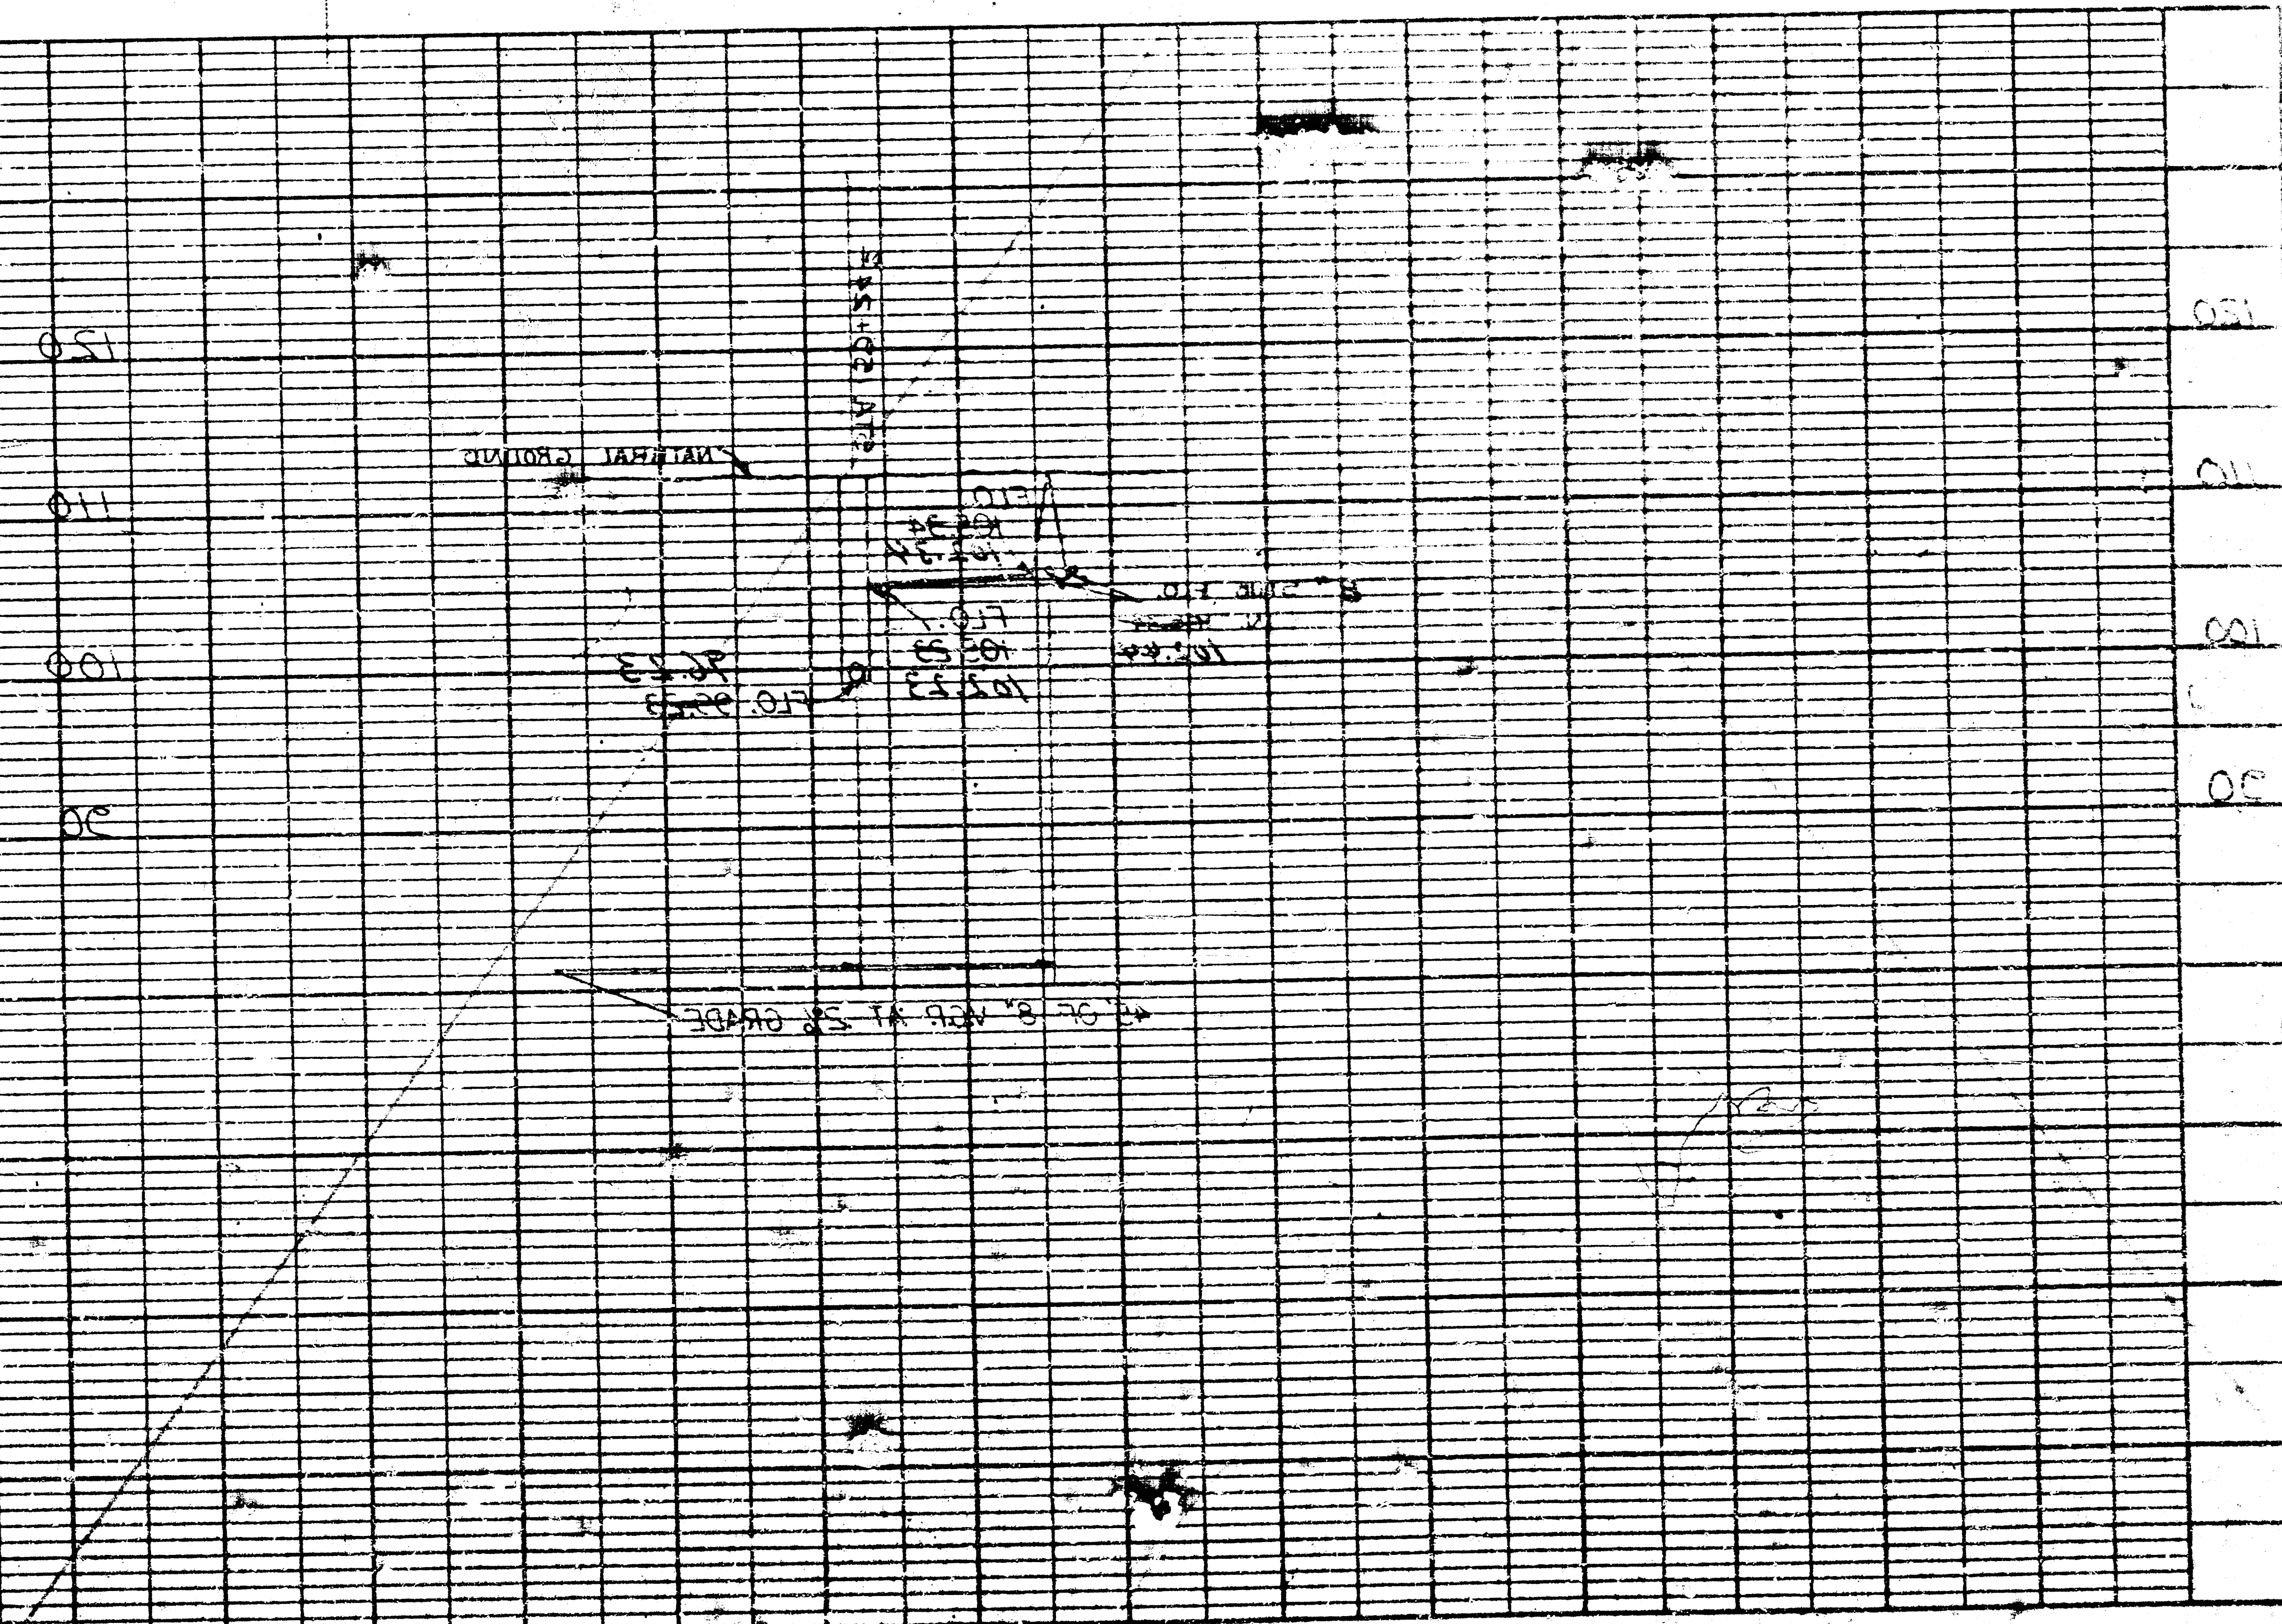

RAY MARTIN
PAINTING CO.
PROP.

**CONNECTION FOR
PRECAST MAN-HOLE**
NO SCALE

