




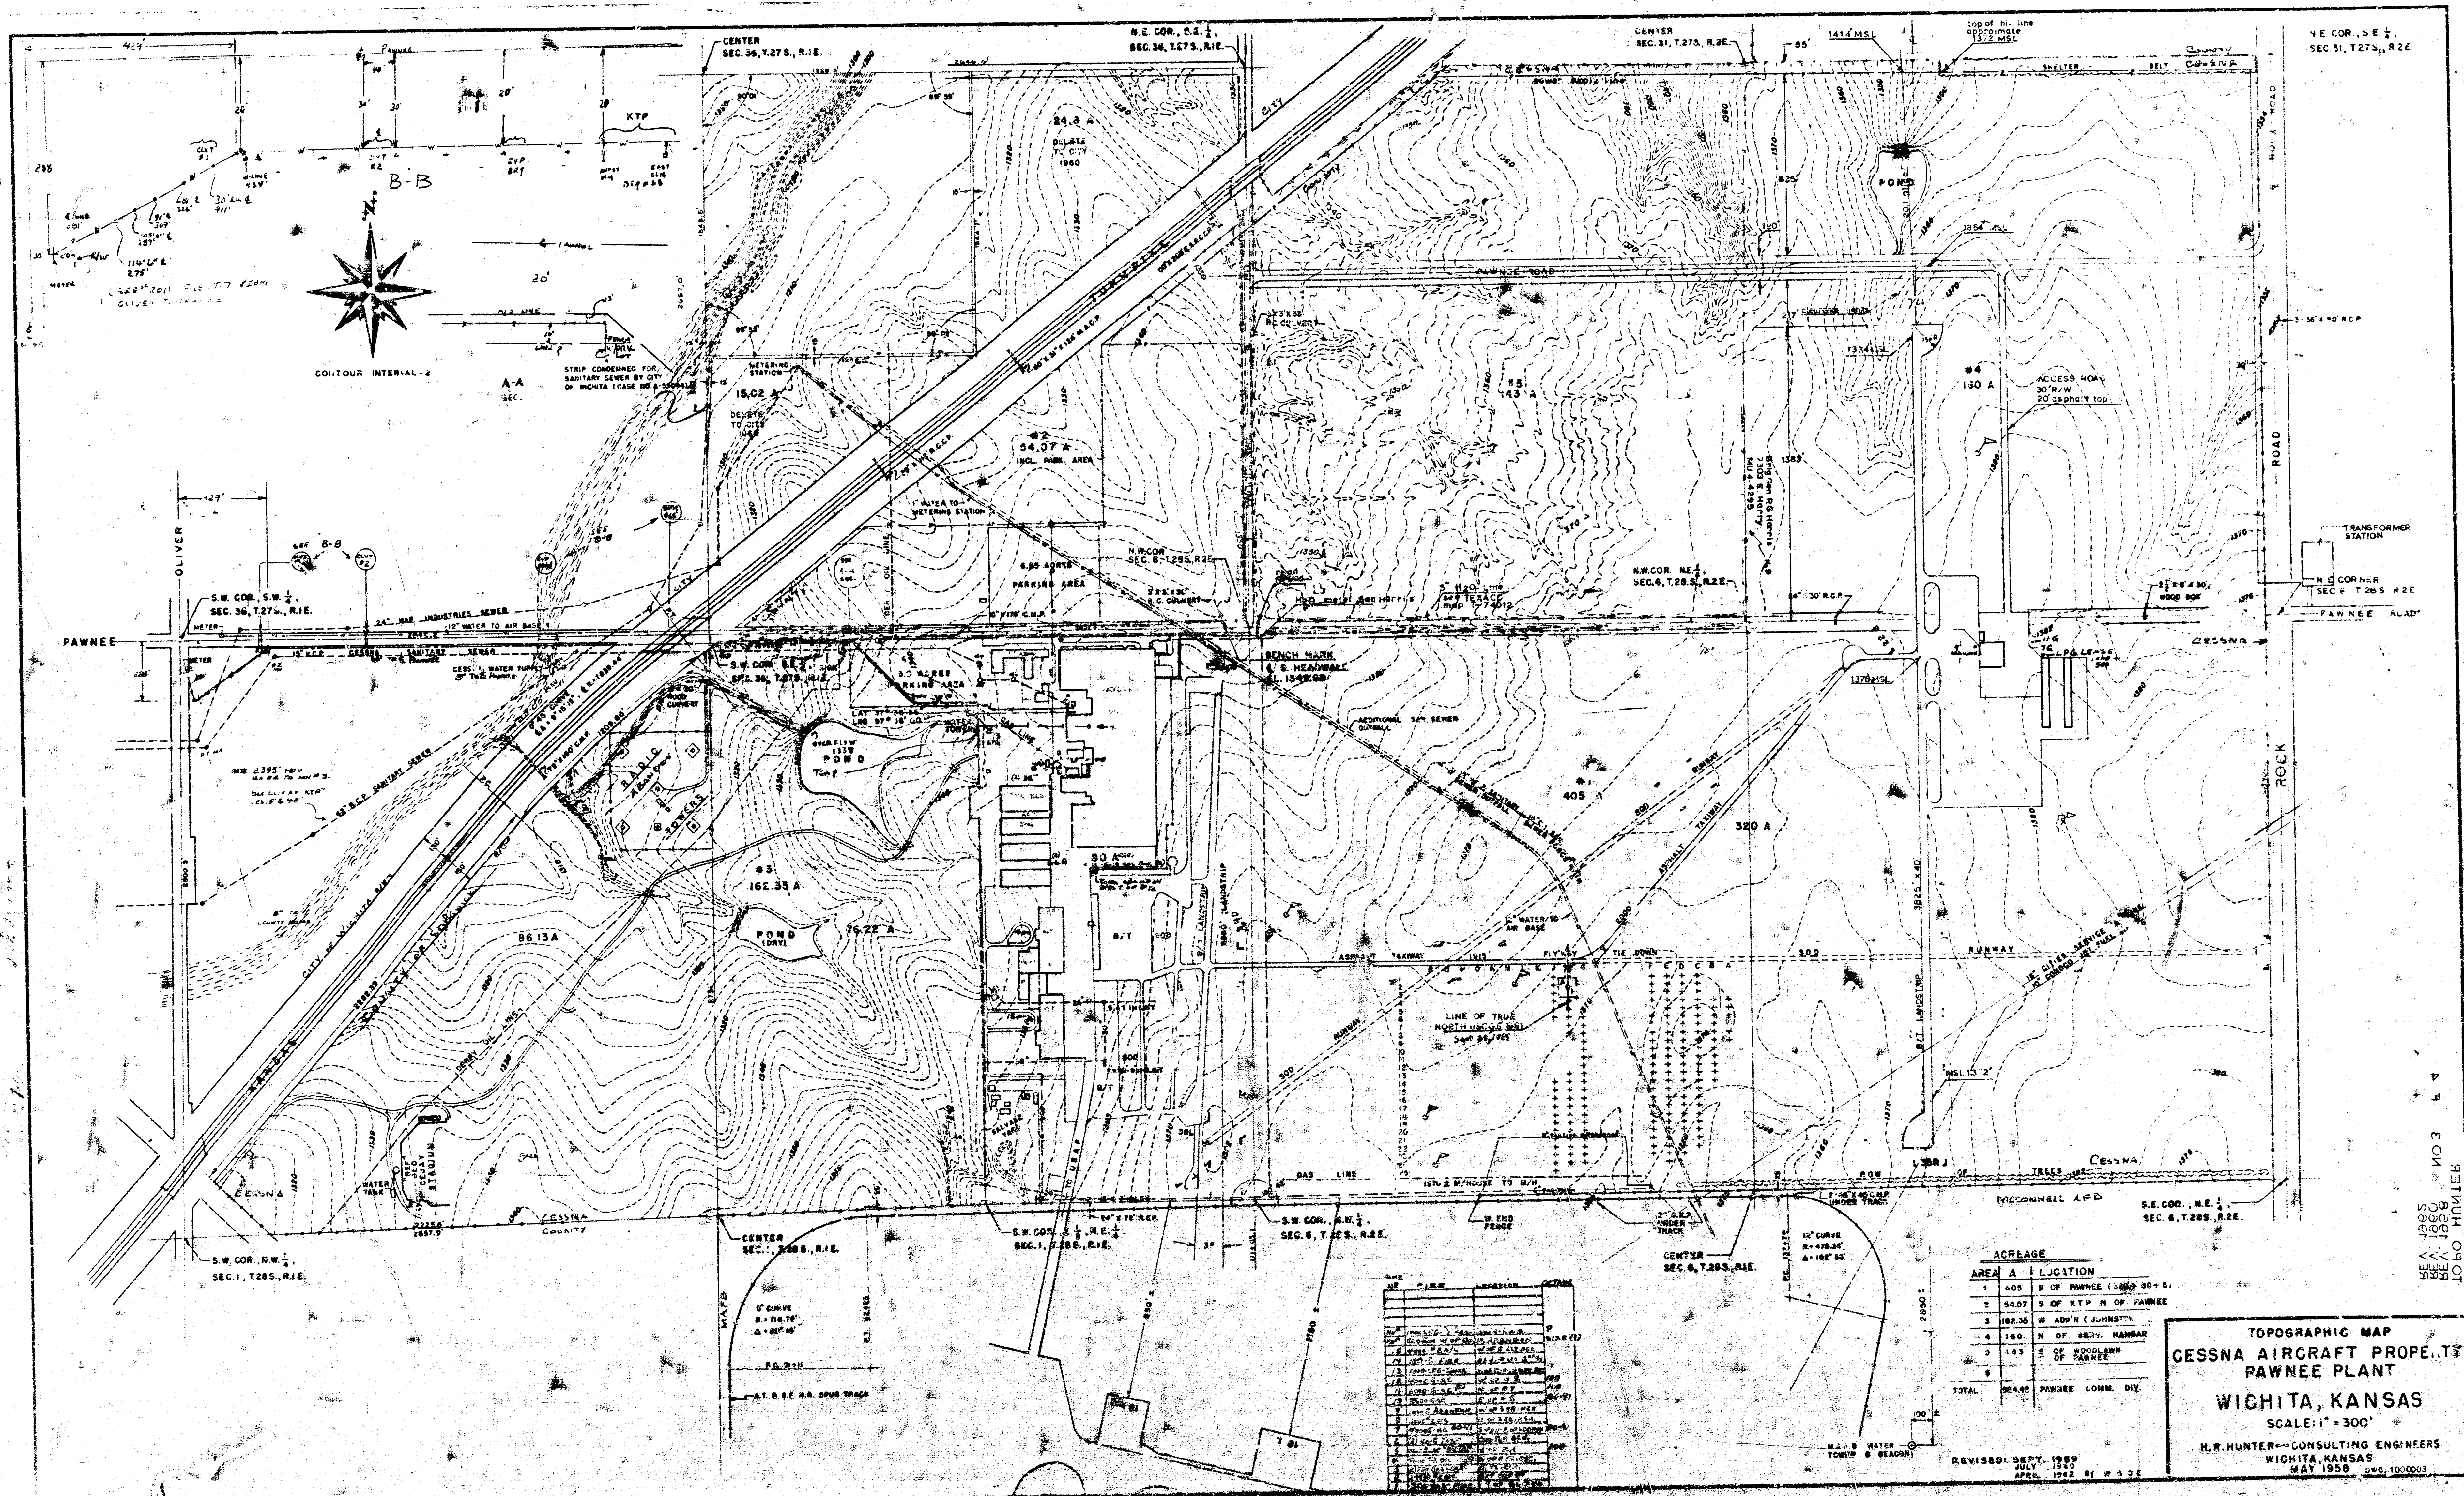

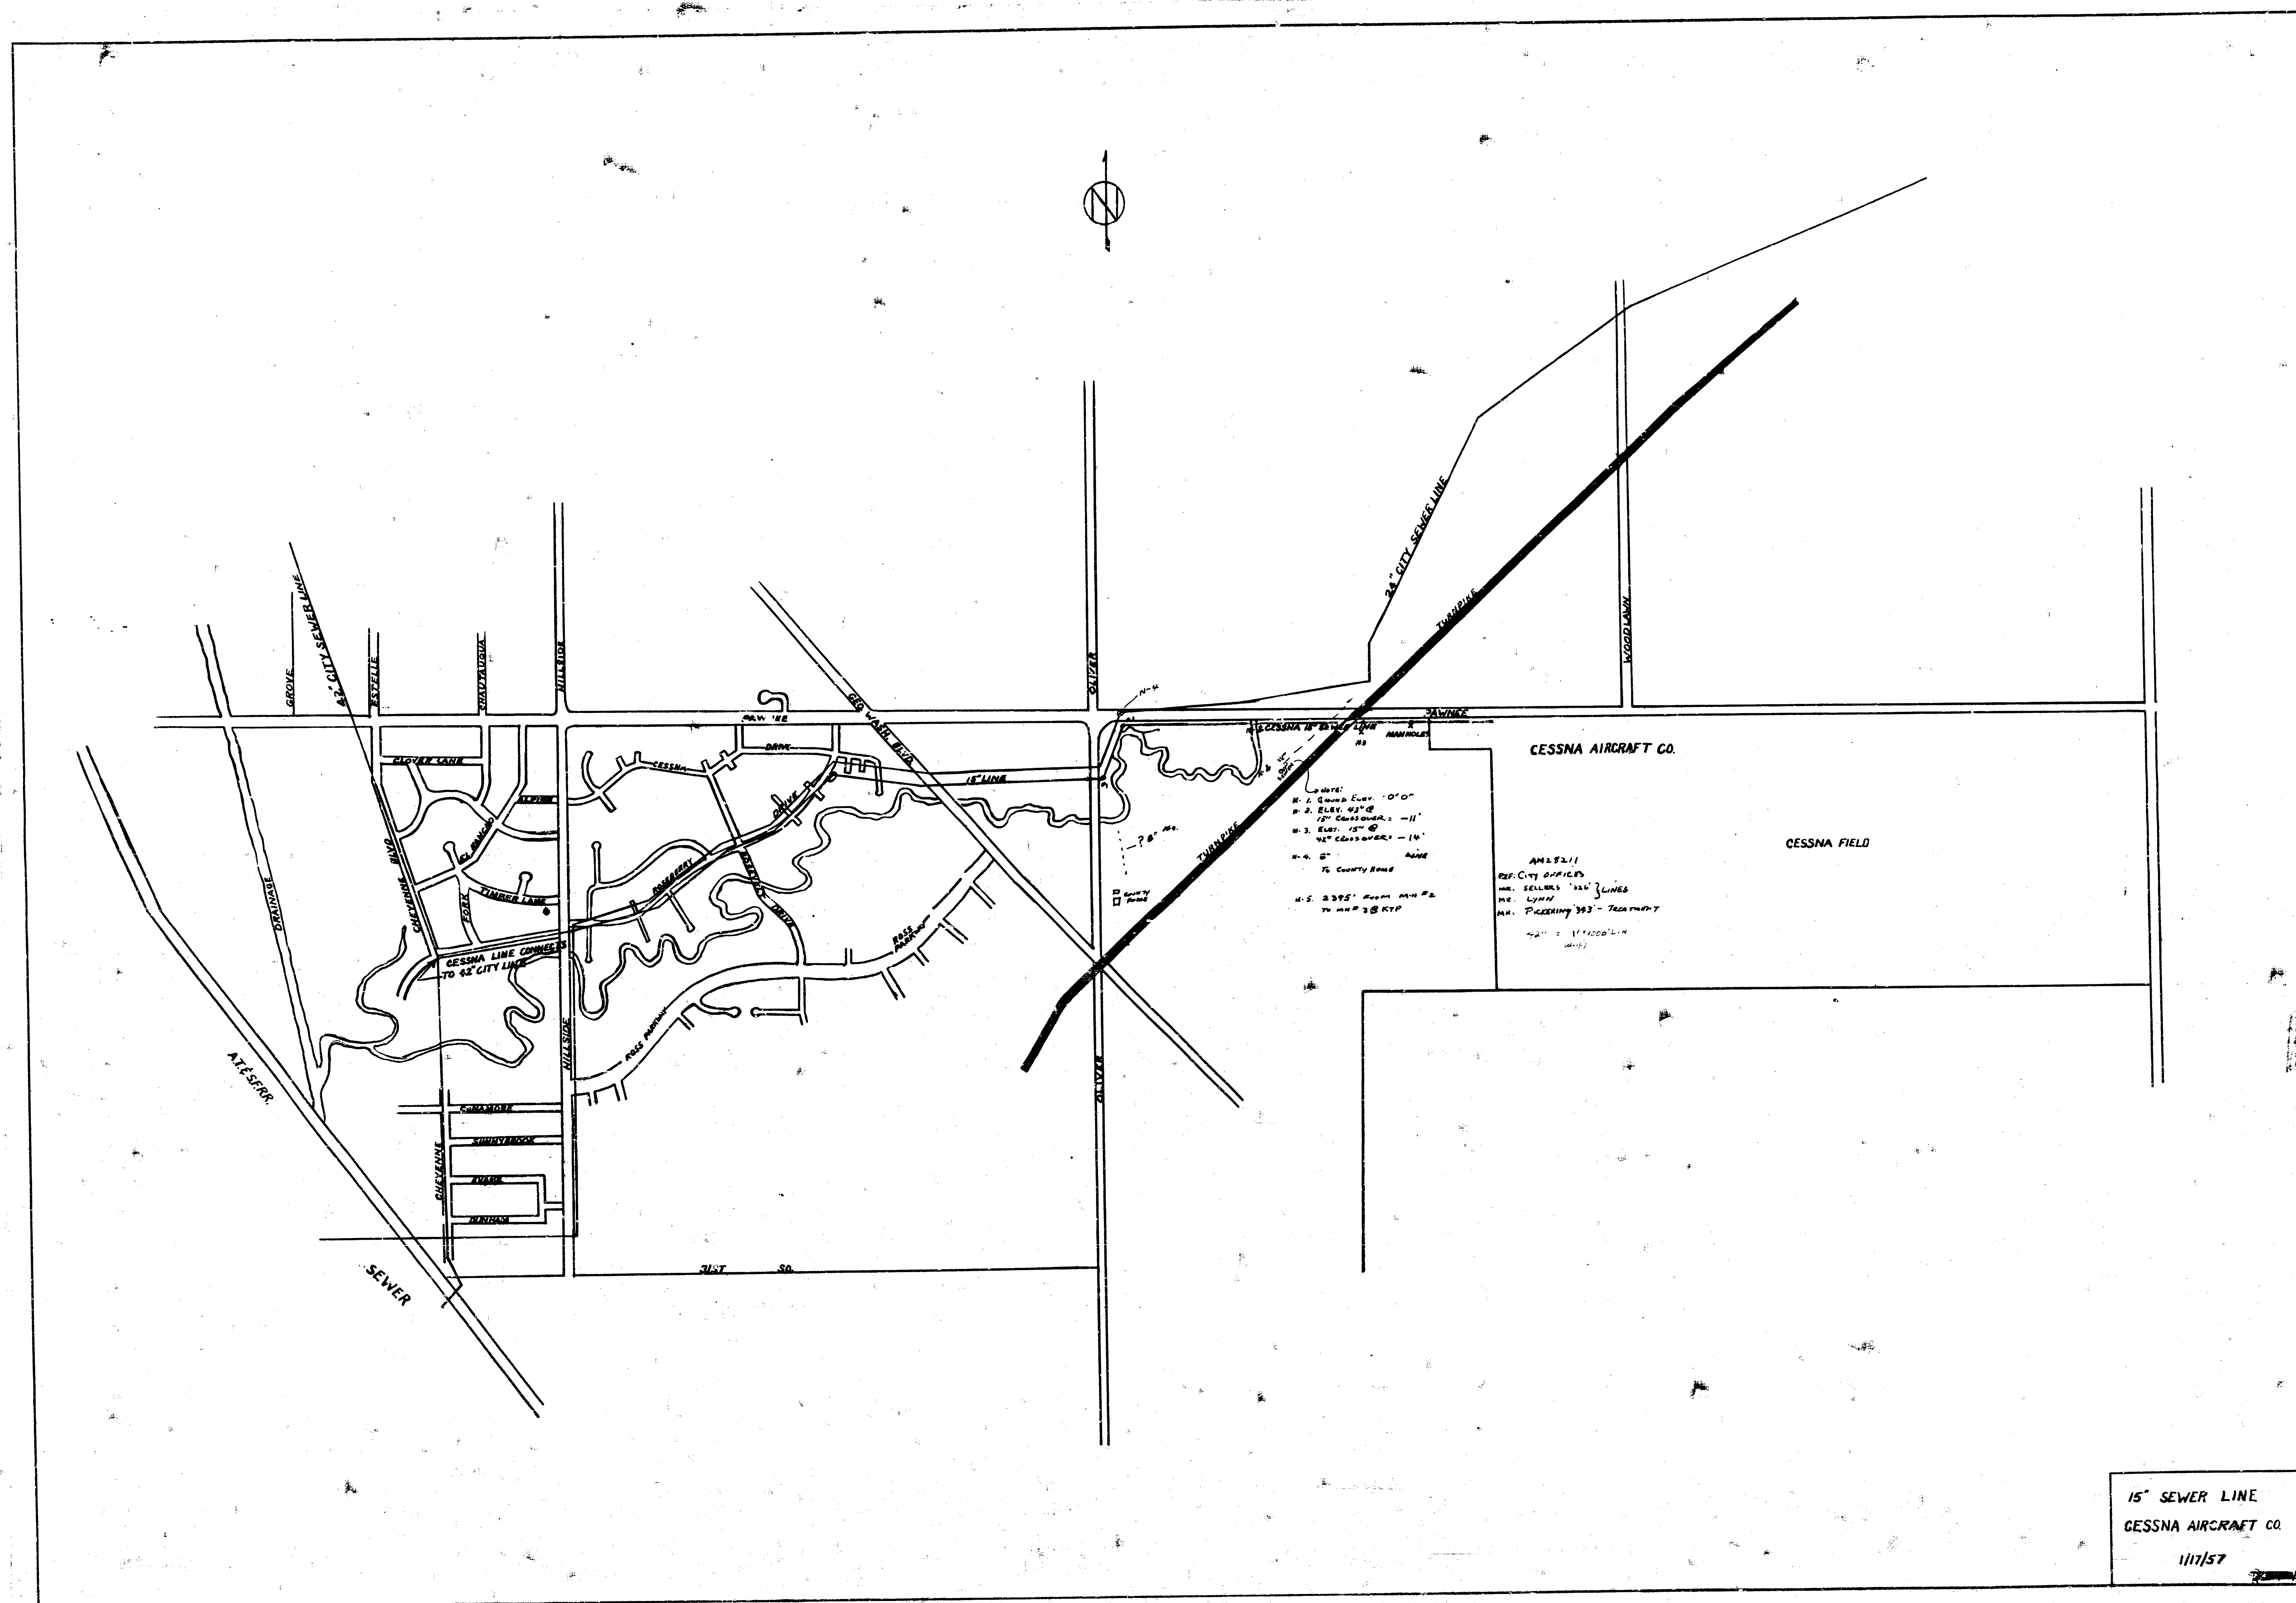

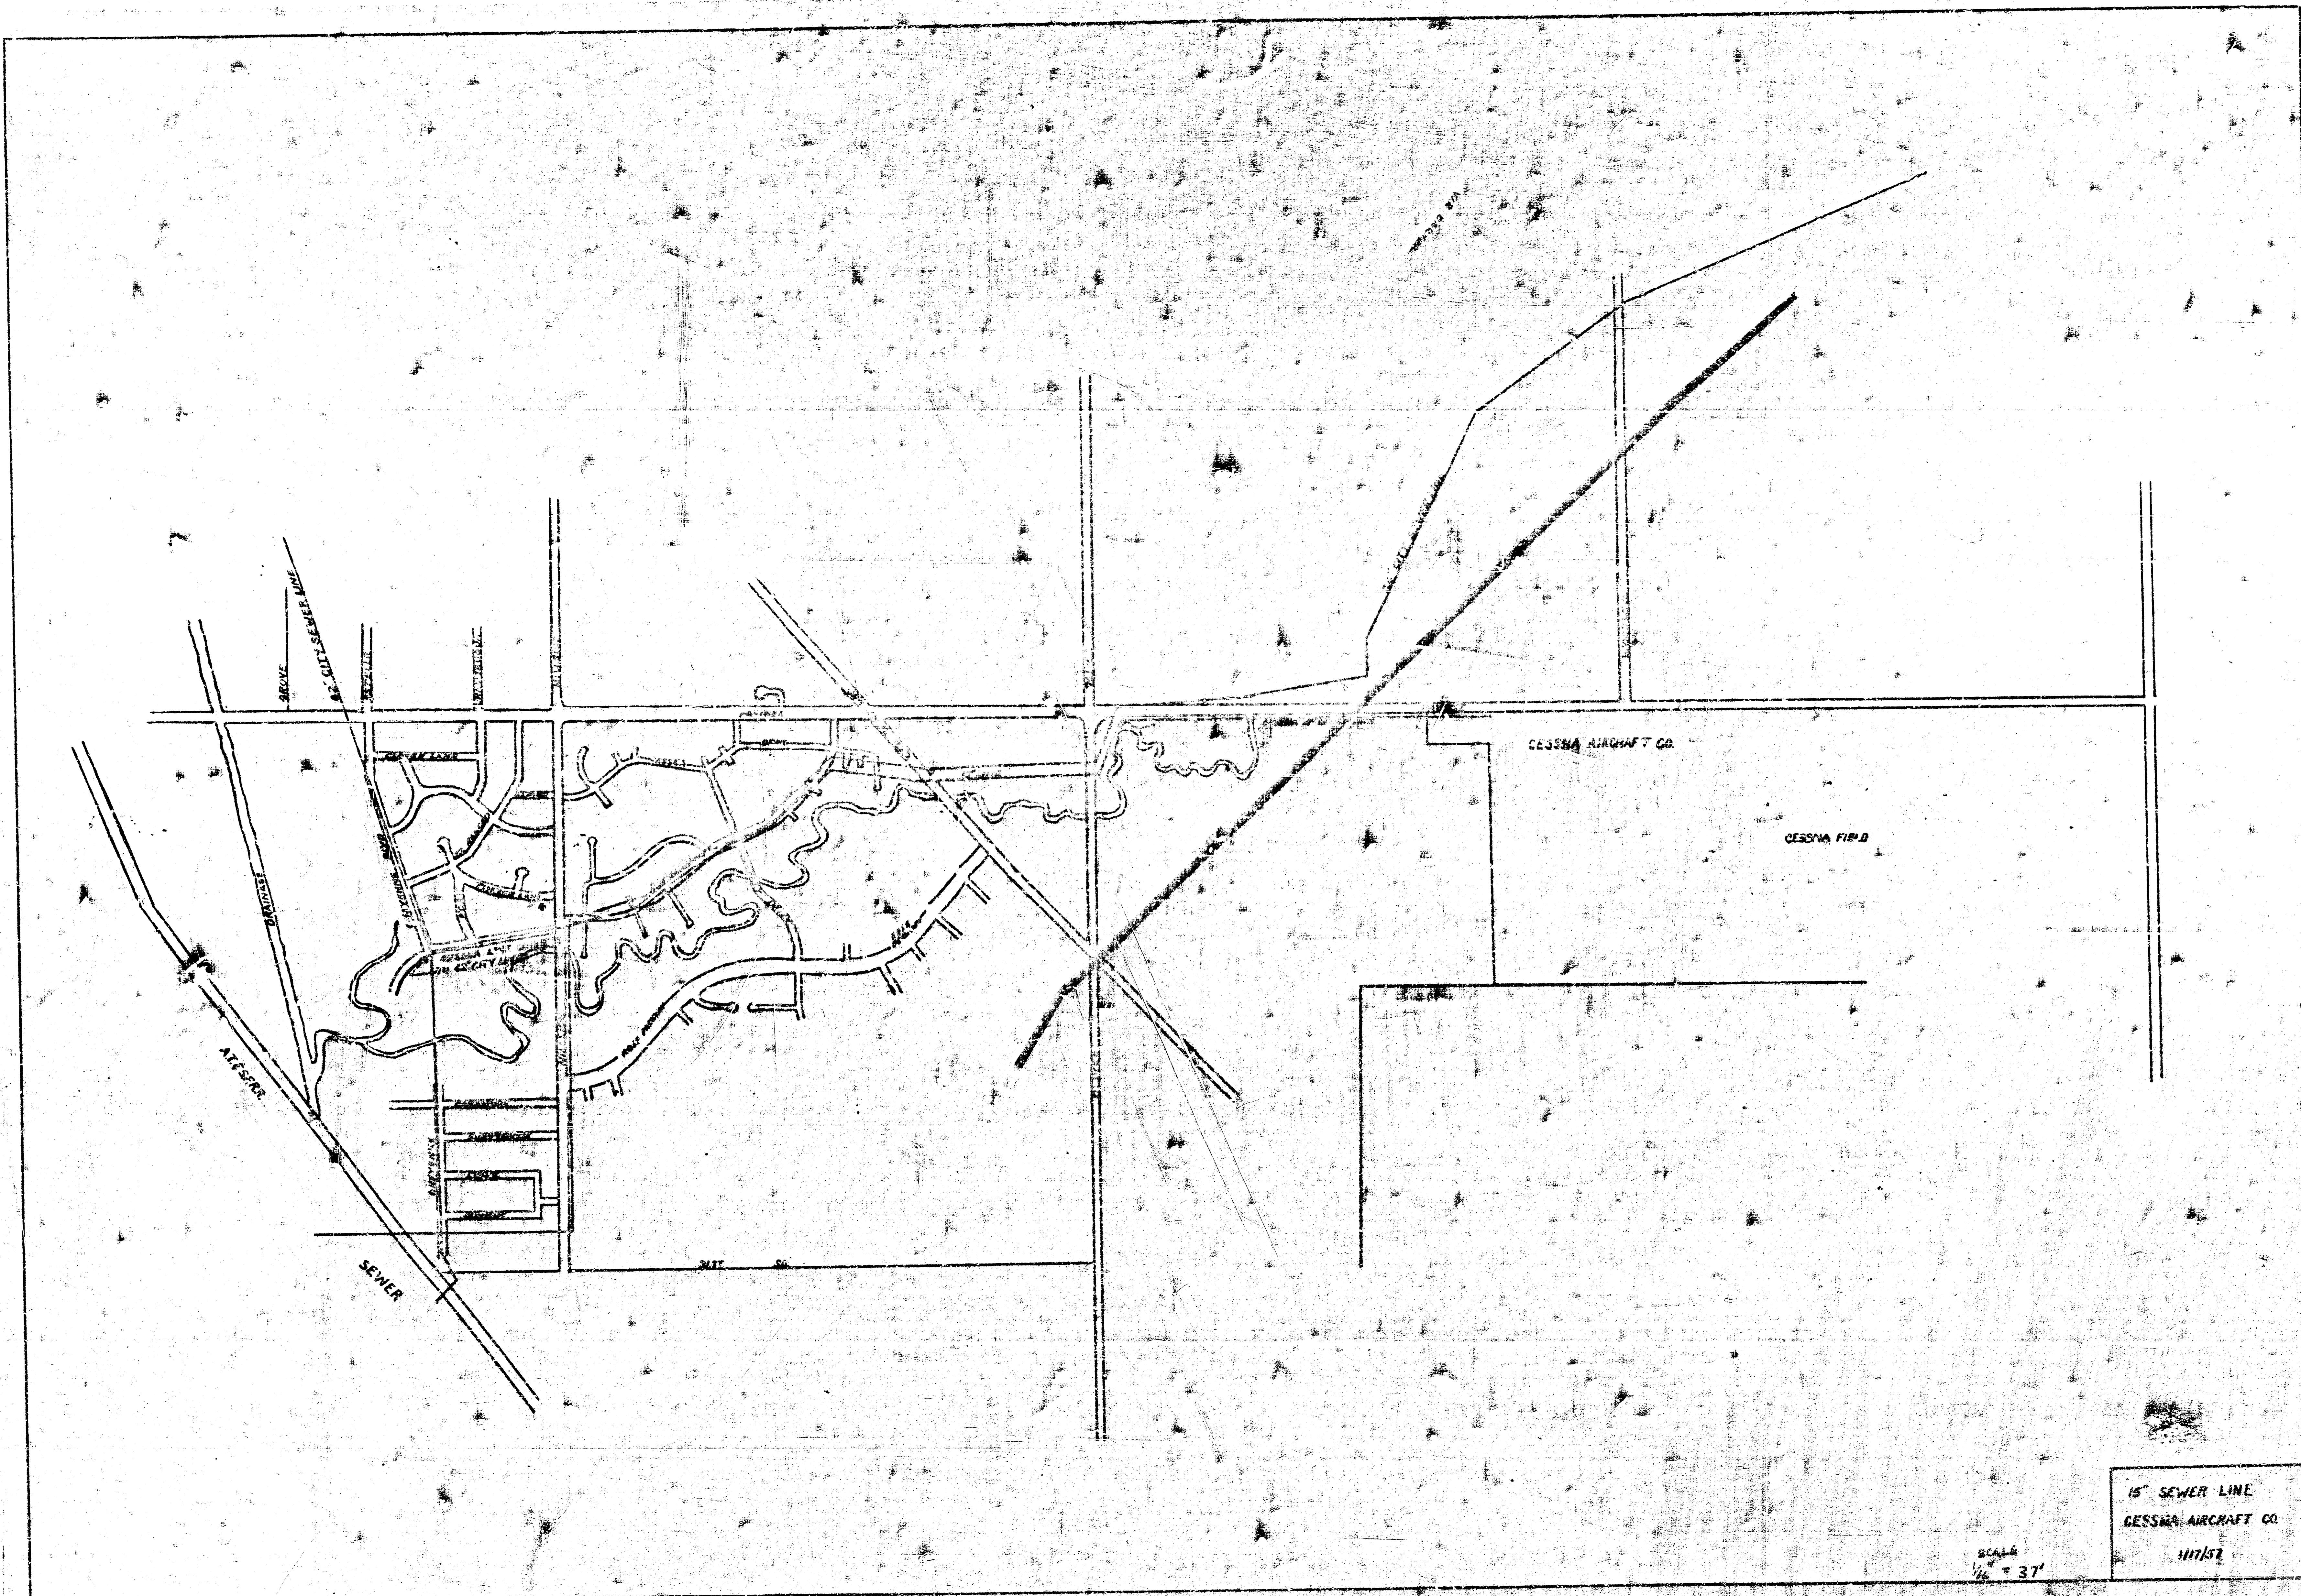

15" SEWER LINE
CESSNA AIRCRAFT CO.

SCALE
1/4" = 3'

SEWER LINE
WB CARTER
122 N. 1st St.
PC 3-5353
ON 2-5-53