


PLAN	DATE	BY
NOTED BY	DATE	BY
NOTED BY	DATE	BY

PROFILE	DATE	BY
NOTED BY	DATE	BY
NOTED BY	DATE	BY

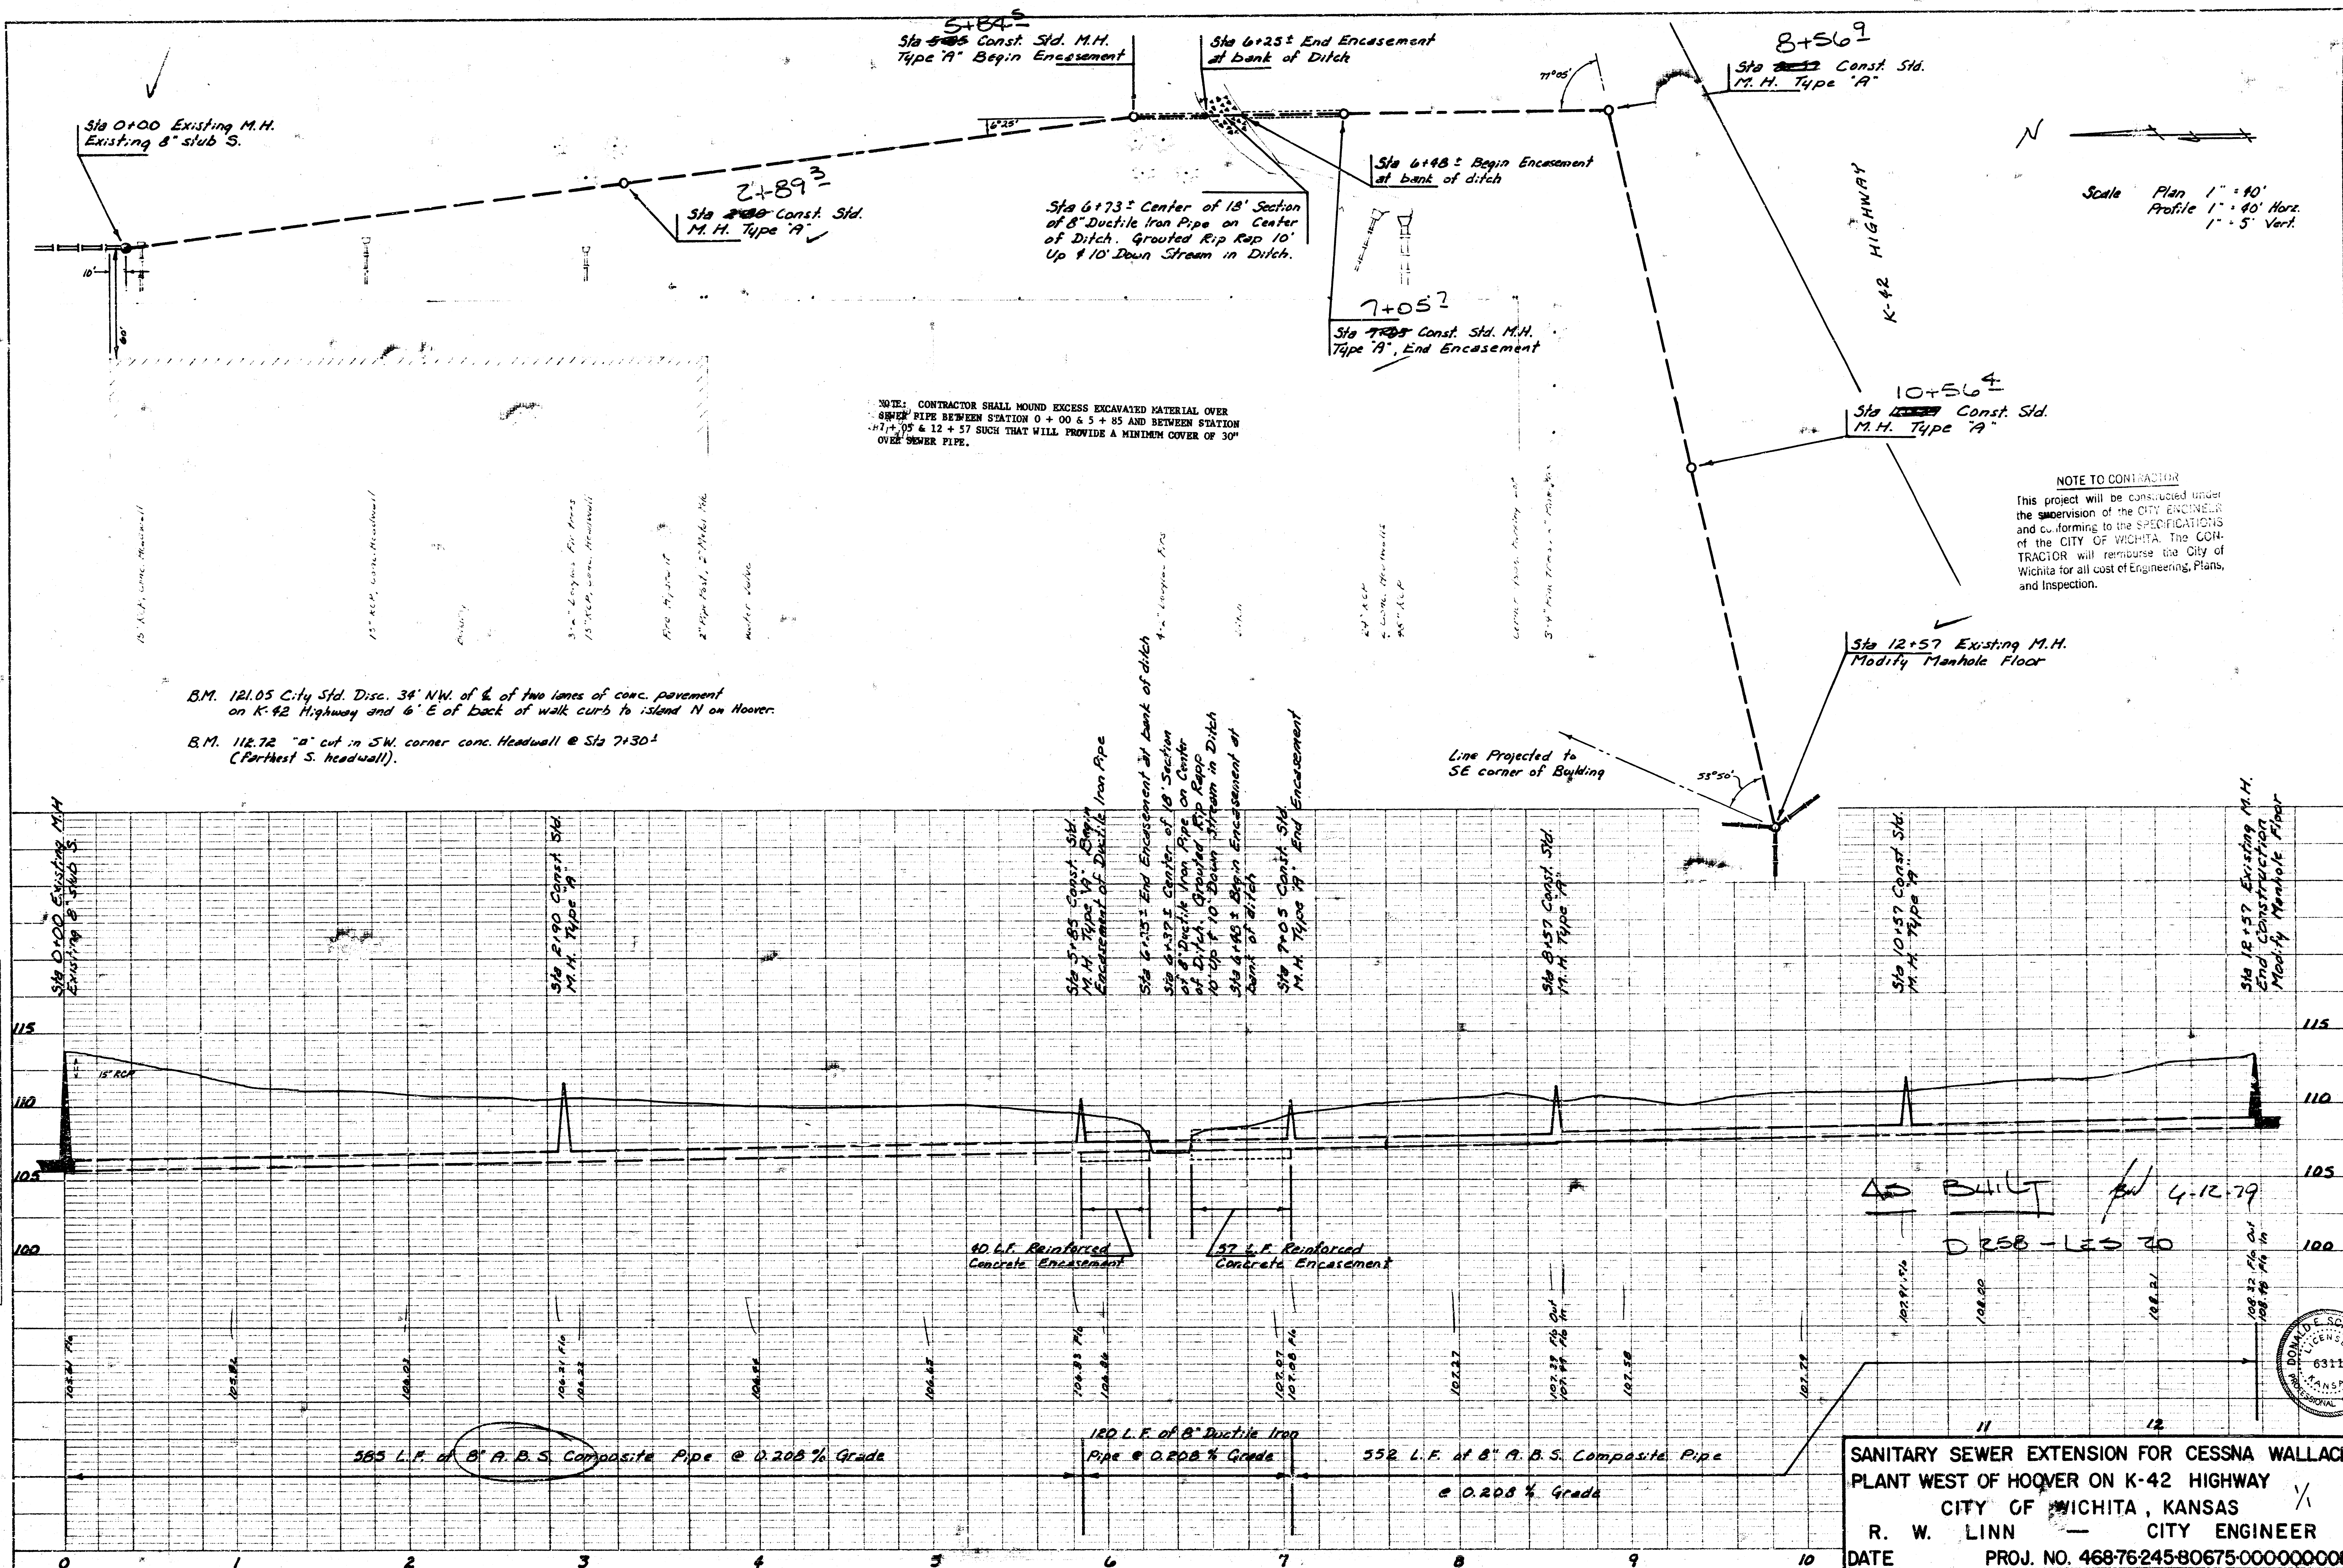

SANITARY SEWER EXTENSION FOR CESSNA WALLACE
PLANT WEST OF HOOVER ON K-42 HIGHWAY
CITY OF WICHITA, KANSAS
R. W. LINN — CITY ENGINEER
DATE PROJ. NO. 468-76245-80675-000000008

14 - e - 1 - 10