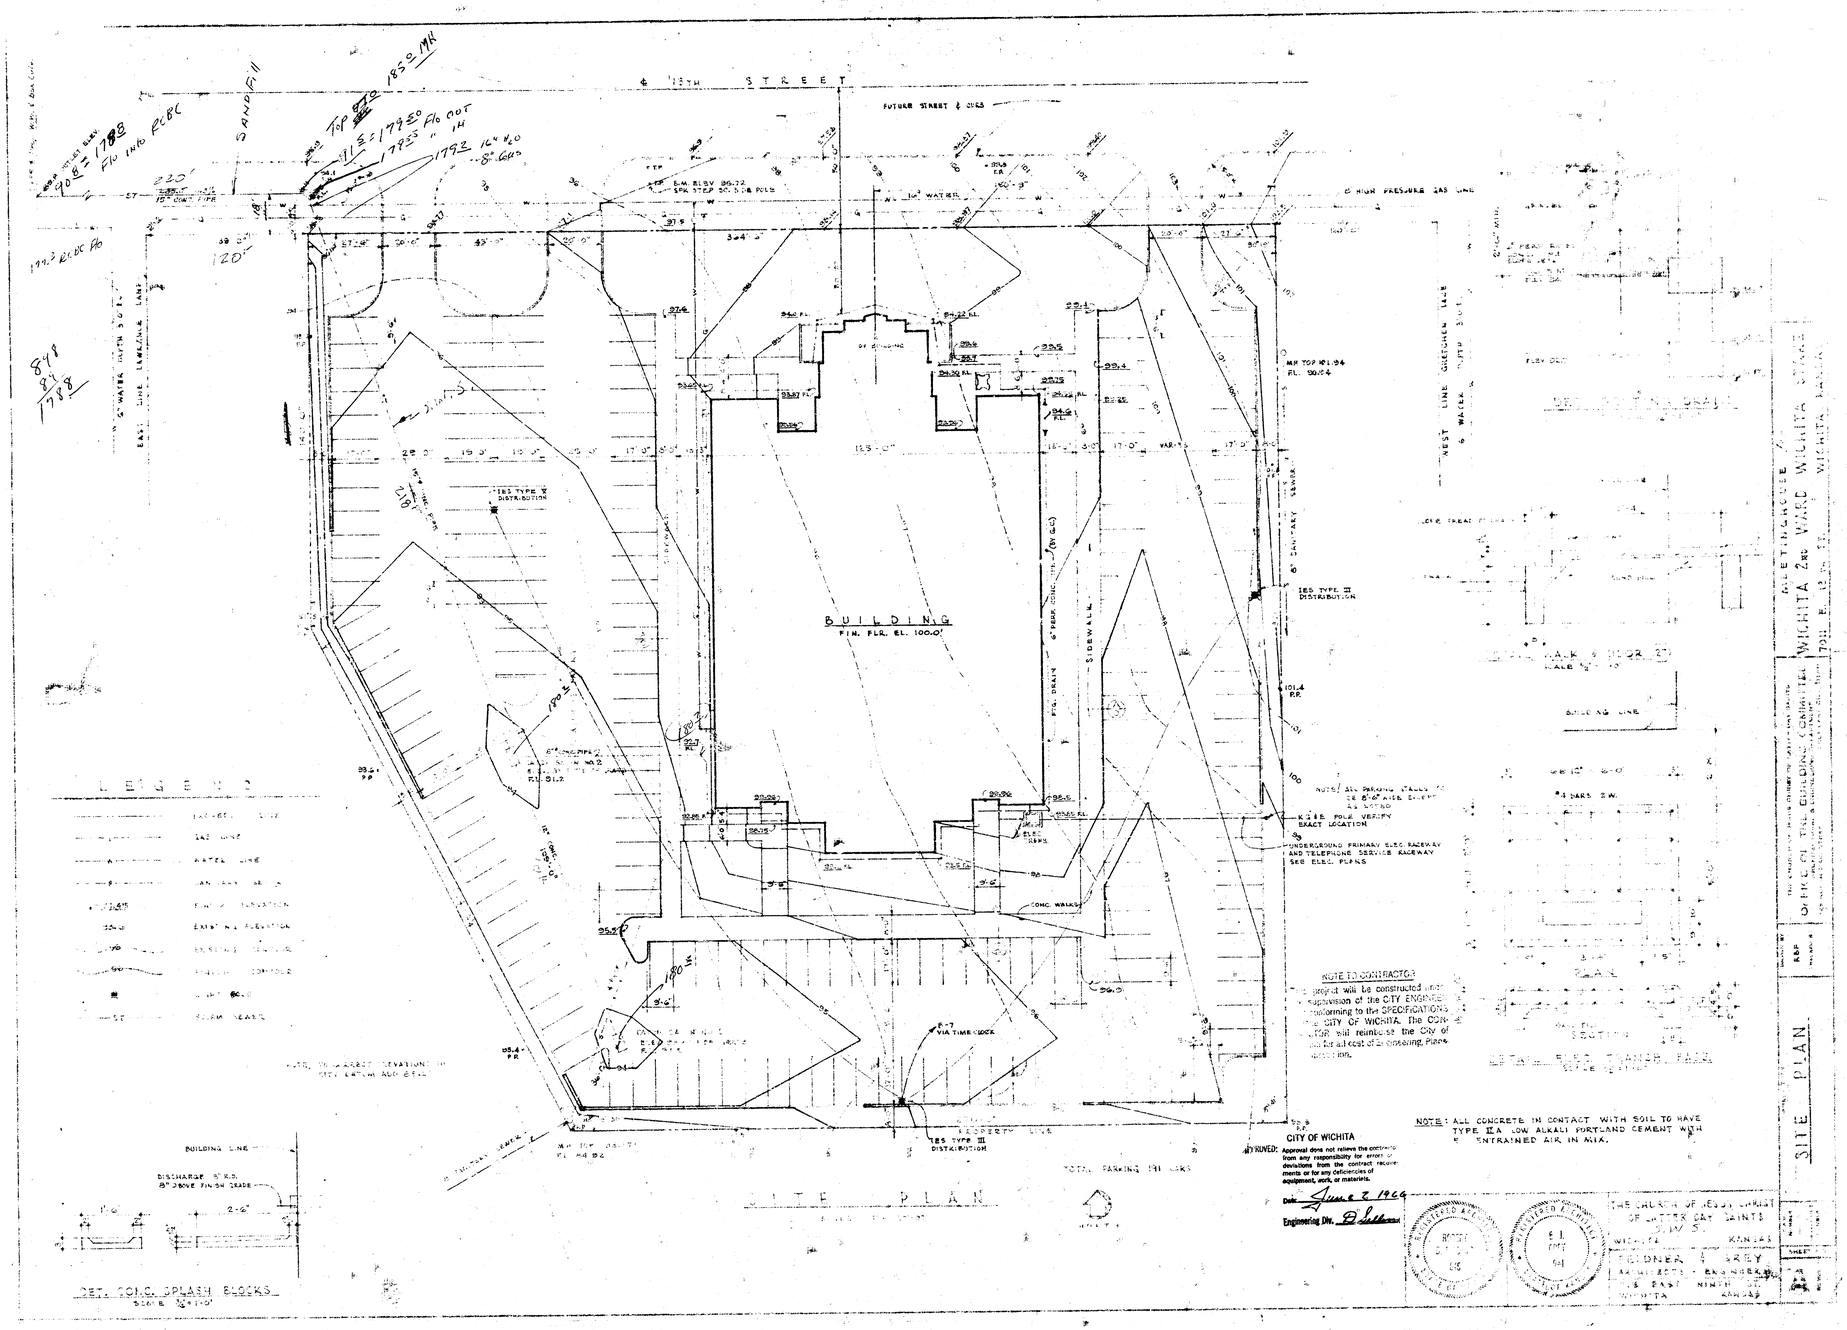
13TH STREET
BUILDING
FIN. FLR. EL. 100.0'
LEGEND
SITE PLAN
NOTE: ALL CONCRETE IN CONTACT WITH SOIL TO HAVE TYPE II A LOW ALKALI PORTLAND CEMENT WITH 5% ENTRAINED AIR IN MIX.
NOTE TO CONTRACTOR:
CITY OF WICHITA
Approval does not relieve the contractor from any responsibility for errors or deviations from the contract requirements or for any deficiencies of equipment, work, or materials.
Date June 2 1966
Engineering Div.
THE CHURCH OF JESUS CHRIST OF LATTER DAY SAINTS
WICHITA KANSAS
FEIDNER & GREY
ARCHITECTS - ENGINEERS
WICHITA KANSAS
SITE PLAN
DET. CONC. SPLASH BLOCKS