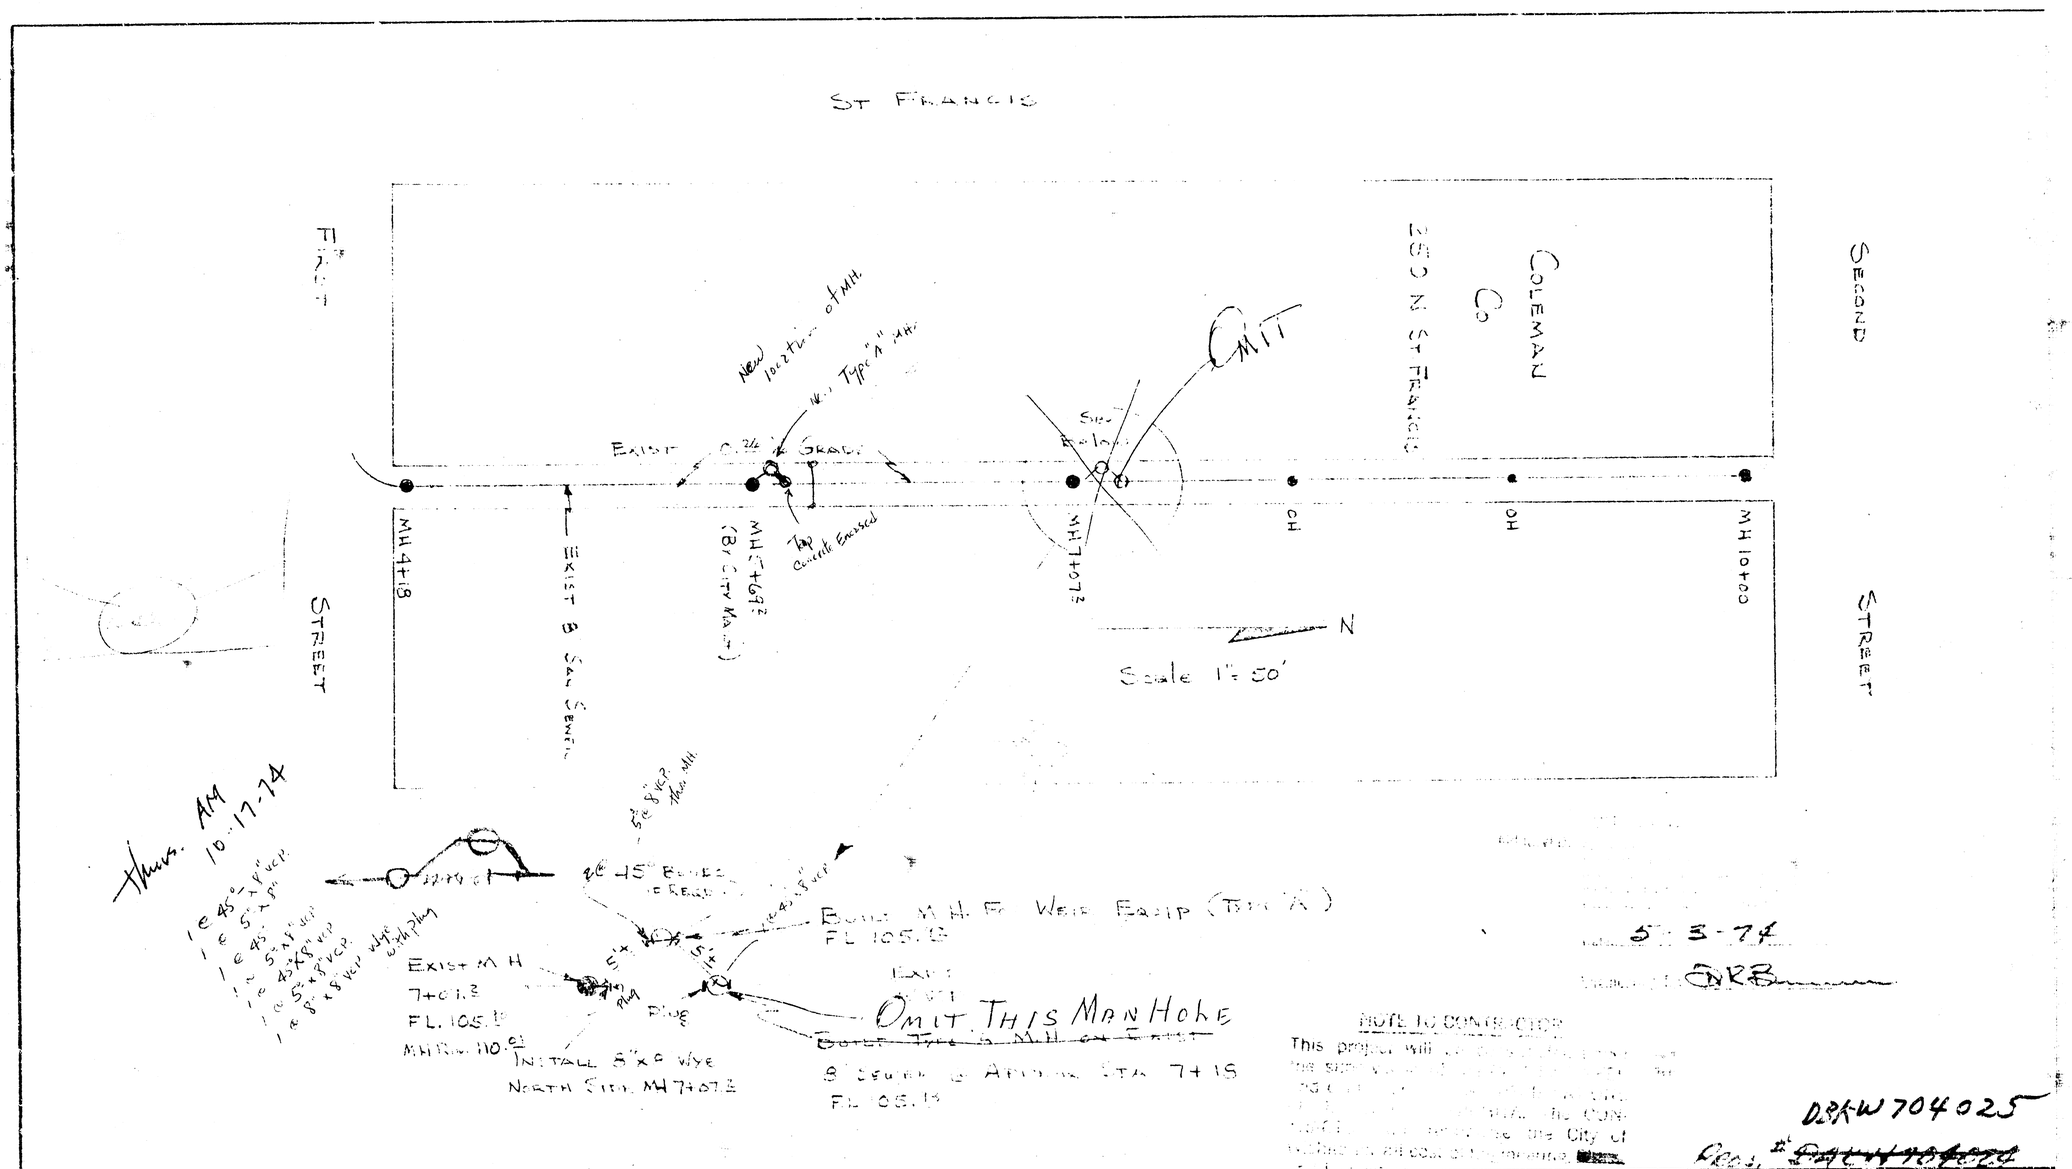

NOTE TO CONTRACTOR

This project will ... the City of ...

Sewer Flume For
Coleman Factory A
250 N St Francis
Mid-States
May-1974