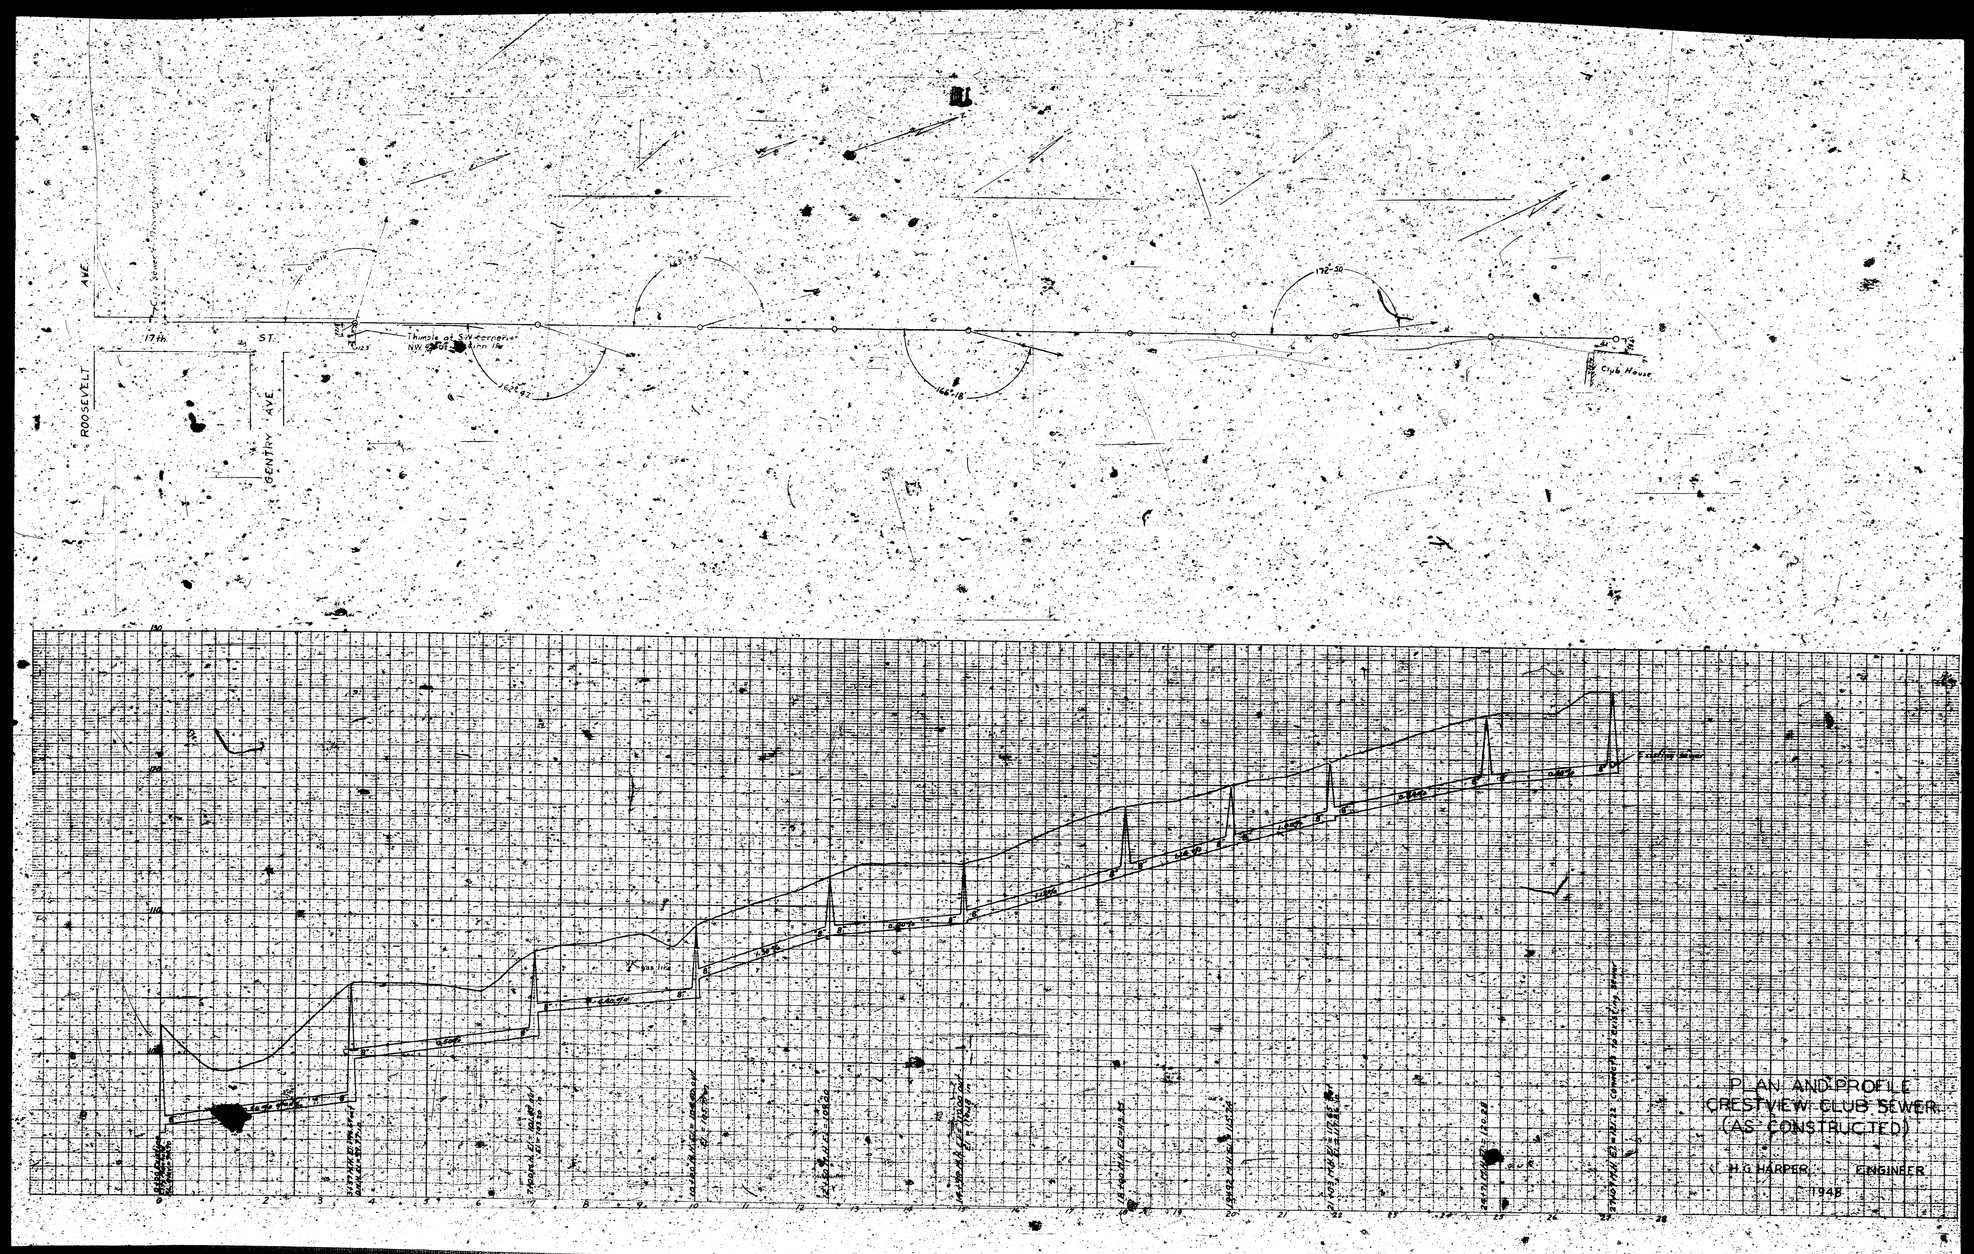
ROOSEVELT AVE.
17th ST.
GENTRY AVE.
Thimble at SW corner of NW quadrant Kern Inn
Club House
PLAN AND PROFILE
CRESTVIEW CLUB SEWER
(AS CONSTRUCTED)
H.G. HARPER, ENGINEER
1948