B.M. 169.49 CHISELED SQUARE ON CENTERLINE CONCRETE PAVEMENT SOUTH SLAB K-42 AND WEST LINE WEST STREET.

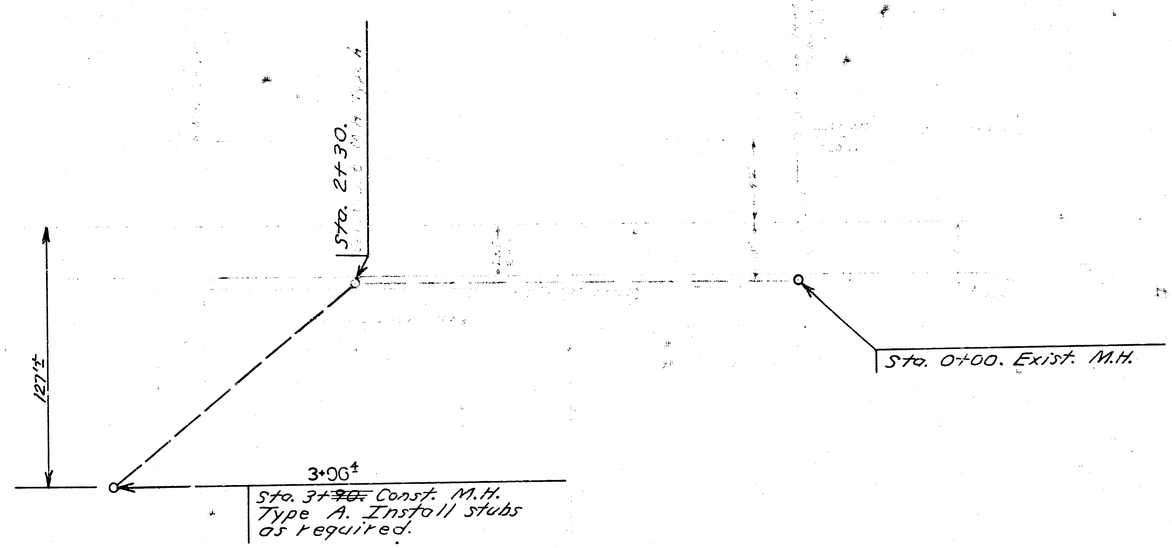

NOTE: EXACT LOCATION OF MANHOLE AT STA. 3+90 IS TO BE DETERMINED BY OWNER. CONCRETE ENCASEMENT WILL BE REQUIRED UNDER THE DRAINAGE DITCH BEGINNING FROM MANHOLE AT STA 2+30 IF COVER OVER SEWER IS LESS THAN 30".

Rev. 10-26-73

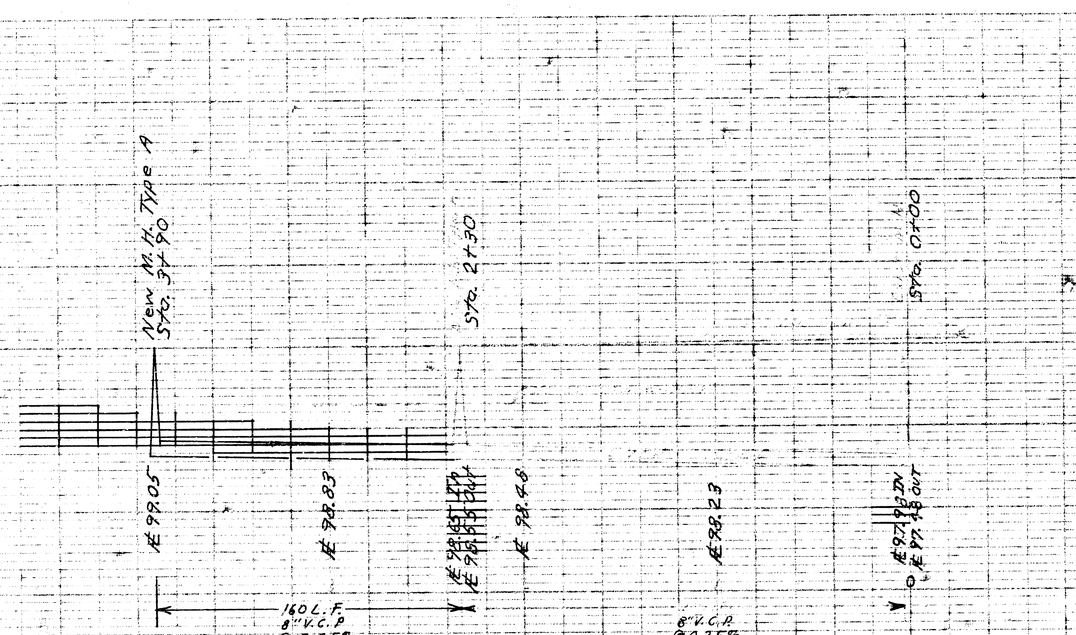

AS BUILT X-VAR MEASUREMENTS
S.S. 4/13