

LOT #1 DIAMOND SECOND ADDITION
TO WICHITA, SEDGWICK COUNTY, KS

450.0 ±

UTILITY EASEMENT

DRIVE
PARKING

50' MOBILE UNIT - 30' x 40'

EXISTING
SWIMMING
POOL

NOTE: STUBS TO BE INSTALLED IN MANHOLES AS
REQUIRED TO FACILITATE CONNECTION OF 6" OR
4" BUILDING LINES TO MANHOLES.

NORTH

SCALE:
1" = 50'

5-12-76
APPROVED AS NOTED
By CITY ENGINEER OF WICHITA
Sanitary Sewers O.E.S.
Storm Sewers _____
Driveway Approaches _____

NOTE TO CONTRACTOR
This project will be constructed under
the supervision of the CITY ENGINEER
and conform to the SPECIFICATIONS
of the CITY OF WICHITA. The CON-
TRACTOR will reimburse the City of
Wichita for all cost of ~~materials~~
and inspection.

EXISTING PROPERTY LINE

MOTEL UNIT - UNIT 1

PARKING

ELEC.
TEL.
MUSIC

NH 3

NH 2

NEW 8" SEWER

EXIST.
MH.

SWIMMING
POOL

EXISTING MOTEL
UNIT 2

EXISTING 8" SEWER

PARKING

PARKING

RESTAURANT

OFFICE

PARKING

PROPERTY LINE

MEETING
ROOM



PARKING

PROPERTY LINE 447.1 ±

EL. 98.4
EL. 98.2

1/2" HIGHWAY 54

PLAN DIAMOND MOTOR INN

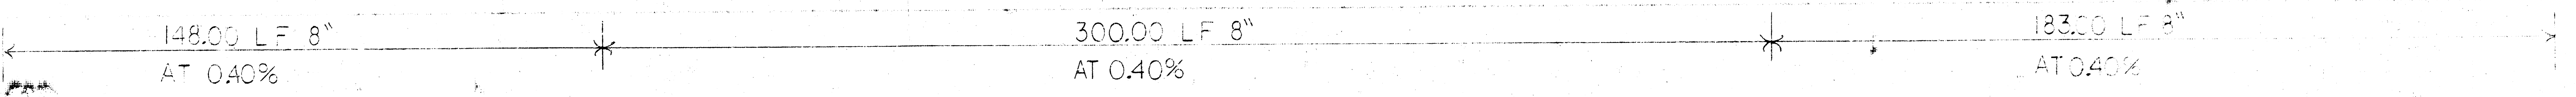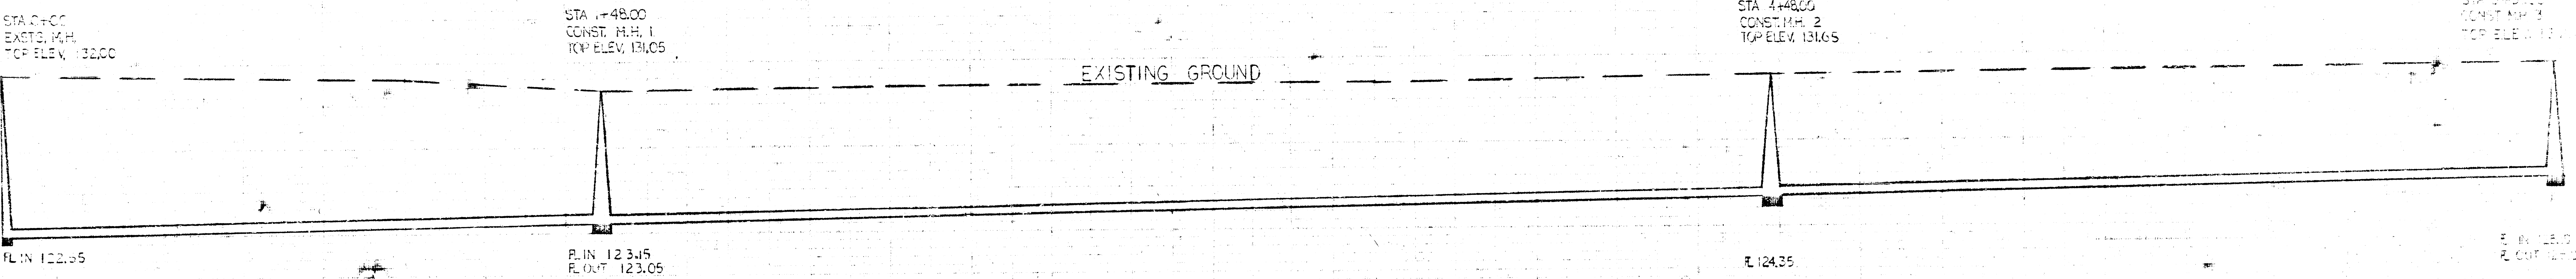

SCALE:
HORIZ. 1"=20'
VERT. 1"=8'

