

Project No. 463-76-245-80001-000-000-022

Location Map
(NO Scale)

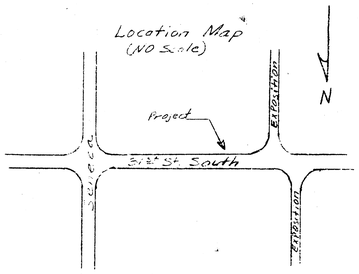

N

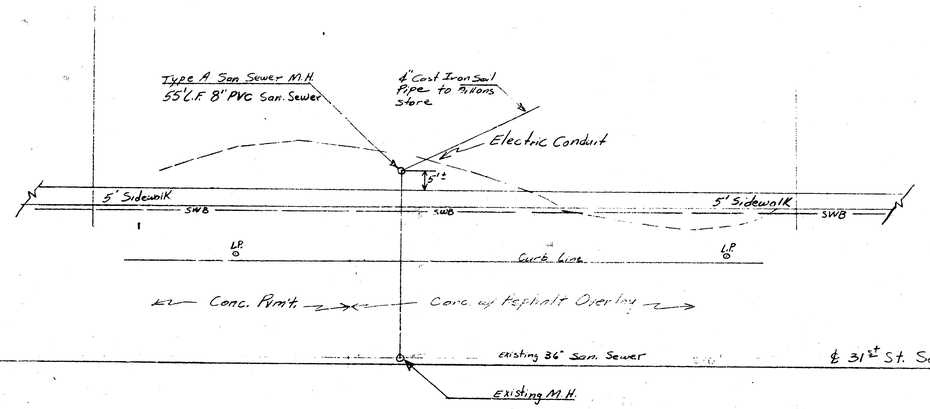

℄ EXPOSITION

APPROVED AS NOTED
By CITY ENGINEER OF WICHITA
Sanitary Sewers 6-20-85
Storm Sewers
Driveway Approaches
Water Mains
Curbing

N

NOTE TO CONTRACTOR

This project will be constructed under the supervision of the CITY ENGINEER and conforming to the SPECIFICATIONS of the CITY OF WICHITA. The CONTRACTOR will pay the City of Wichita for all costs of plan revise, inspection and backing per contract.

Scale :
1" = 50' Horizontal
1" = 5' Vertical

PLAN
SURVEYED
PLOTTED
ALIGNMENT CHECKED
BY CO WAY CHECKED
NOTE BOOK
NO.
BY
DATE

PROFILE
SURVEYED
PLOTTED
CHECKED
BY CO WAY CHECKED
NOTE BOOK
NO.
STRUCTURE NOTATIONS LISTED
BY
DATE

98.0
96.0
94.0
92.0
90.0
88.0
86.0

55 L.F. 8" PVC

Existing M.H.

Private Sanitary Sewer Extension to 8" Line
Dillons Store at 31st St. and Exposition
Project No.
463-76-245-80001-000-000-022
Wildcat Construction Company Inc.
6621 West Harry Wichita, Ks

PLATE 1 - PLAN - PROFILE - F.A.S.
CLEARPRINT PAPER CO., S. F. CAL.
NO. 1000H-1

16 June 1985

AT 5 3 1