9-22-75

APPROVED AS NOTED
By CITY ENGINEER OF WICHITA
Sanitary Sewers D.E.S.
Storm Sewers
Driveway Approaches

NOTE TO CONTRACTOR

This project will be constructed under the supervision of the CITY ENGINEER and conforming to the SPECIFICATIONS of the CITY OF WICHITA. The CONTRACTOR will reimburse the City of Wichita for all cost of Engineering, Plans, and Inspection.

WYES
0+59 E 6"
1+10 W 4"
1+67 E 6"
2+05 W 6"

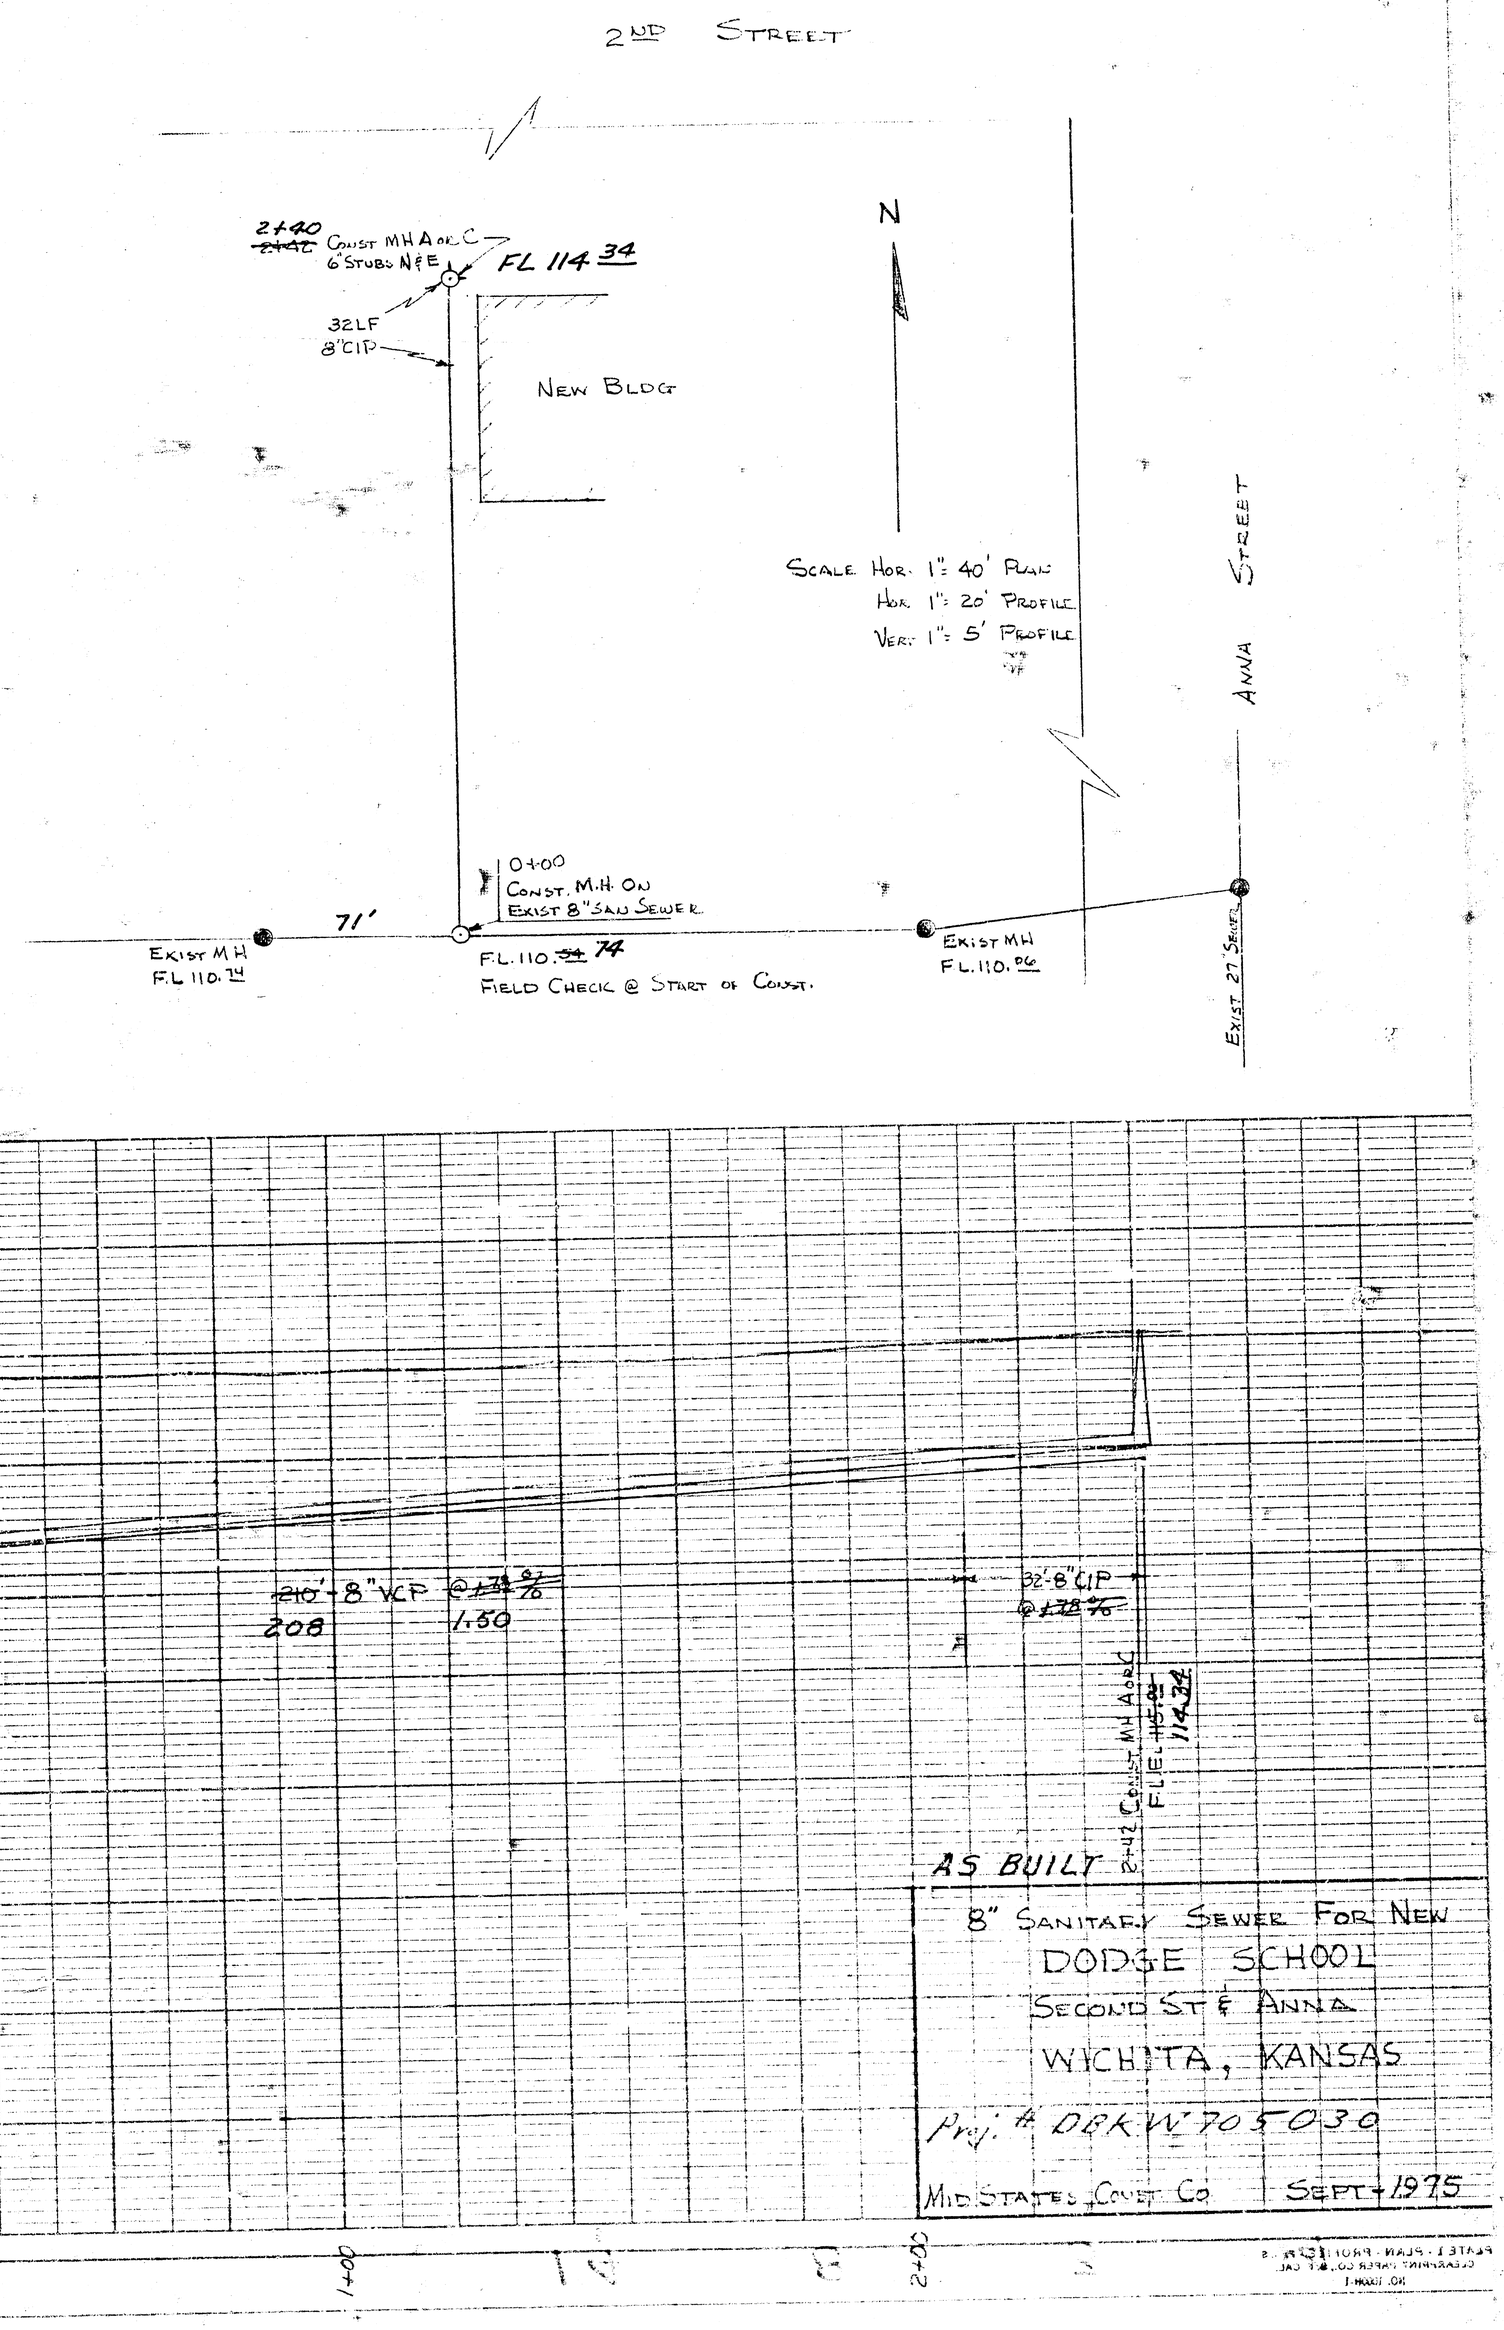

AS BUILT

8" SANITARY SEWER FOR NEW
DODGE SCHOOL
SECOND ST & ANNA
WICHITA, KANSAS

Proj. # DRKW 705030

MID STATES CONST. CO. SEPT. 1975