


WYE BRANCH
SEWER DISTRIBUTION SYSTEM
FOR
EASTBOROUGH ESTATES
SCALE 1"=50'
CONT'D

DON C. MOEHLER
CONSULTING CIVIL ENGINEER
WICHITA, KANSAS

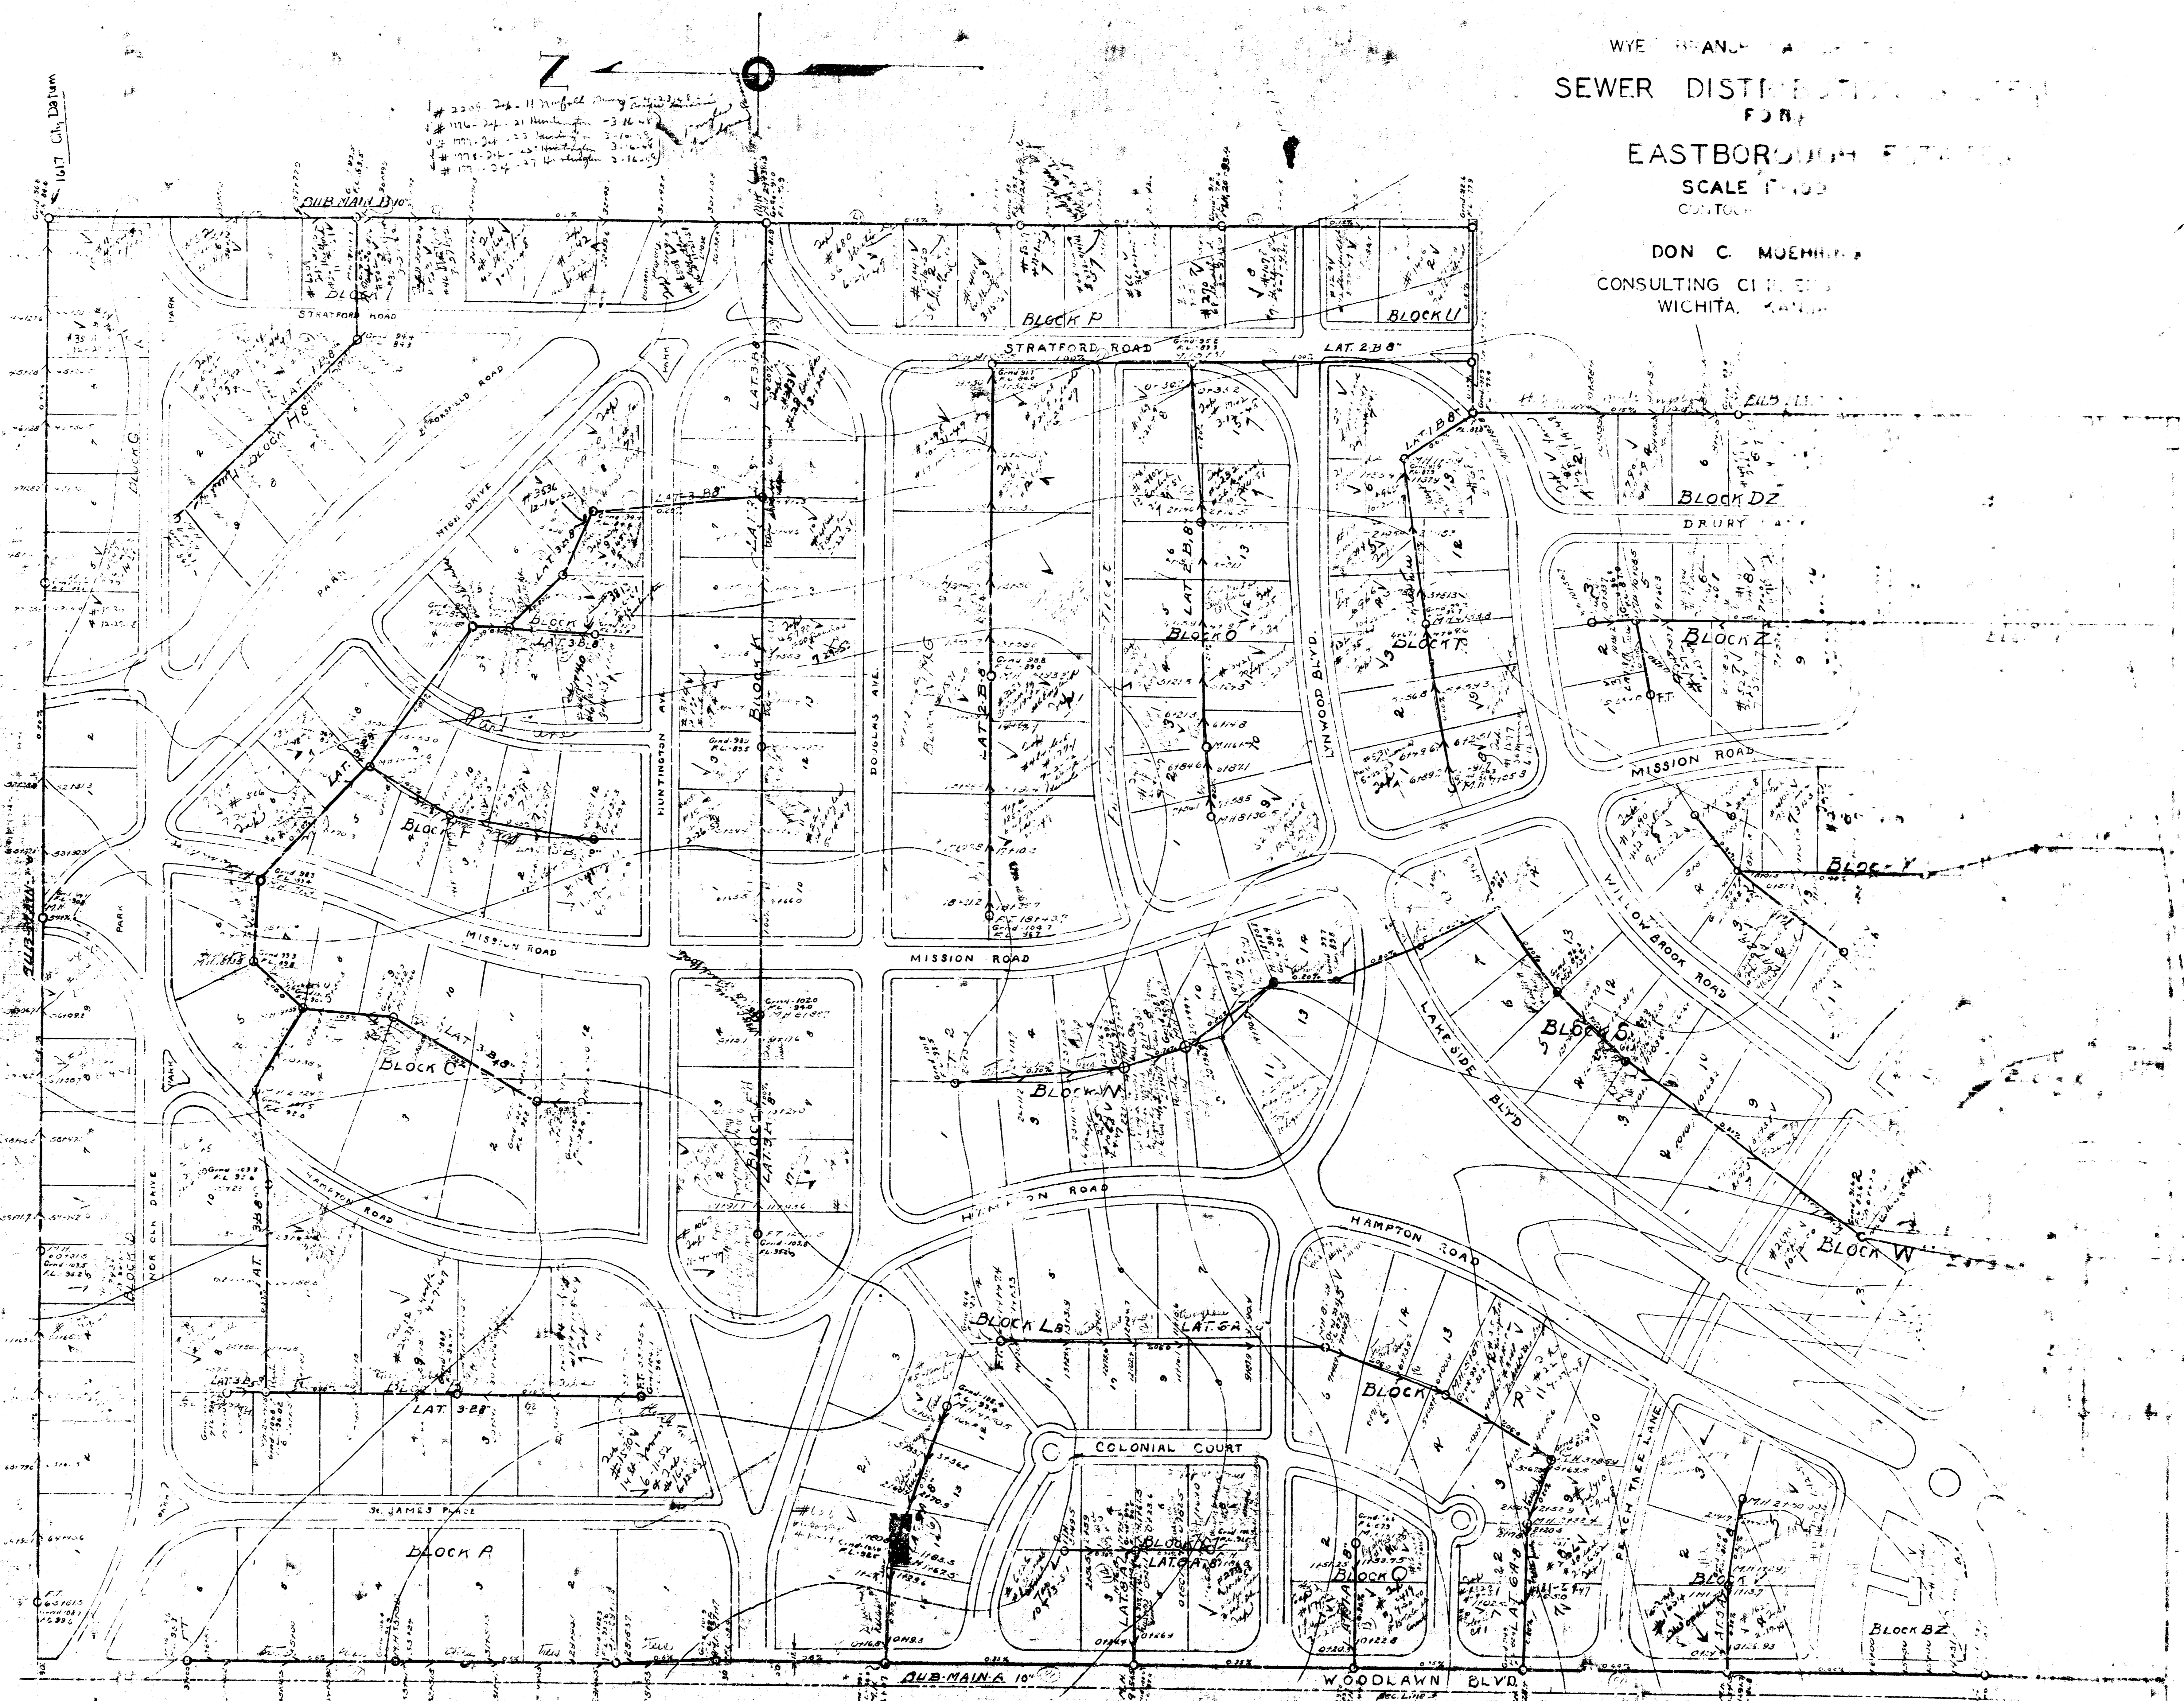

2304 24-11 11/10/47
176-24-21 11/10/47
177-24-23 11/10/47
178-24-25 11/10/47
179-24-27 11/10/47

118-24-67 11/10/47
119-24-69 11/10/47