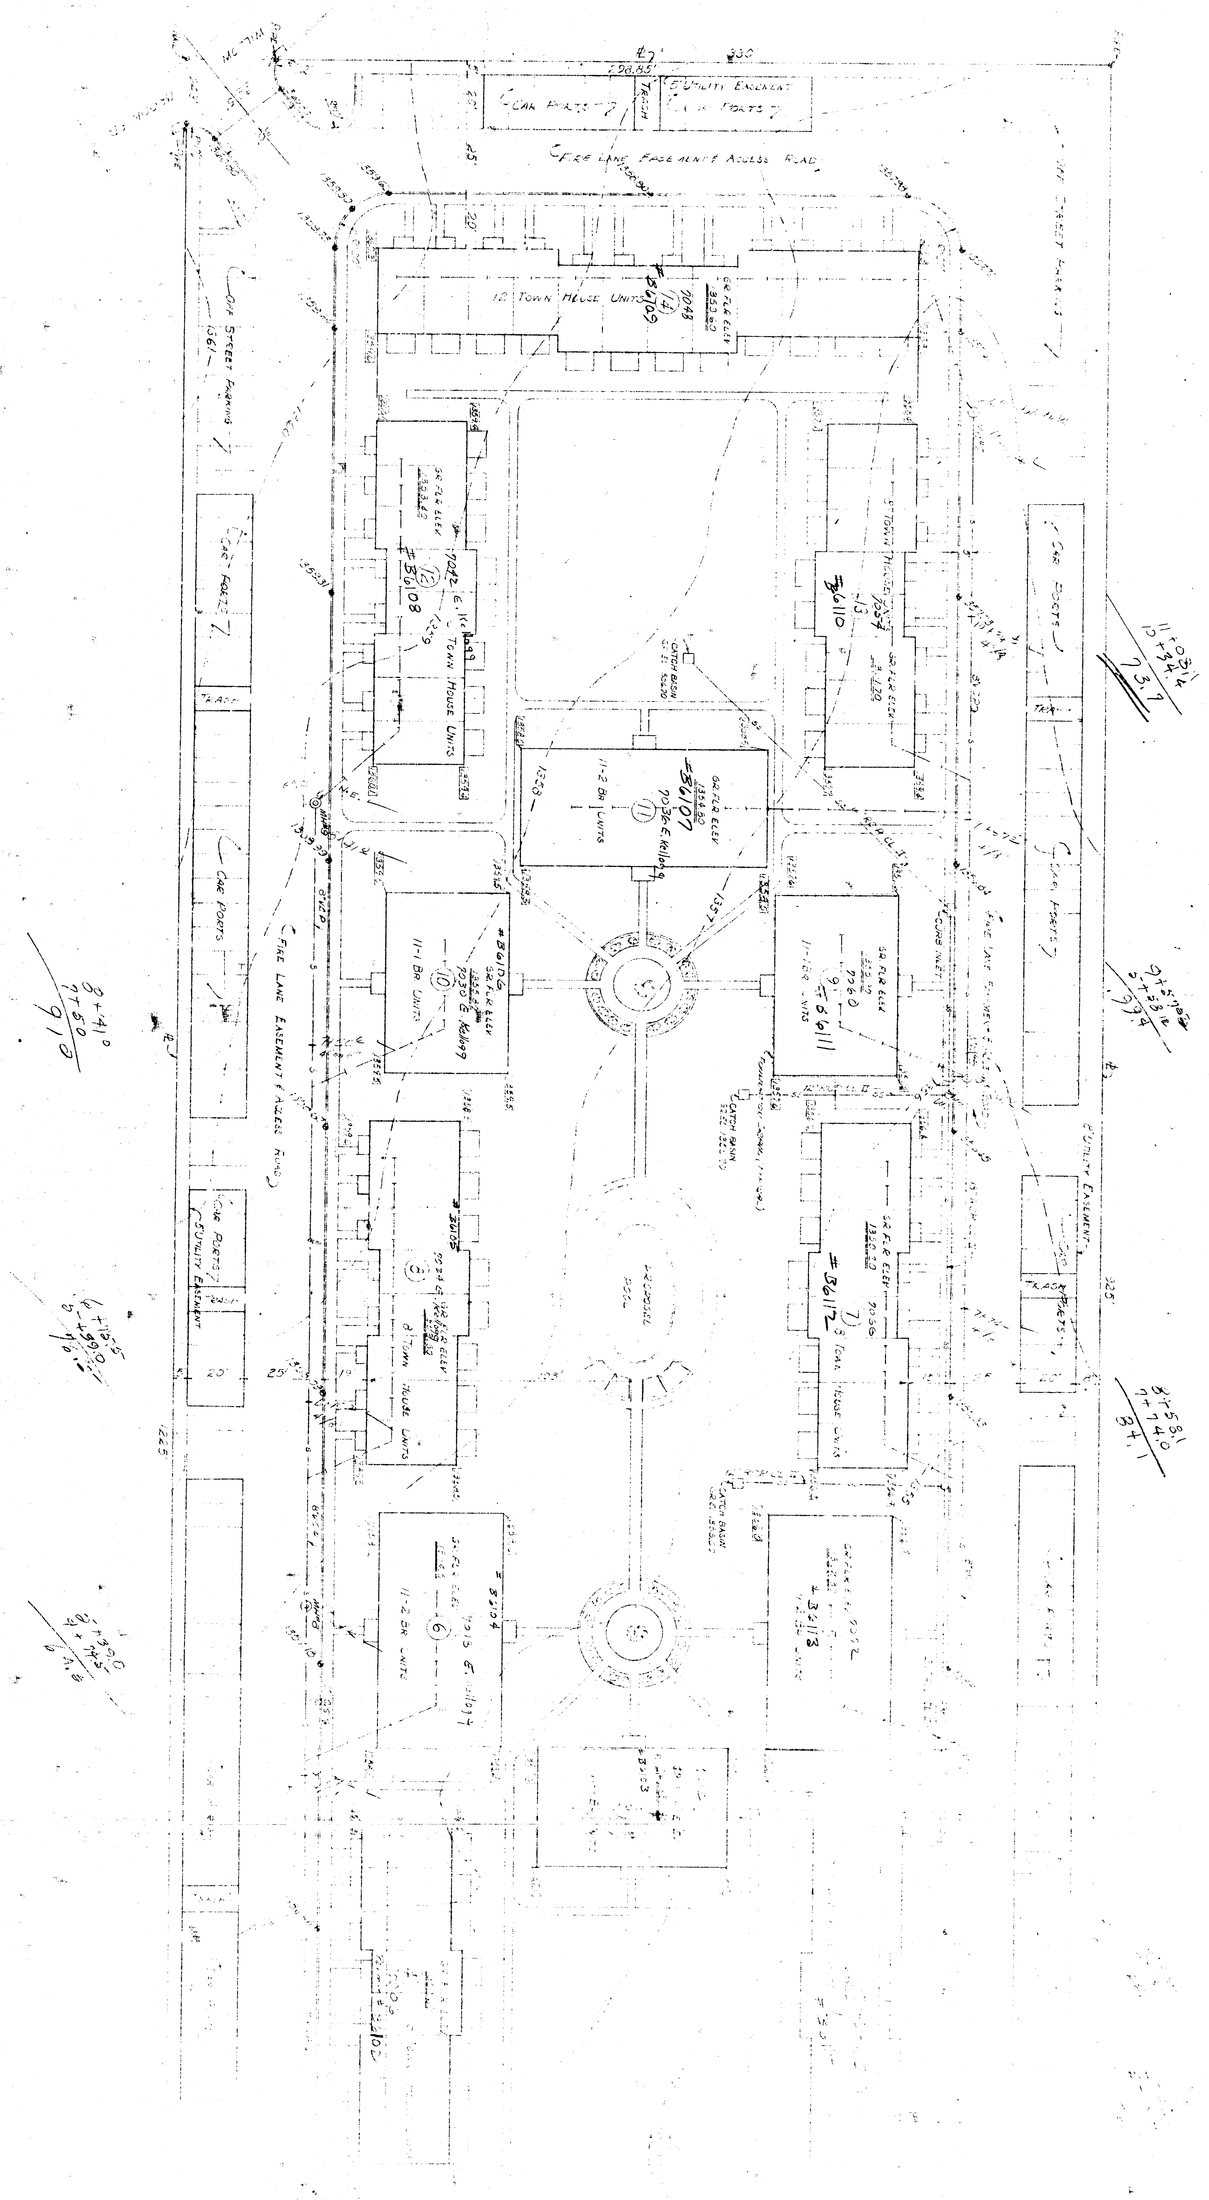

CAR PORTS
5' UTILITY EASEMENT
FIRE LANE EASEMENT & ACCESS ROAD
12 TOWN HOUSE UNITS
OFF STREET PARKING
TRASH
PROPOSED POOL
CATCH BASIN
CURB INLET

SCALE: 1"=20'

LEGEND

- SANITARY SEWER
- STORM SEWER
- CATCH BASIN
- TOP CURB ELEV
- FINISH GRADE ELEV
- MH - SANITARY
- M.H. - STORM

NOTES:

1) CONSTRUCTION TO CONFORM TO CITY OF WICHITA STANDARDS AND SPECIFICATIONS
2) CITY OF WICHITA WILL INSPECT AND GRANT FINAL APPROVAL OF SANITARY COLLECTION SYSTEM
3) WATER SERVICE TO BE PROVIDED BY CITY OF WICHITA WATER DEPARTMENT.
4) K.H.C. BM "6" - TOP OF SW ANCHOR BOLT ON LIGHT STANDARD BASE FOR STANDARD OIL COMPANY 7210 EAST KELLOGG. ELEV = 1350.71 (1163.18 - CITY DATUM)

CITY OF WICHITA
REVIEWED: Approval does not relieve the contractor from any responsibility for errors or omissions in the contract drawings, plans or for any deficiencies of equipment, work or materials.
Date: June 21 1966
Engineering No. [illegible]

APPROVED AS NOTED
By CITY ENGINEER OF WICHITA
Sanitary Sewer
Storm Sewer
Waterway Approach

NOTE TO CONTRACTOR
This project will be constructed under the supervision of the CITY ENGINEER and conforming to the SPECIFICATIONS of the CITY OF WICHITA. The CONTRACTOR will reimburse the City of Wichita for all cost of Engineering, Plan and inspection.

EASTBOROUGH APARTMENTS
WICHITA KANSAS
PLOT PLAN
PROFESSIONAL ENGINEERING CONSULTANTS
309 LAURA WICHITA, KANS
DRAWN BY [illegible] CHKD BY [illegible]

KELLOGG DR.

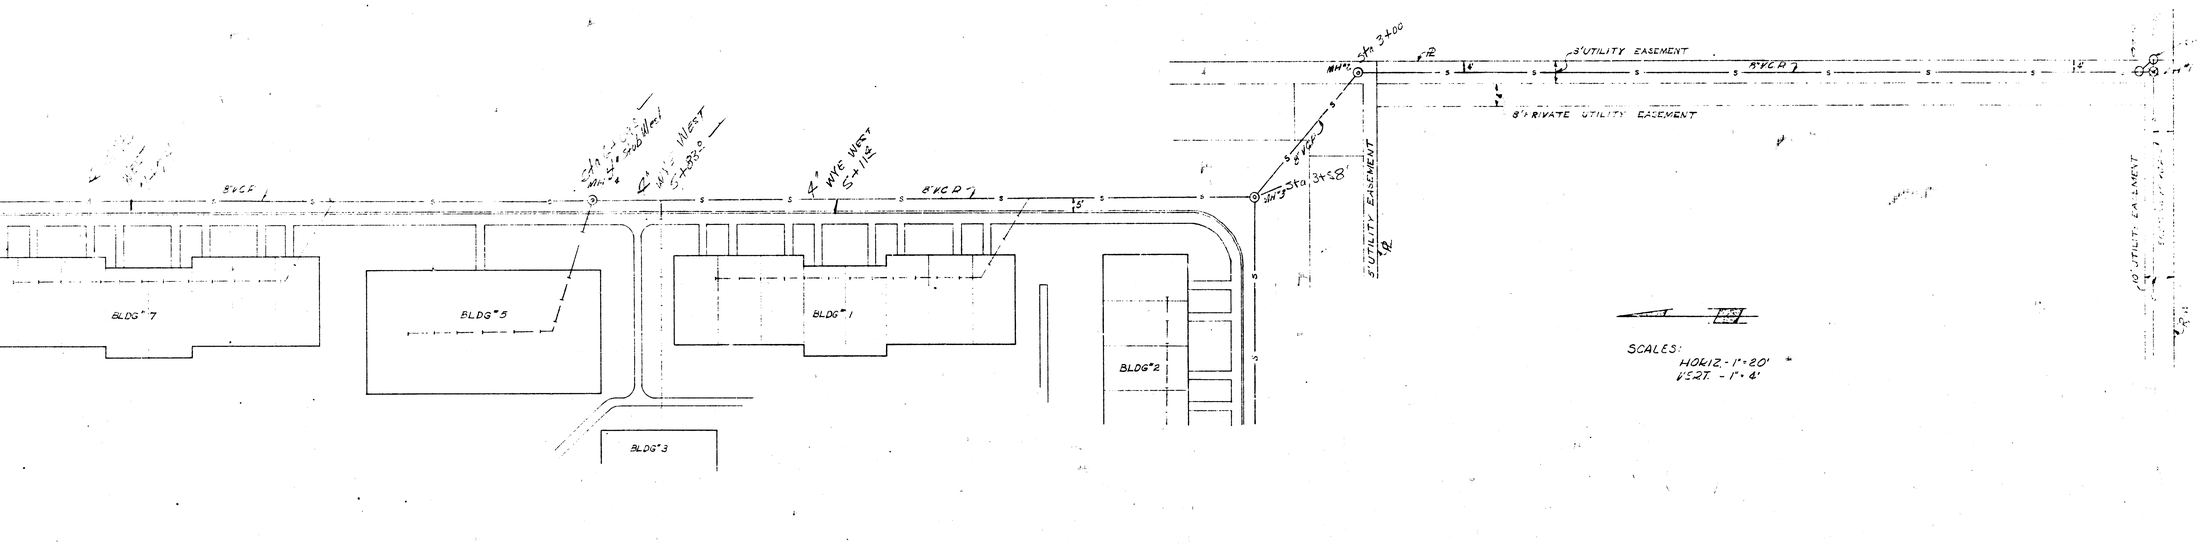

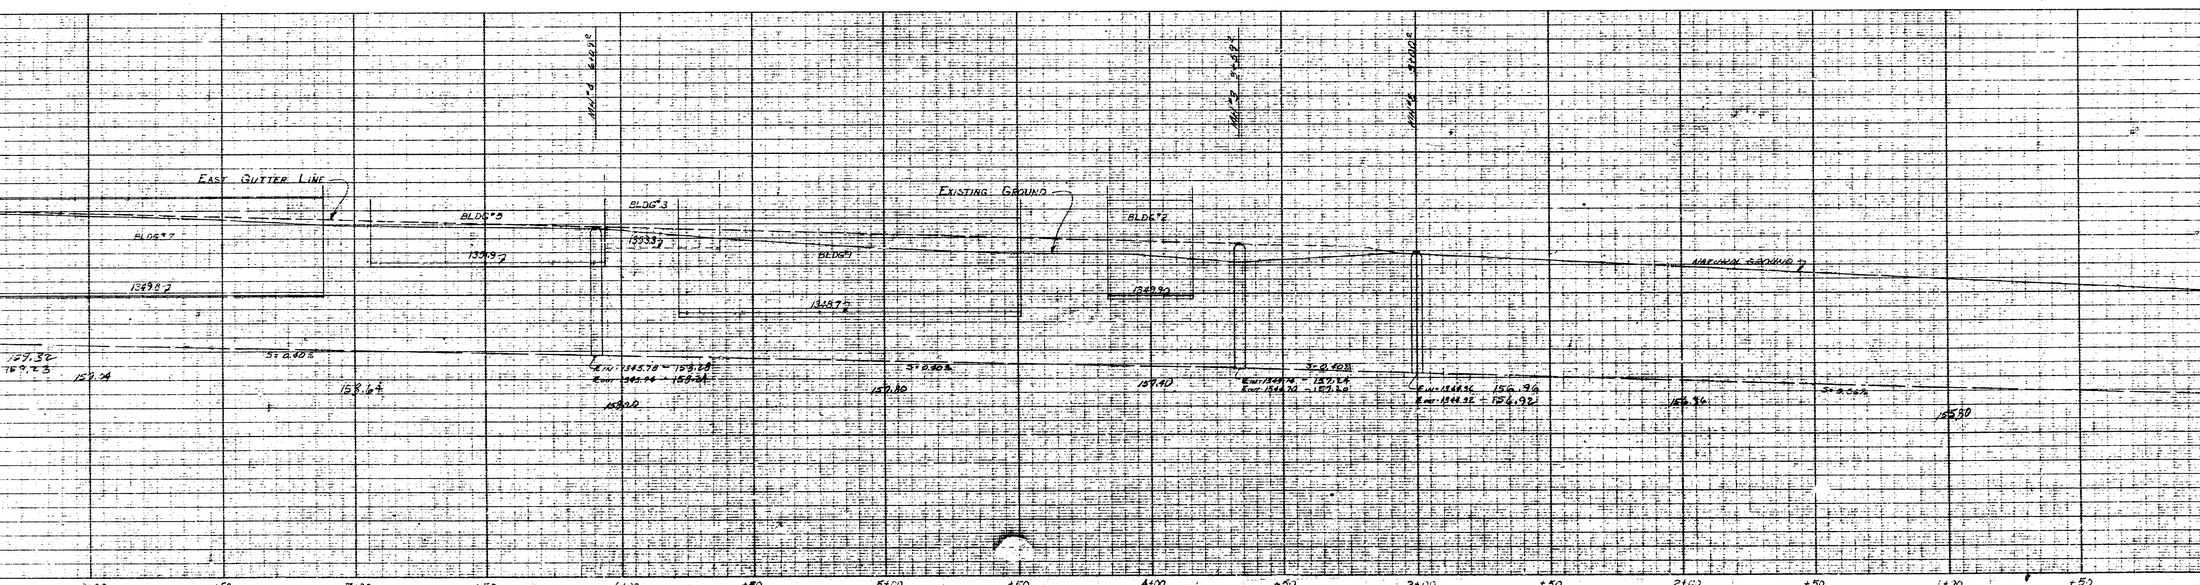

EASTBOROUGH APARTMENTS
WICHITA KANSAS
EAST PROFILE SANITARY SEWER
PROFESSIONAL ENGINEERING CONSULTANTS
509 LAURA WICHITA KS.
DRAWN BY EGS CKD BY SWF

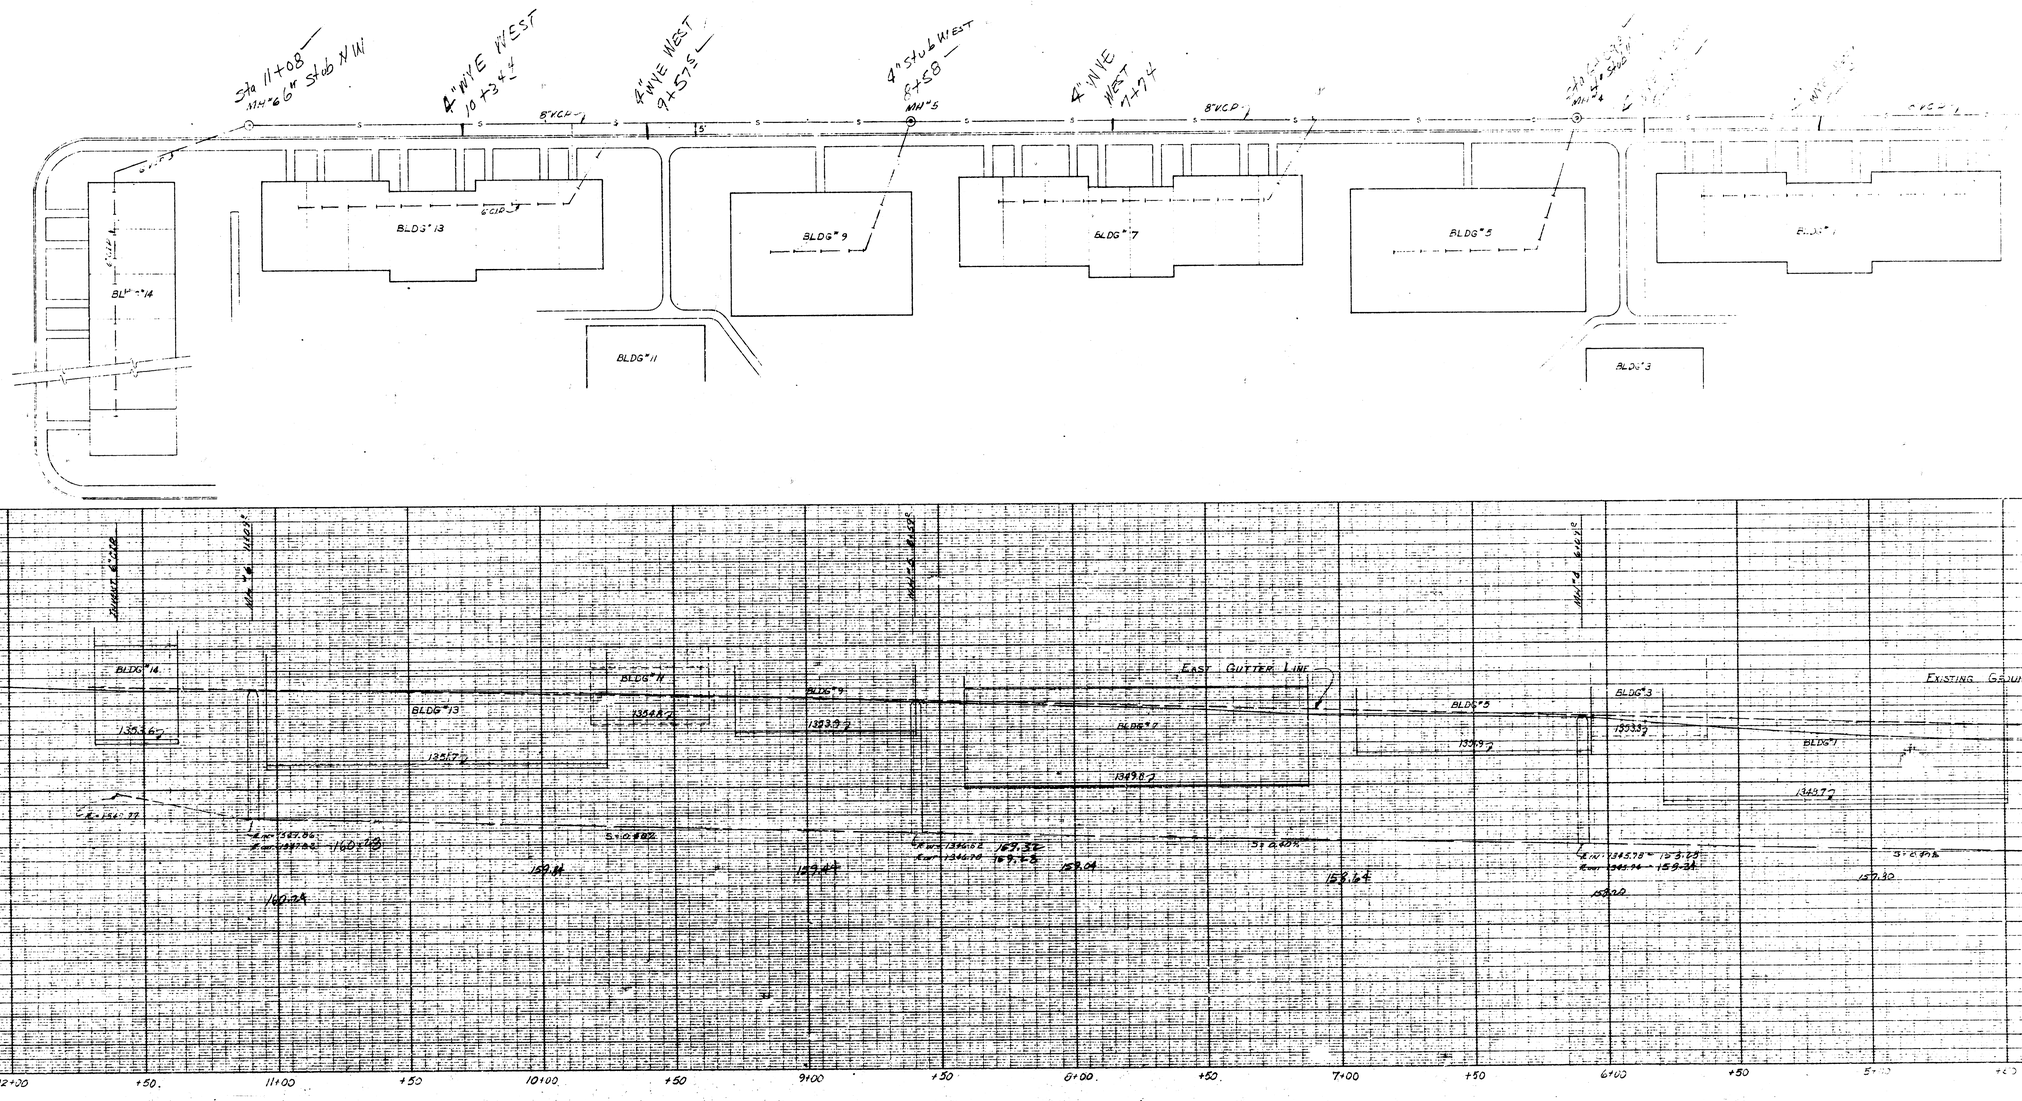

Sta 11+08
MH#6 6" Stub N/W
4" WYE WEST
10+34.4
4" WYE WEST
9+57.5
4" Stub WEST
8+58
MH#5
4" WYE WEST
7+74
8" VCP
BLDG#13
BLDG#9
BLDG#7
BLDG#5
BLDG#11
BLDG#3
BLDG#14
BLDG#11
BLDG#9
BLDG#7
BLDG#5
BLDG#3
BLDG#1
EAST GUTTER LINE
EXISTING GROUND
1360
1350
1340
+50
12+00
11+00
10+00
9+00
8+00
7+00
6+00

EASTBOROUGH APARTMENTS

WICHITA KANSAS

MC ST PROFILES SANITARY SEWER

PROFESSIONAL ENGINEERING CONSULTANTS



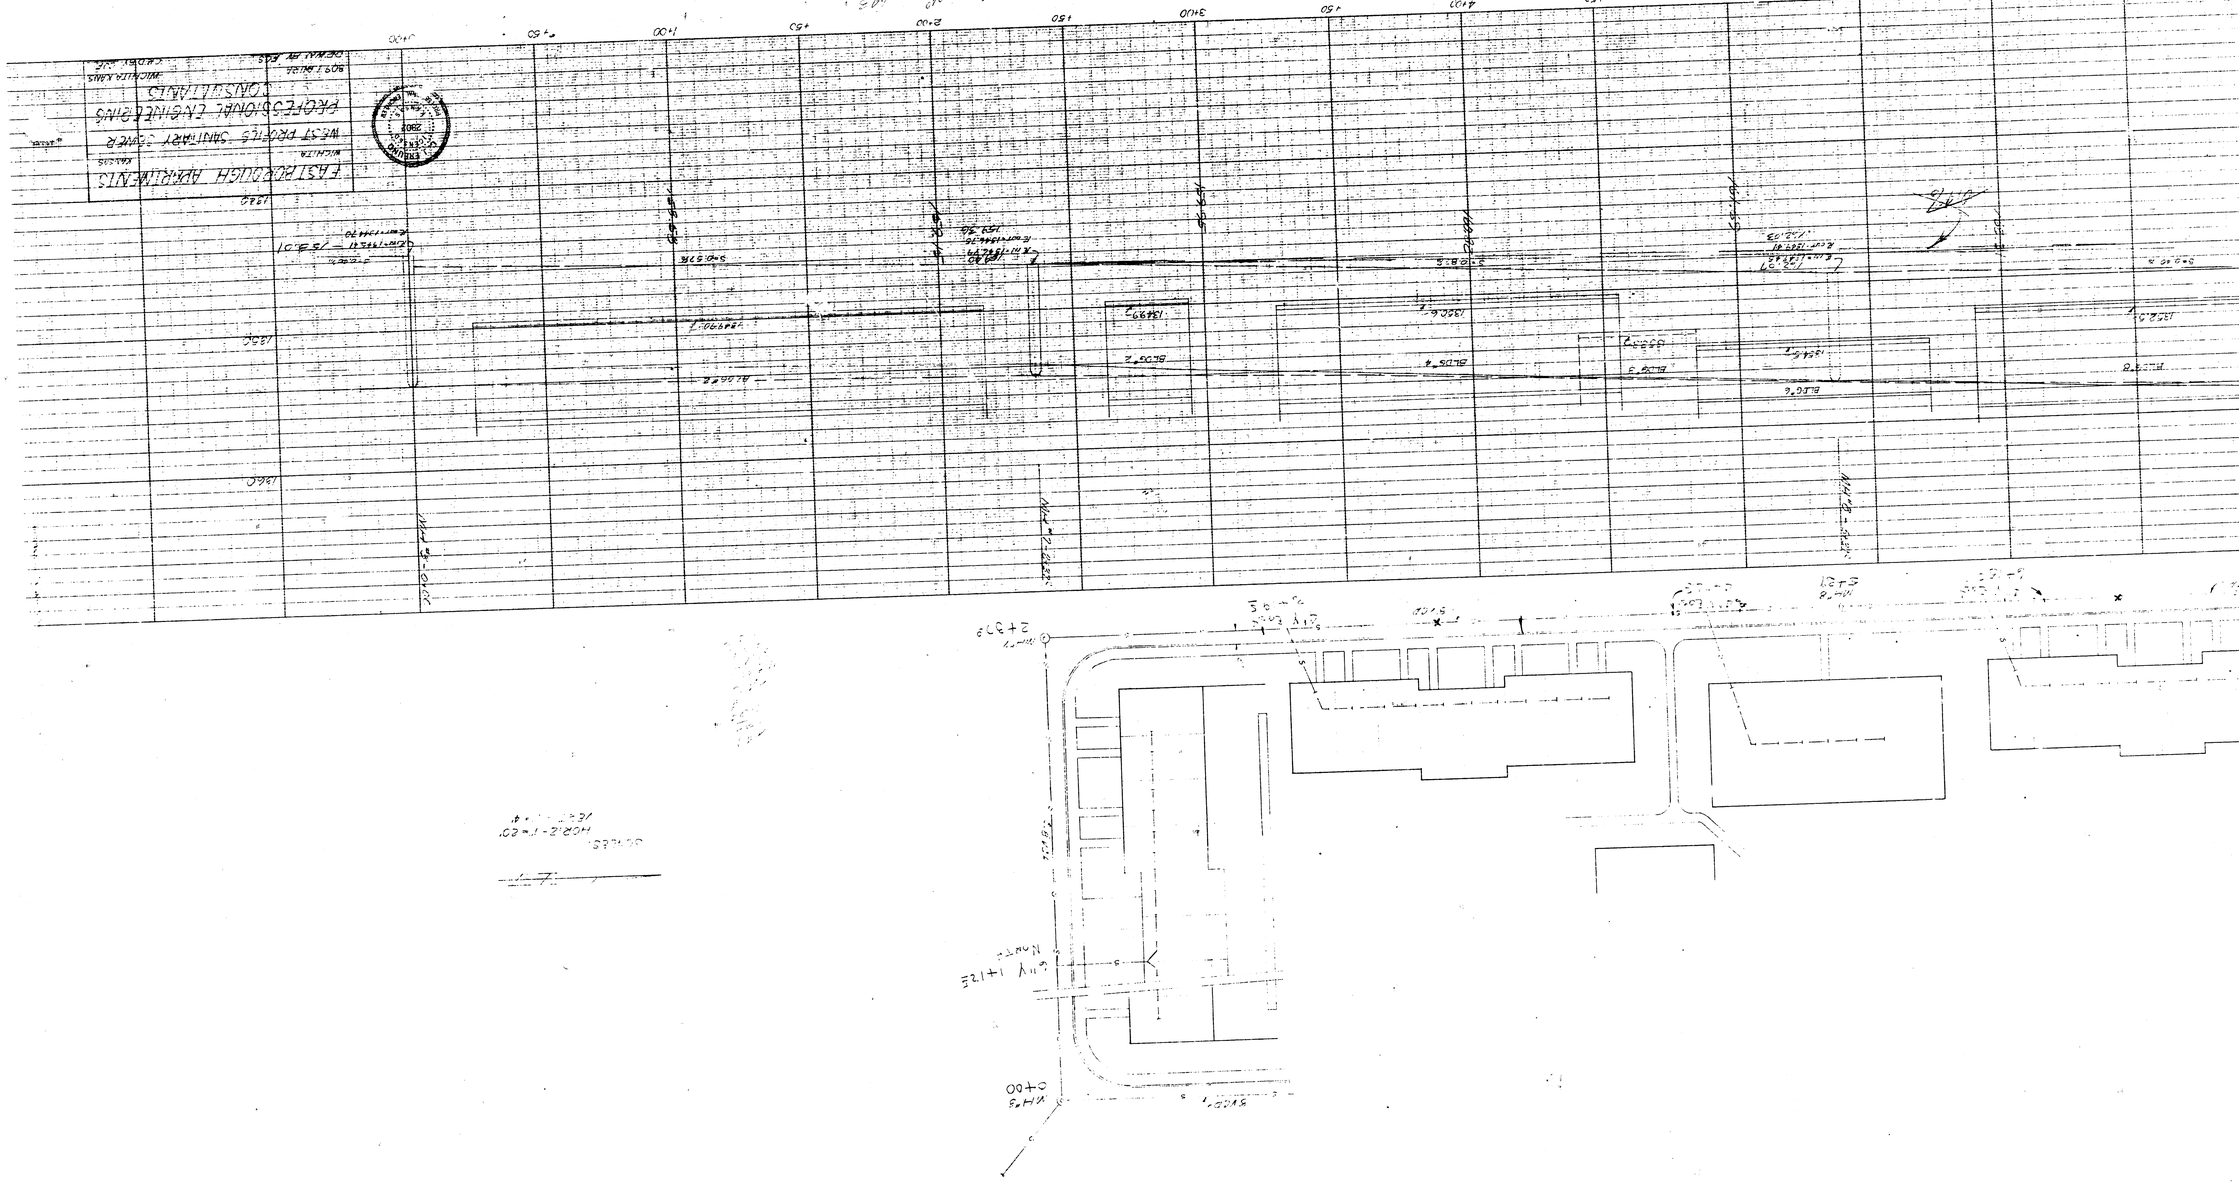

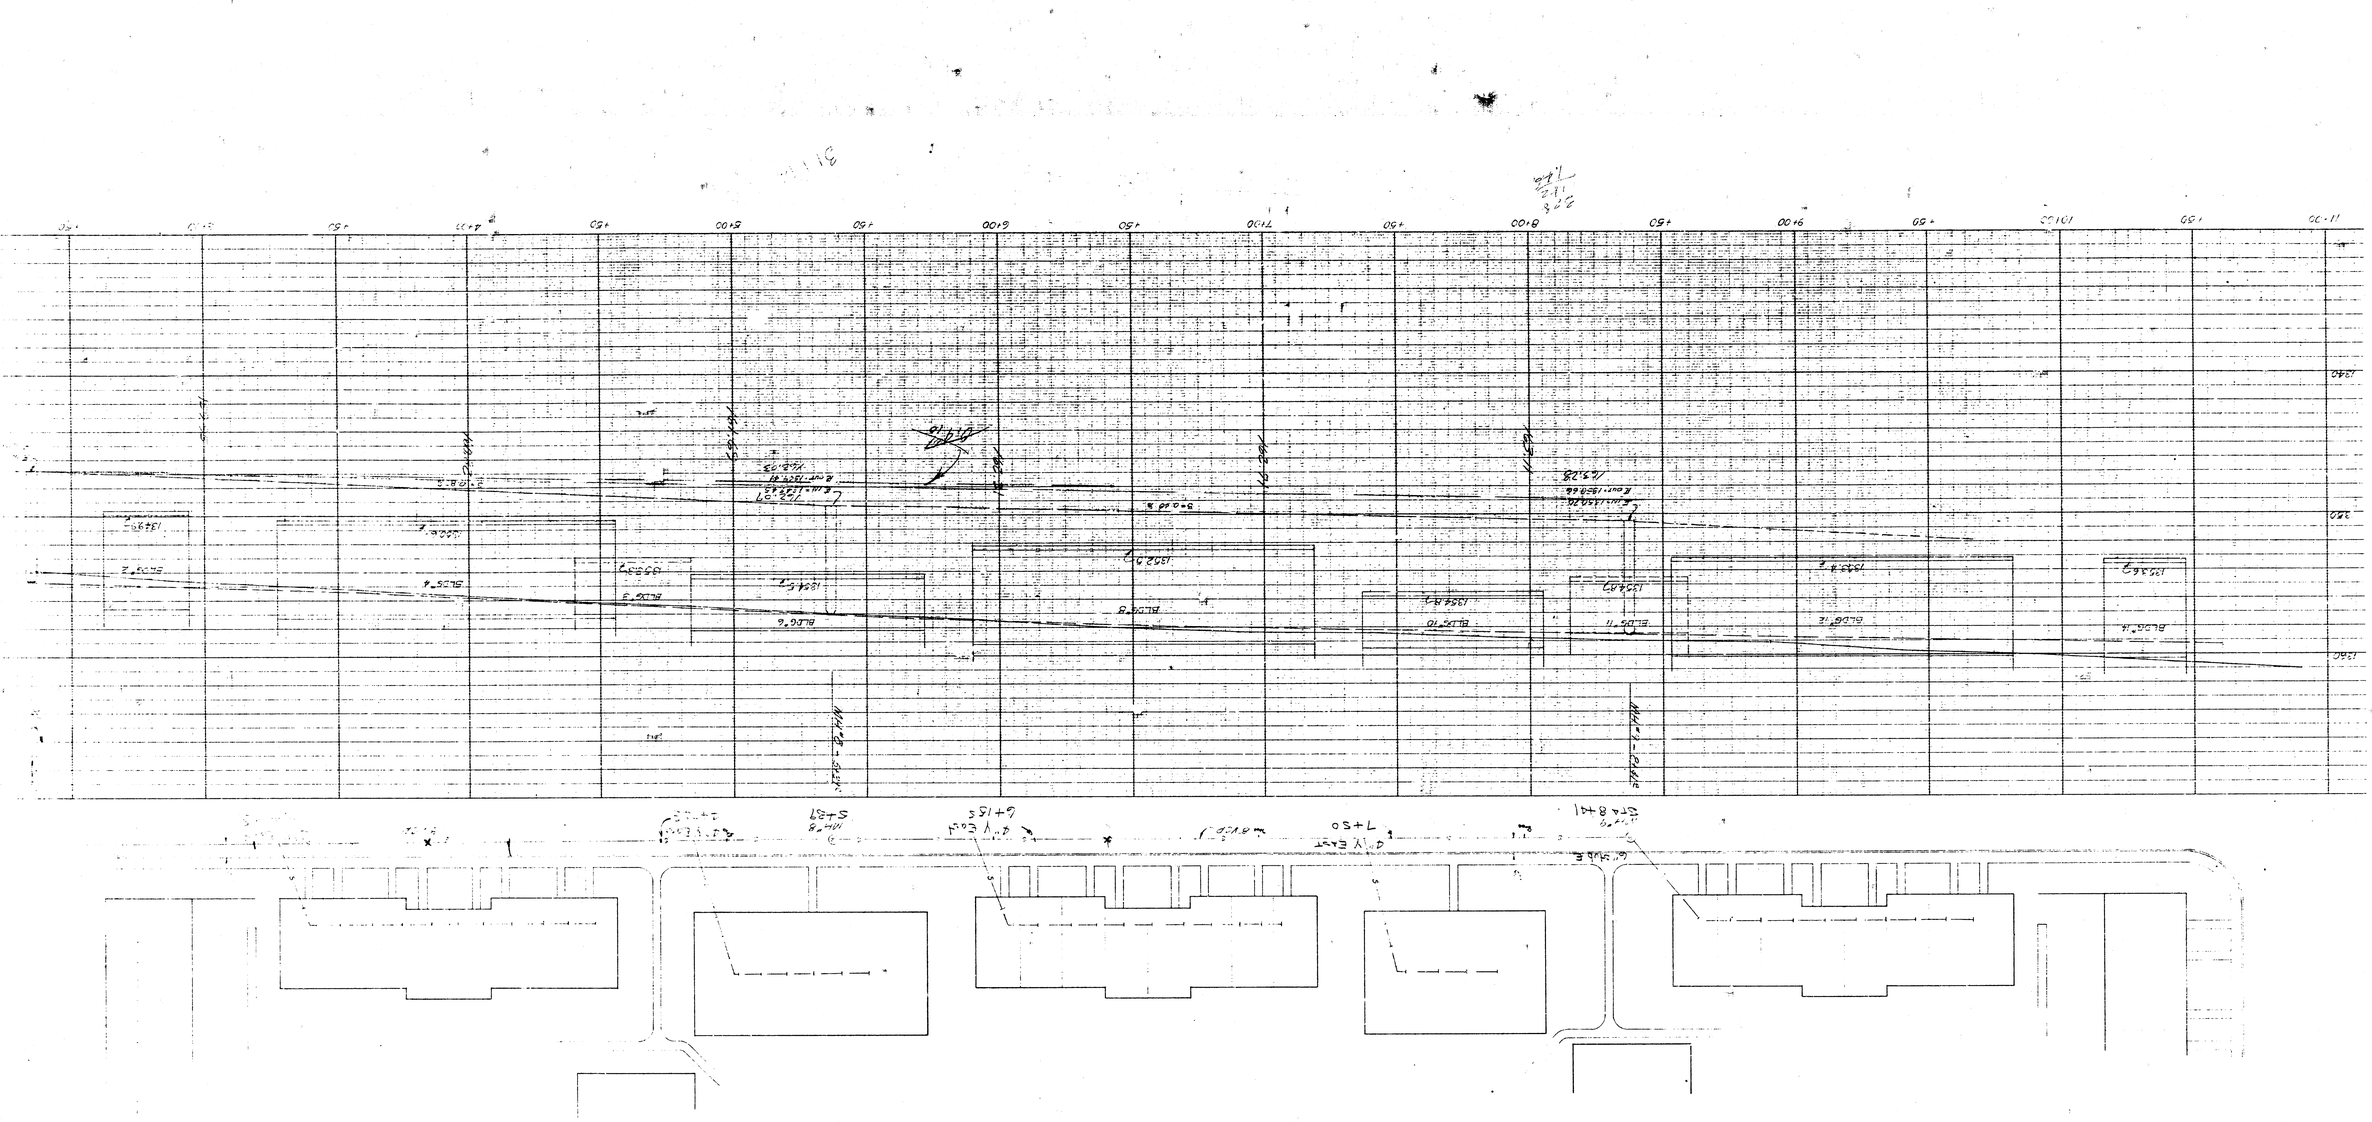

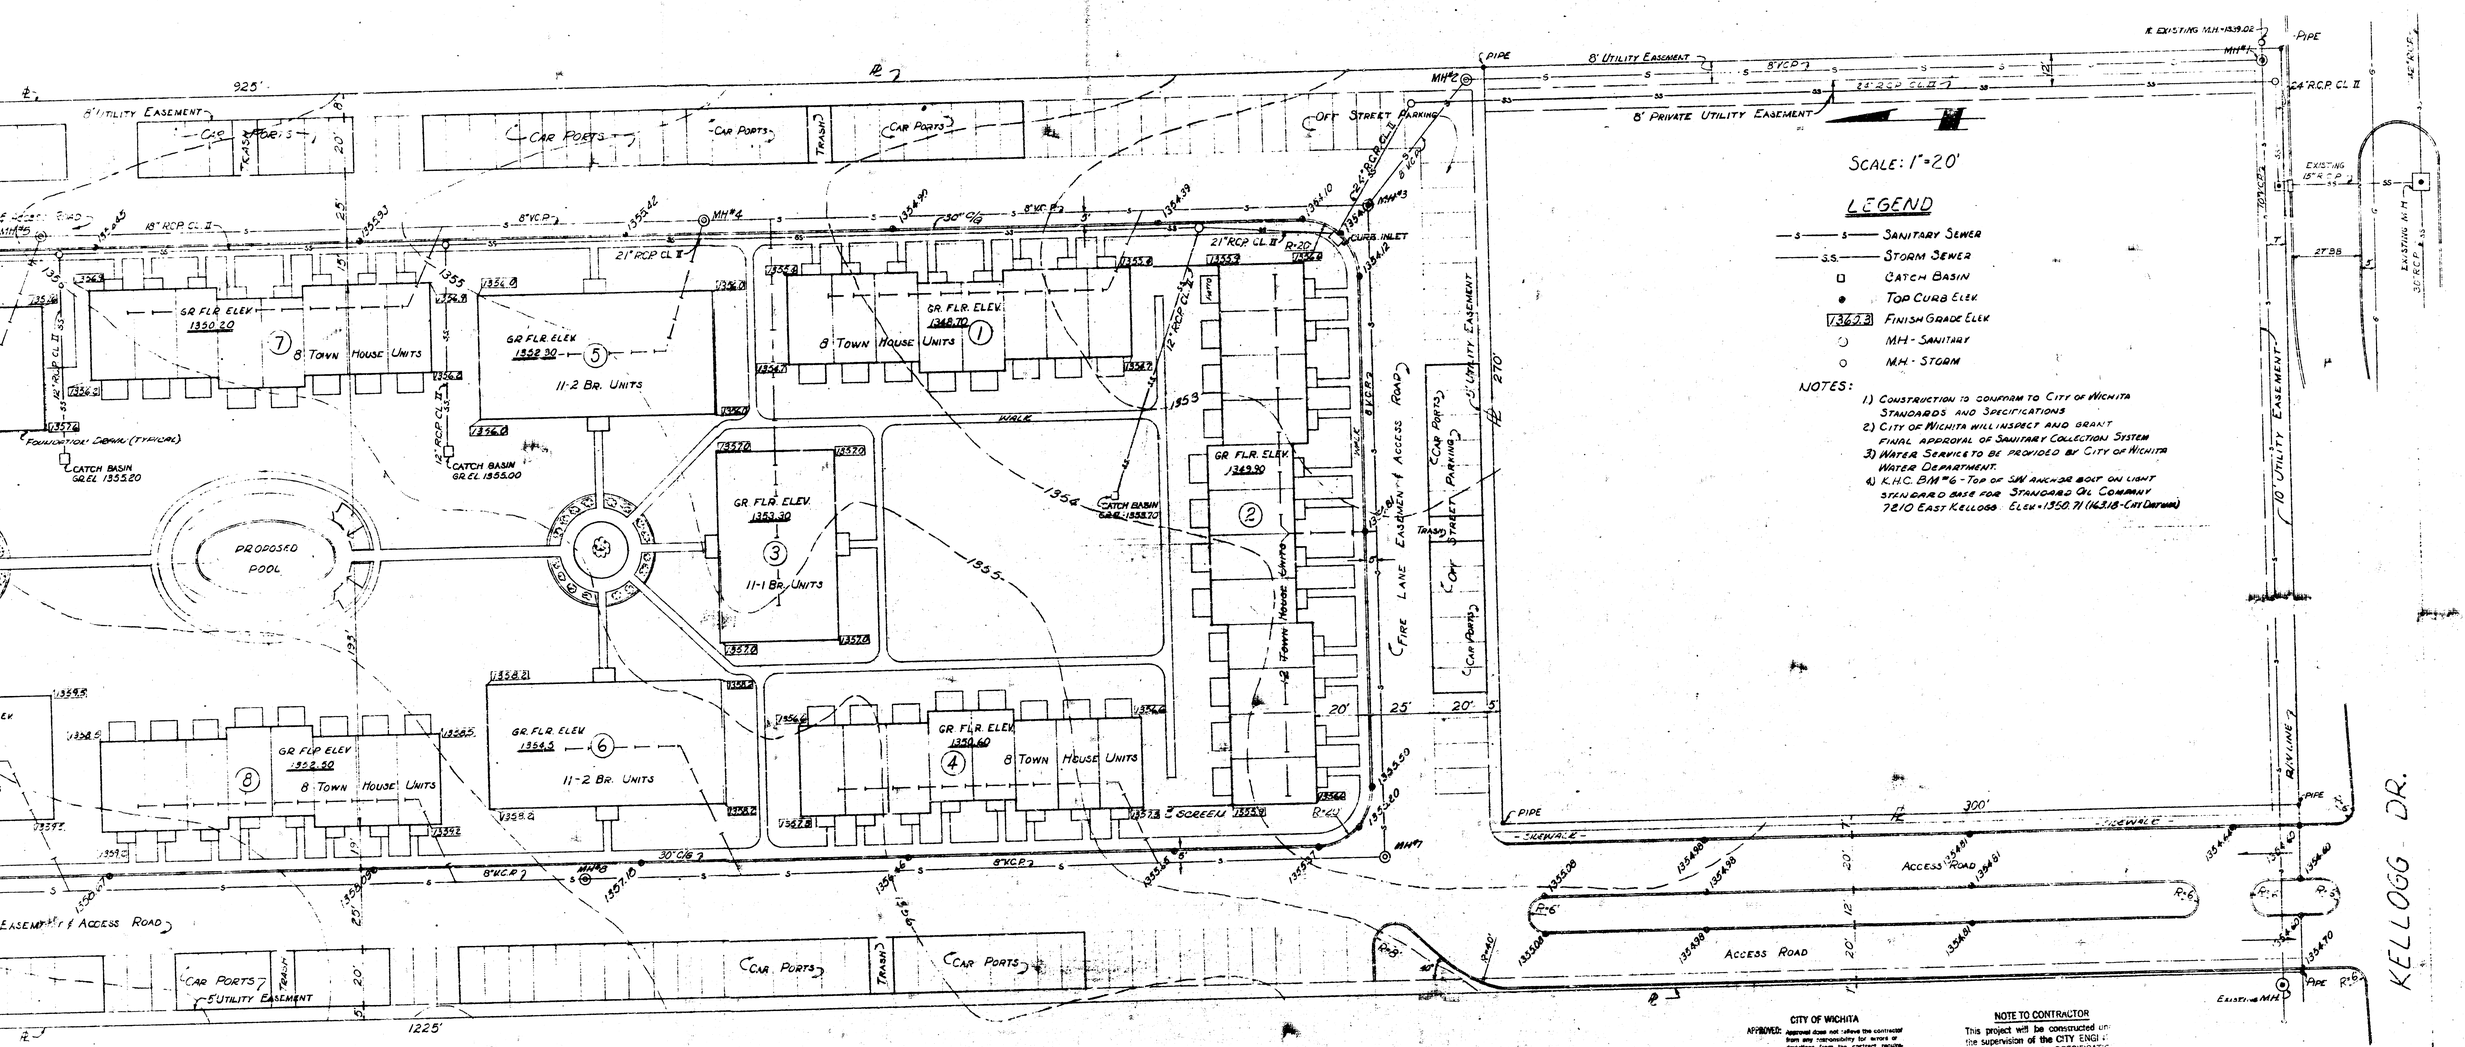

SCALE: 1"=20'
LEGEND
SANITARY SEWER
STORM SEWER
CATCH BASIN
TOP CURB ELEV.
FINISH GRADE ELEV.
M.H. - SANITARY
M.H. - STORM
NOTES:
1.) CONSTRUCTION TO CONFORM TO CITY OF WICHITA STANDARDS AND SPECIFICATIONS
2.) CITY OF WICHITA WILL INSPECT AND GRANT FINAL APPROVAL OF SANITARY COLLECTION SYSTEM
3.) WATER SERVICE TO BE PROVIDED BY CITY OF WICHITA WATER DEPARTMENT.
4.) K.H.C. BM #6 - TOP OF SW ANCHOR BOLT ON LIGHT STANDARD BASE FOR STANDARD OIL COMPANY 7210 EAST KELLOGG. ELEV.=1350.71 (163.18-CITY DATUM)
8' UTILITY EASEMENT
8' PRIVATE UTILITY EASEMENT
CAR PORTS
TRASH
OFF STREET PARKING
PROPOSED POOL
8 TOWN HOUSE UNITS
11-2 BR. UNITS
11-1 BR. UNITS
GR. FLR. ELEV.
FIRE LANE EASEMENT & ACCESS ROAD
ACCESS ROAD
KELLOGG DR.
CITY OF WICHITA
APPROVED: Approval does not relieve the contractor from any responsibility for errors or deviations from the contract requirements or for any deficiencies in equipment, work, or materials.
Date May 31 1966
Engineering Div. D. Sellers
APPROVED AS NOTED
By CITY ENGINEER OF WICHITA
Sanitary Sewers
Storm Sewers
Driveway Approaches
NOTE TO CONTRACTOR
This project will be constructed under the supervision of the CITY ENGINEER and conforming to the SPECIFICATIONS of the CITY OF WICHITA. The CONTRACTOR will reimburse the City of Wichita for all cost of Engineering, Plan and Inspection.
EASTBOROUGH APARTMENTS
WICHITA KANSAS
PLOT PLAN
PROFESSIONAL ENGINEERING CONSULTANTS
309 LAURA
DRAWN BY
WICHITA, KANS.

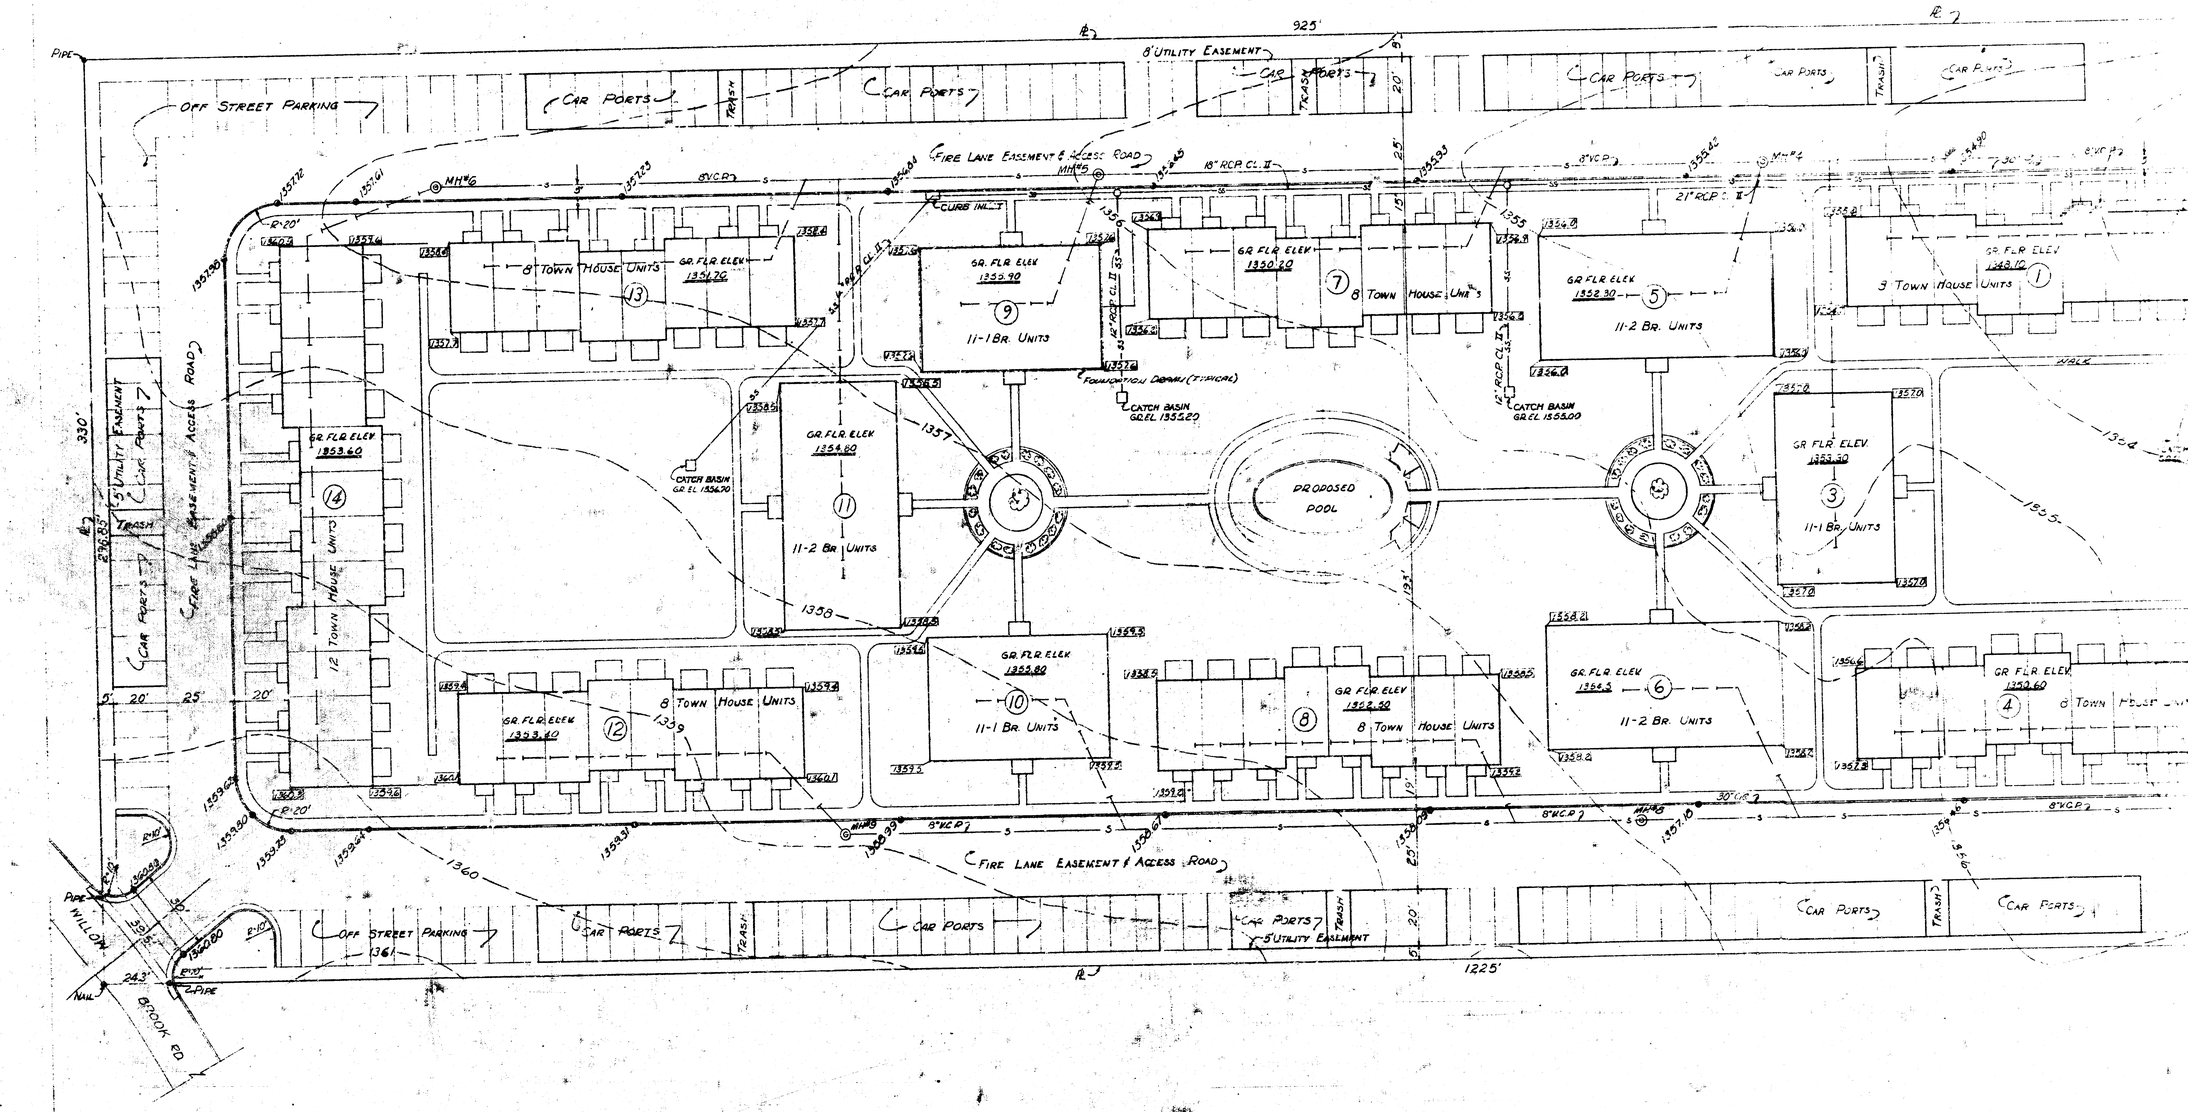

OFF STREET PARKING
CAR PORTS
TRASH
8' UTILITY EASEMENT
FIRE LANE EASEMENT & ACCESS ROAD
925'
1225'
330'
PIPE
WILLOW
BROOK RD
NAIL
8 TOWN HOUSE UNITS
GR. FLR. ELEV. 1351.70
GR. FLR. ELEV. 1353.60
12 TOWN HOUSE UNITS
GR. FLR. ELEV. 1355.90
11-1 BR. UNITS
GR. FLR. ELEV. 1350.20
GR. FLR. ELEV. 1352.30
11-2 BR. UNITS
GR. FLR. ELEV. 1354.80
11-2 BR. UNITS
GR. FLR. ELEV. 1353.30
11-1 BR. UNITS
GR. FLR. ELEV. 1353.40
GR. FLR. ELEV. 1355.80
11-1 BR. UNITS
GR. FLR. ELEV. 1352.50
8 TOWN HOUSE UNITS
GR. FLR. ELEV. 1354.5
11-2 BR. UNITS
GR. FLR. ELEV. 1350.60
8 TOWN HOUSE UNITS
PROPOSED POOL
FOUNDATION DRAIN (TYPICAL)
CATCH BASIN GR. EL. 1355.20
CATCH BASIN GR. EL. 1355.00
CURB INLET
18" RCP CL. II
21" RCP CL. II
8" VCP