


APPROVED AS NOTED
By CITY ENGINEER WICHITA
Sanitary Sewers *Wichita*
Storm Sewers
Driveway Approaches

NOTE TO CONTRACTOR
This project will be constructed under the supervision of the CITY ENGINEER and conforming to the SPECIFICATIONS of the CITY OF WICHITA. The CONTRACTOR will reimburse the City of Wichita for all cost of Engineering, Plans, and Inspection.

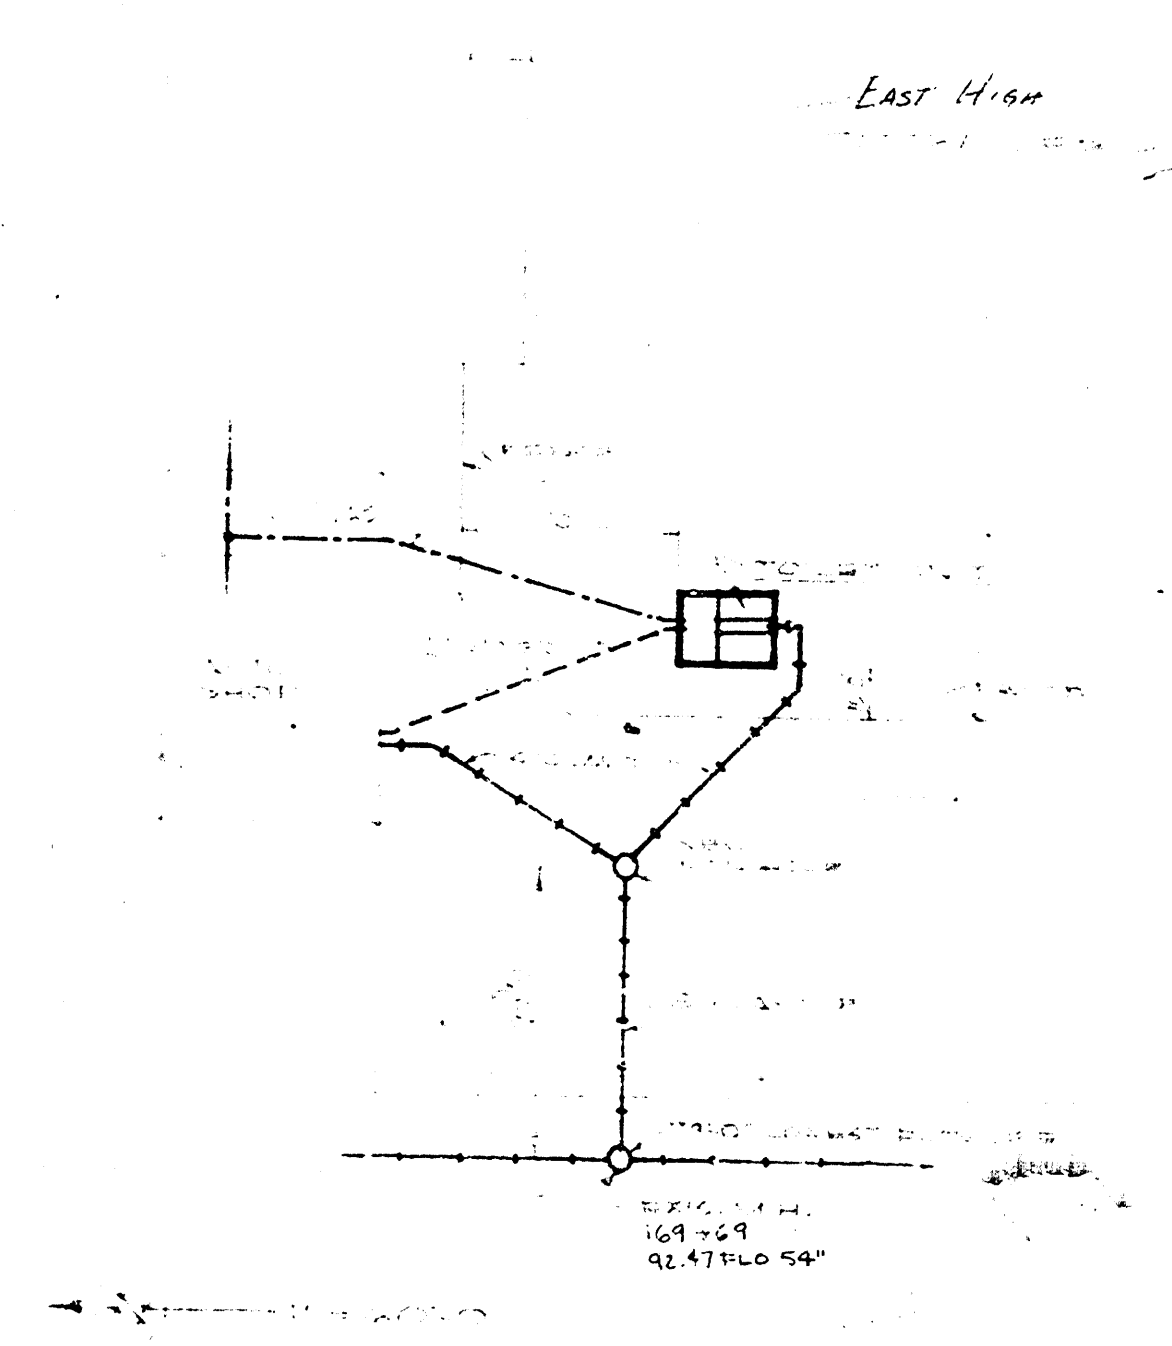

JUN 13 1960
JOB NO. DATE BOARD OF EXAMINERS TOLST UNIT DE... CC. SHEET
6011 JUNE 9-60 CAP. WICHITA AREA WICHITA EAST HIGH SCHOOL (R) OF 1