


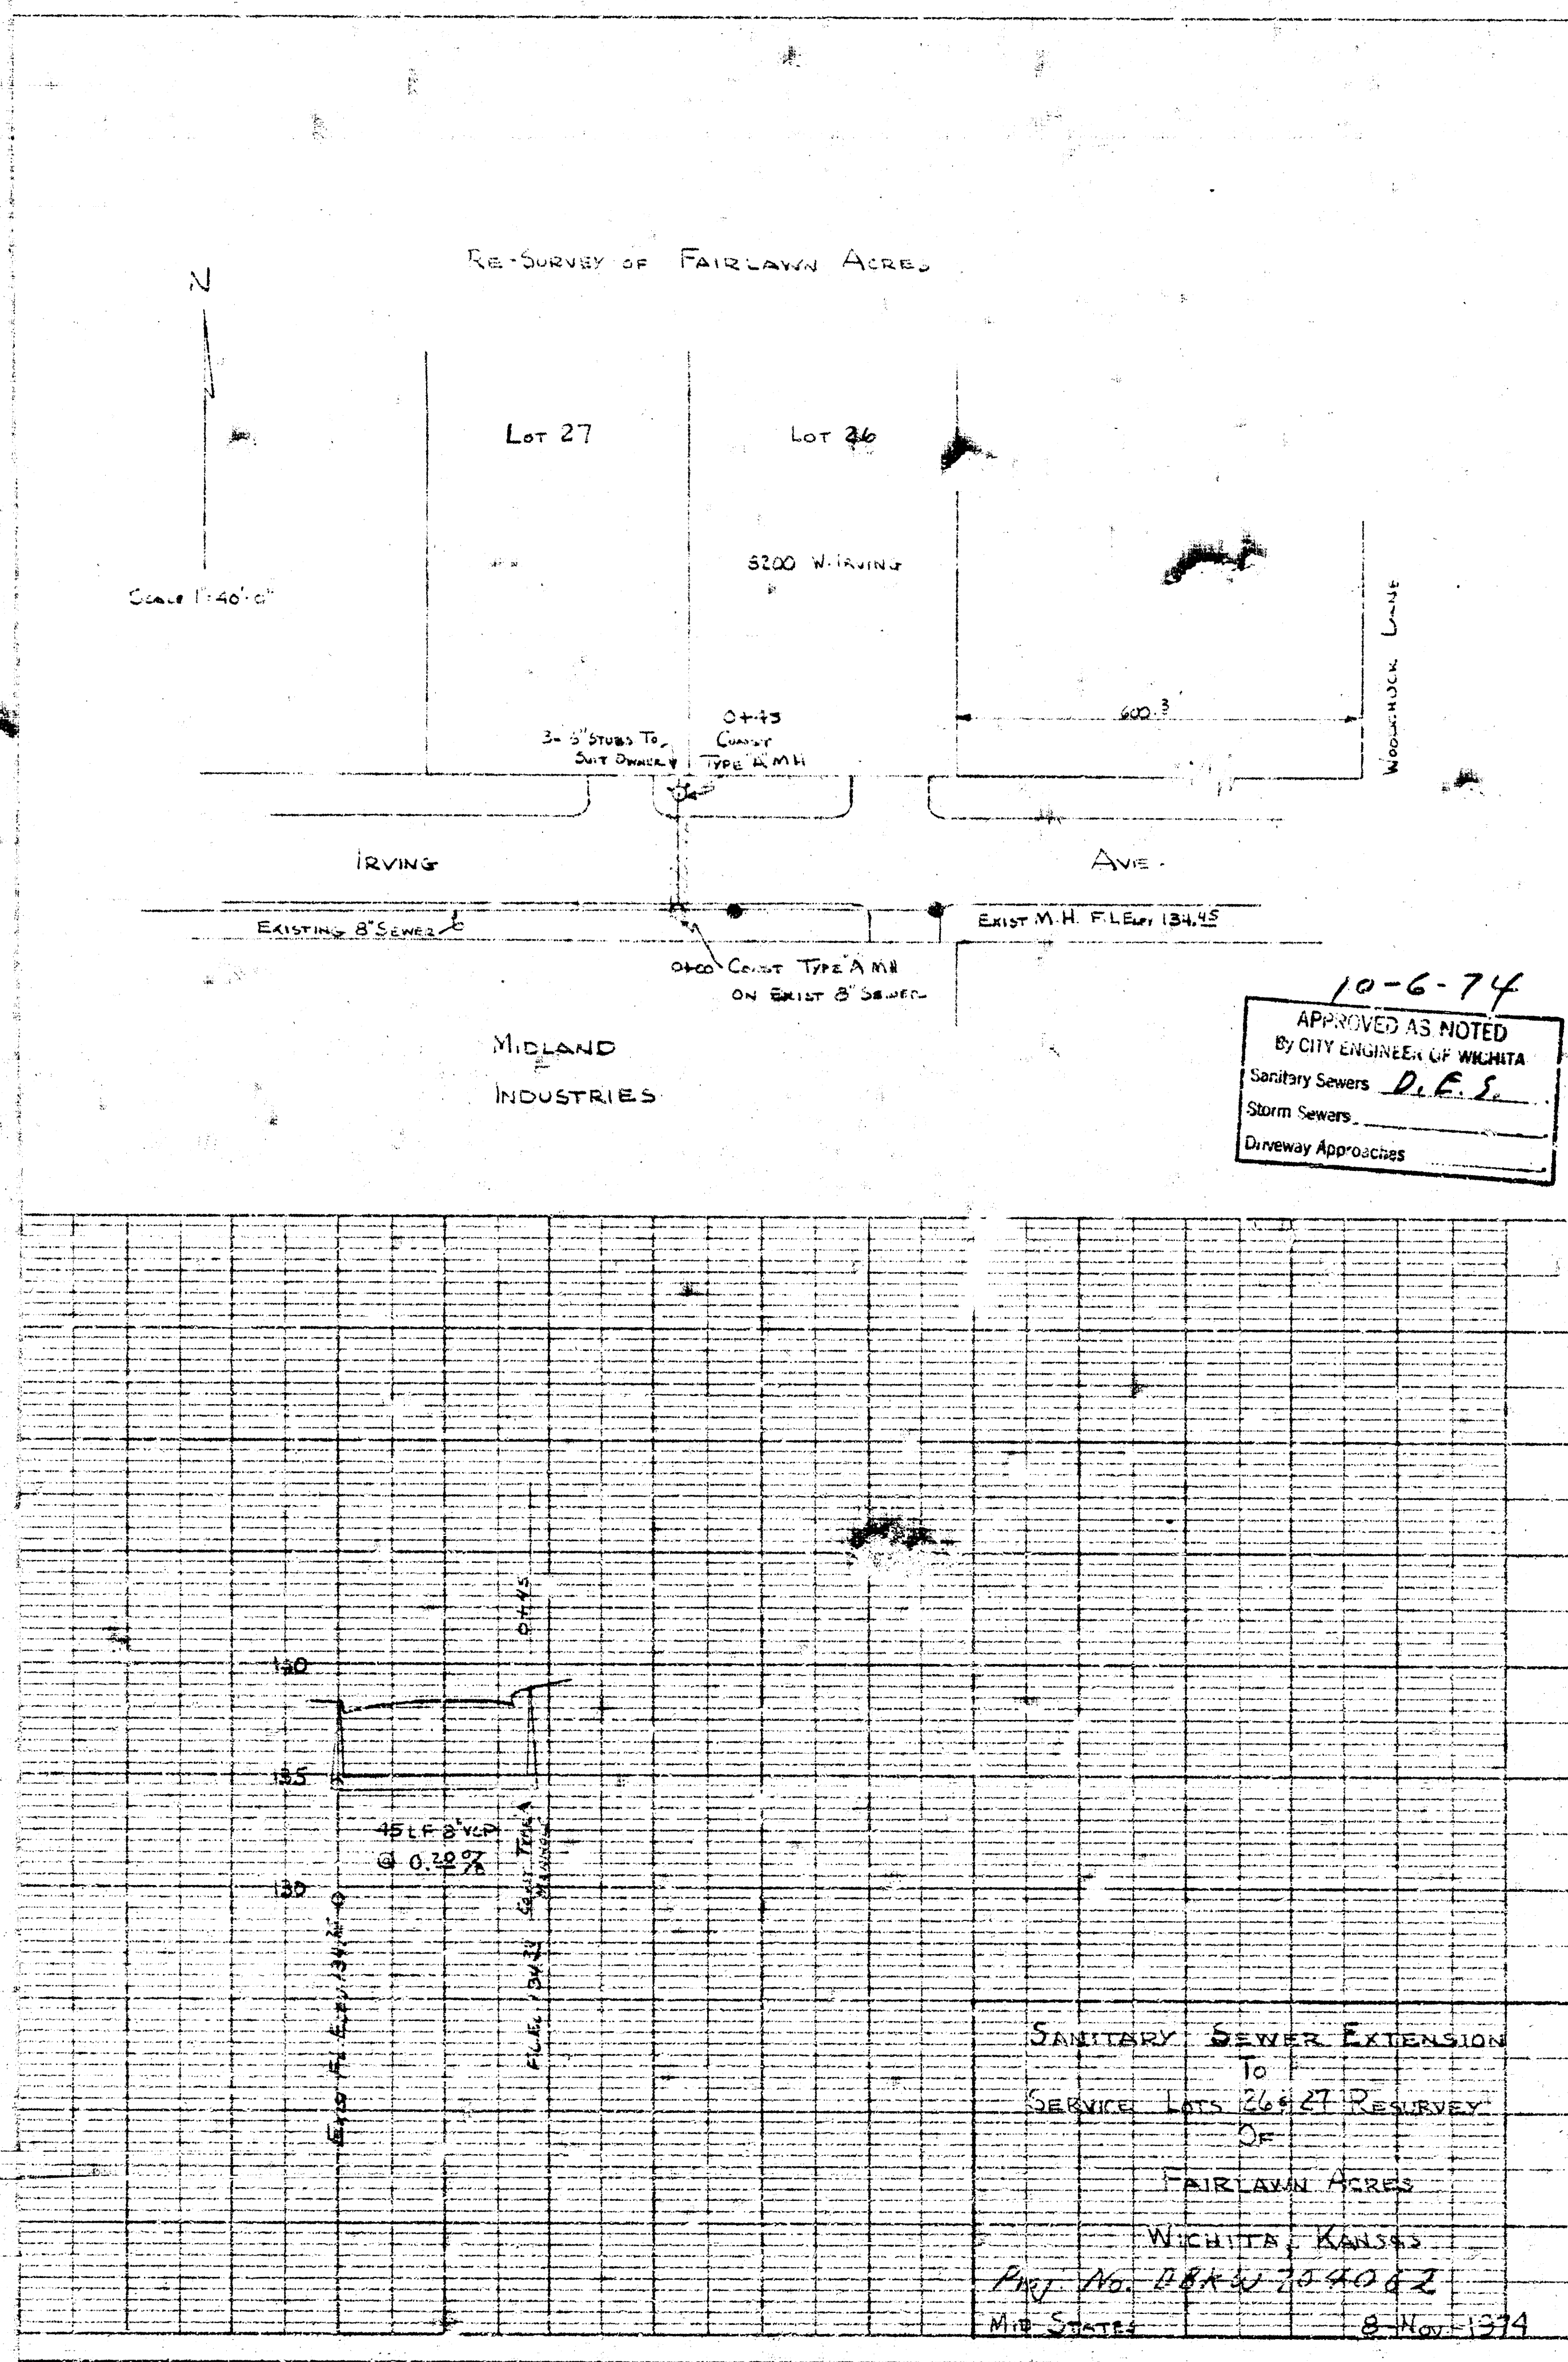

10-6-74
 APPROVED AS NOTED
 By CITY ENGINEER OF WICHITA
 Sanitary Sewers D.E.S.
 Storm Sewers _____
 Driveway Approaches _____

SANITARY SEWER EXTENSION
 TO
 SERVICE LOTS 26 & 27 RE-SURVEY
 OF
 FAIRLAWN ACRES
 WICHITA, KANSAS
 Proj. No. 2843-24002
 M.D. STATE 8-Nov-1974