



PLAN
 SHOWN
 NOT TO SCALE
 SEE ATTACHED SHEET FOR
 FULL SCALE

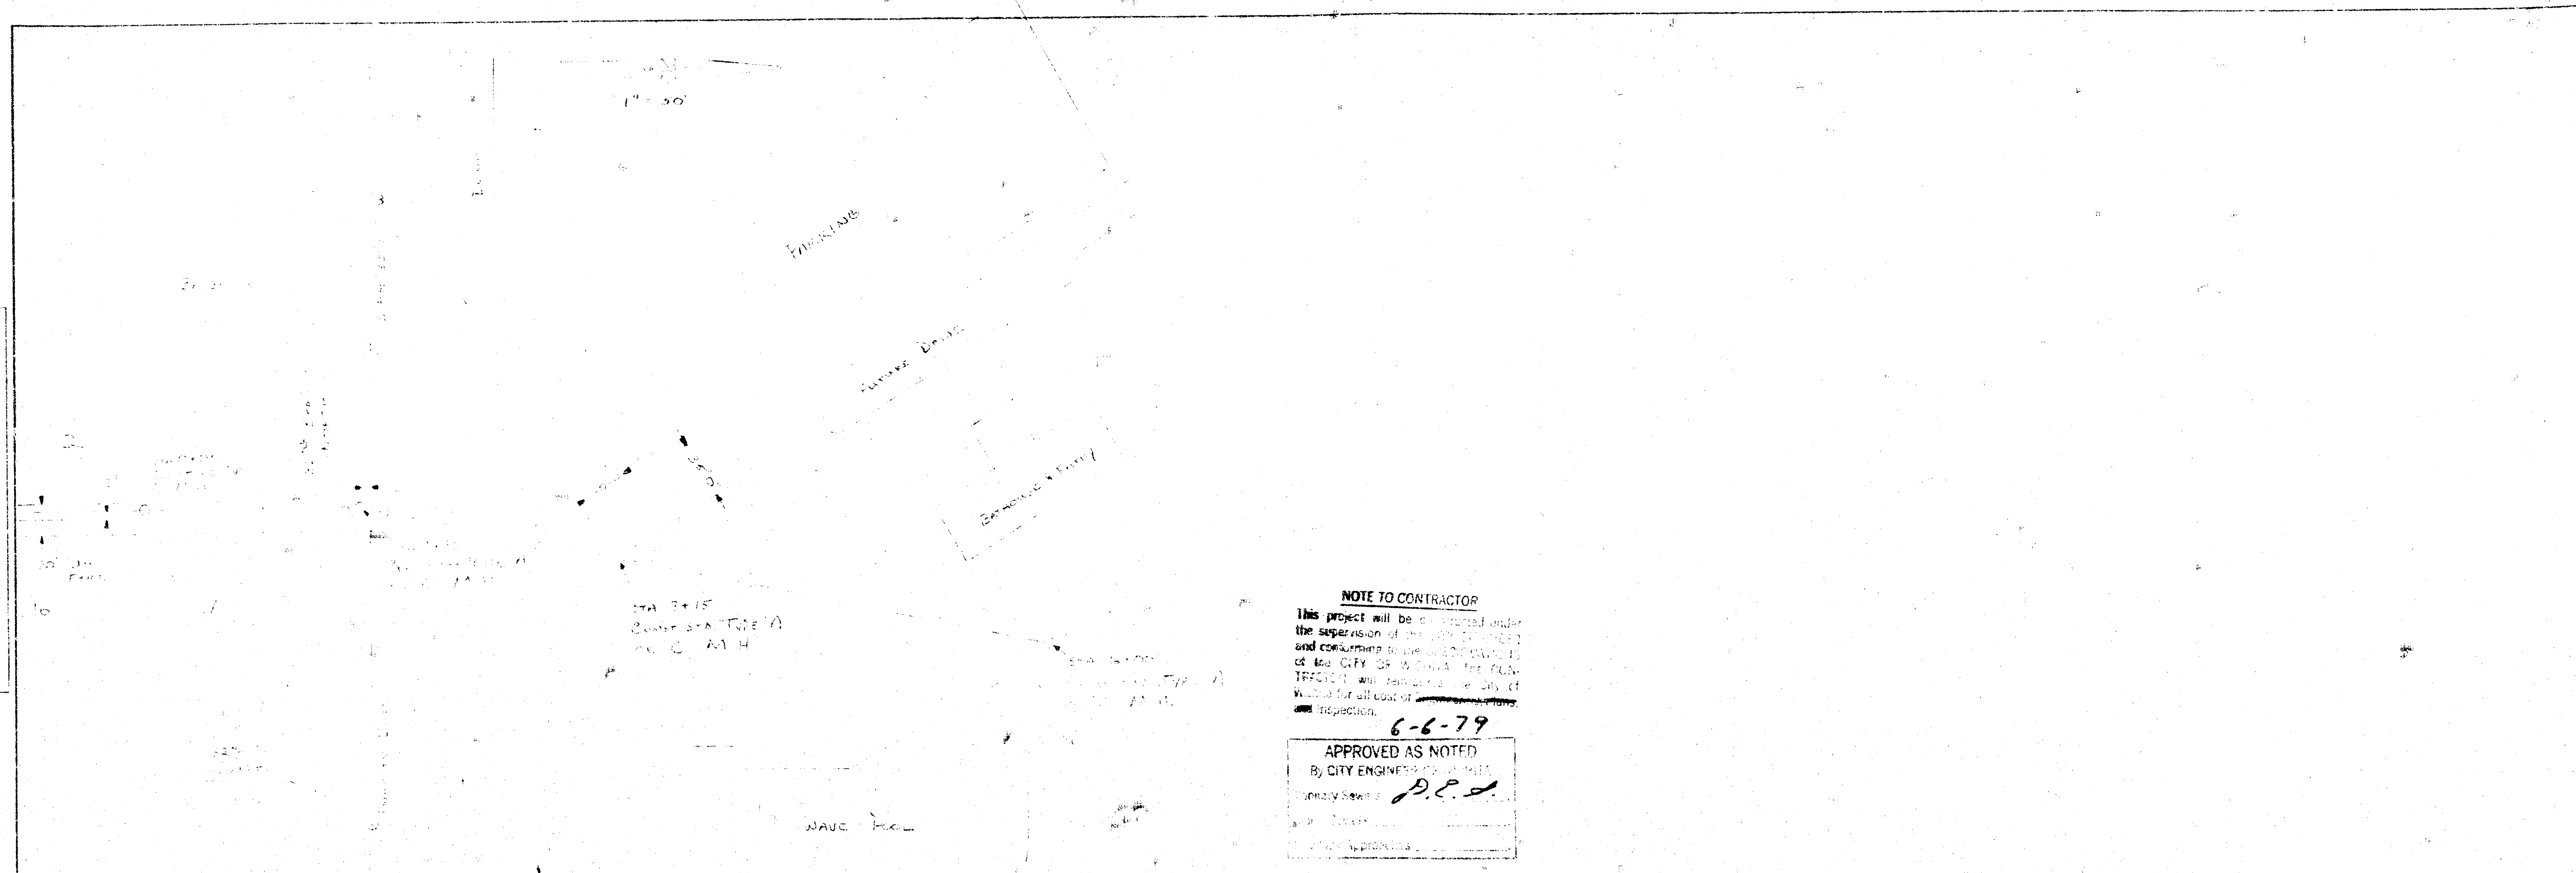


NOTE TO CONTRACTOR

APPROVED AS NOTED
 By CITY ENGINEER
 P.E. J. [Signature]
 Date: 6-6-79

PROFILE
 SHOWN
 NOT TO SCALE
 SEE ATTACHED SHEET FOR
 FULL SCALE

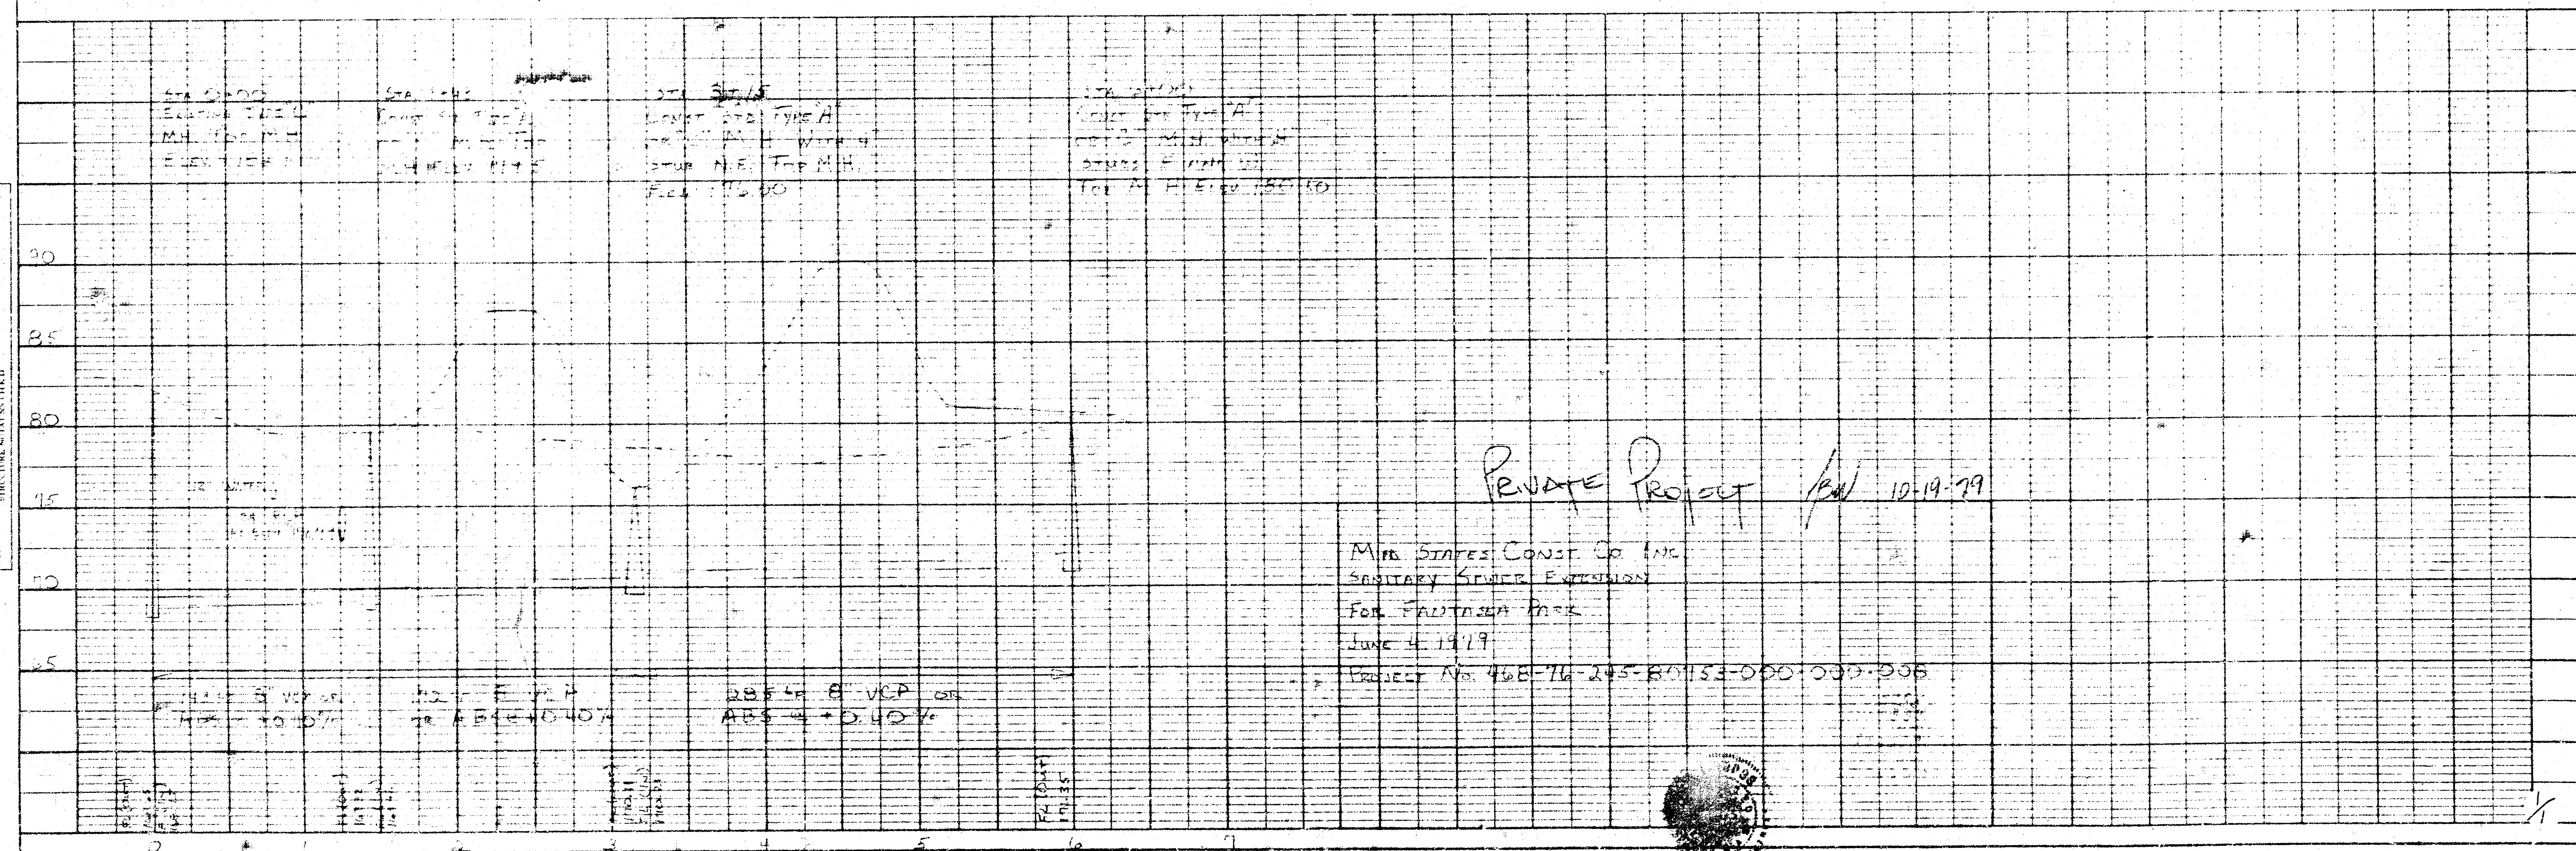

PRIVATE PROJECT /BW 10-19-79
 MRS. STATES CONST. CO. INC.
 SEWAGE SERVICE EXTENSION
 FOR FAUNTSEA PARK
 June 4, 1979
 PROJECT NO. 468-76-245-B0153-000-000-000

 



