PRIVATE SANITARY SEWER CITY PROJ. NO.
468-76-245-80000-000-000-008

[redacted]

8-9-81

APPROVED AS NOTED
By CITY ENGINEER OF WICHITA
Sanitary Sewers B.C.L.
Storm Sewers
Driveway Approaches

NOTE TO CONTRACTOR

This project will be constructed under the supervision of the CITY ENGINEER and conforming to the SPECIFICATIONS of the CITY OF WICHITA. The CONTRACTOR will prepay the City of Wichita for all costs of inspection.

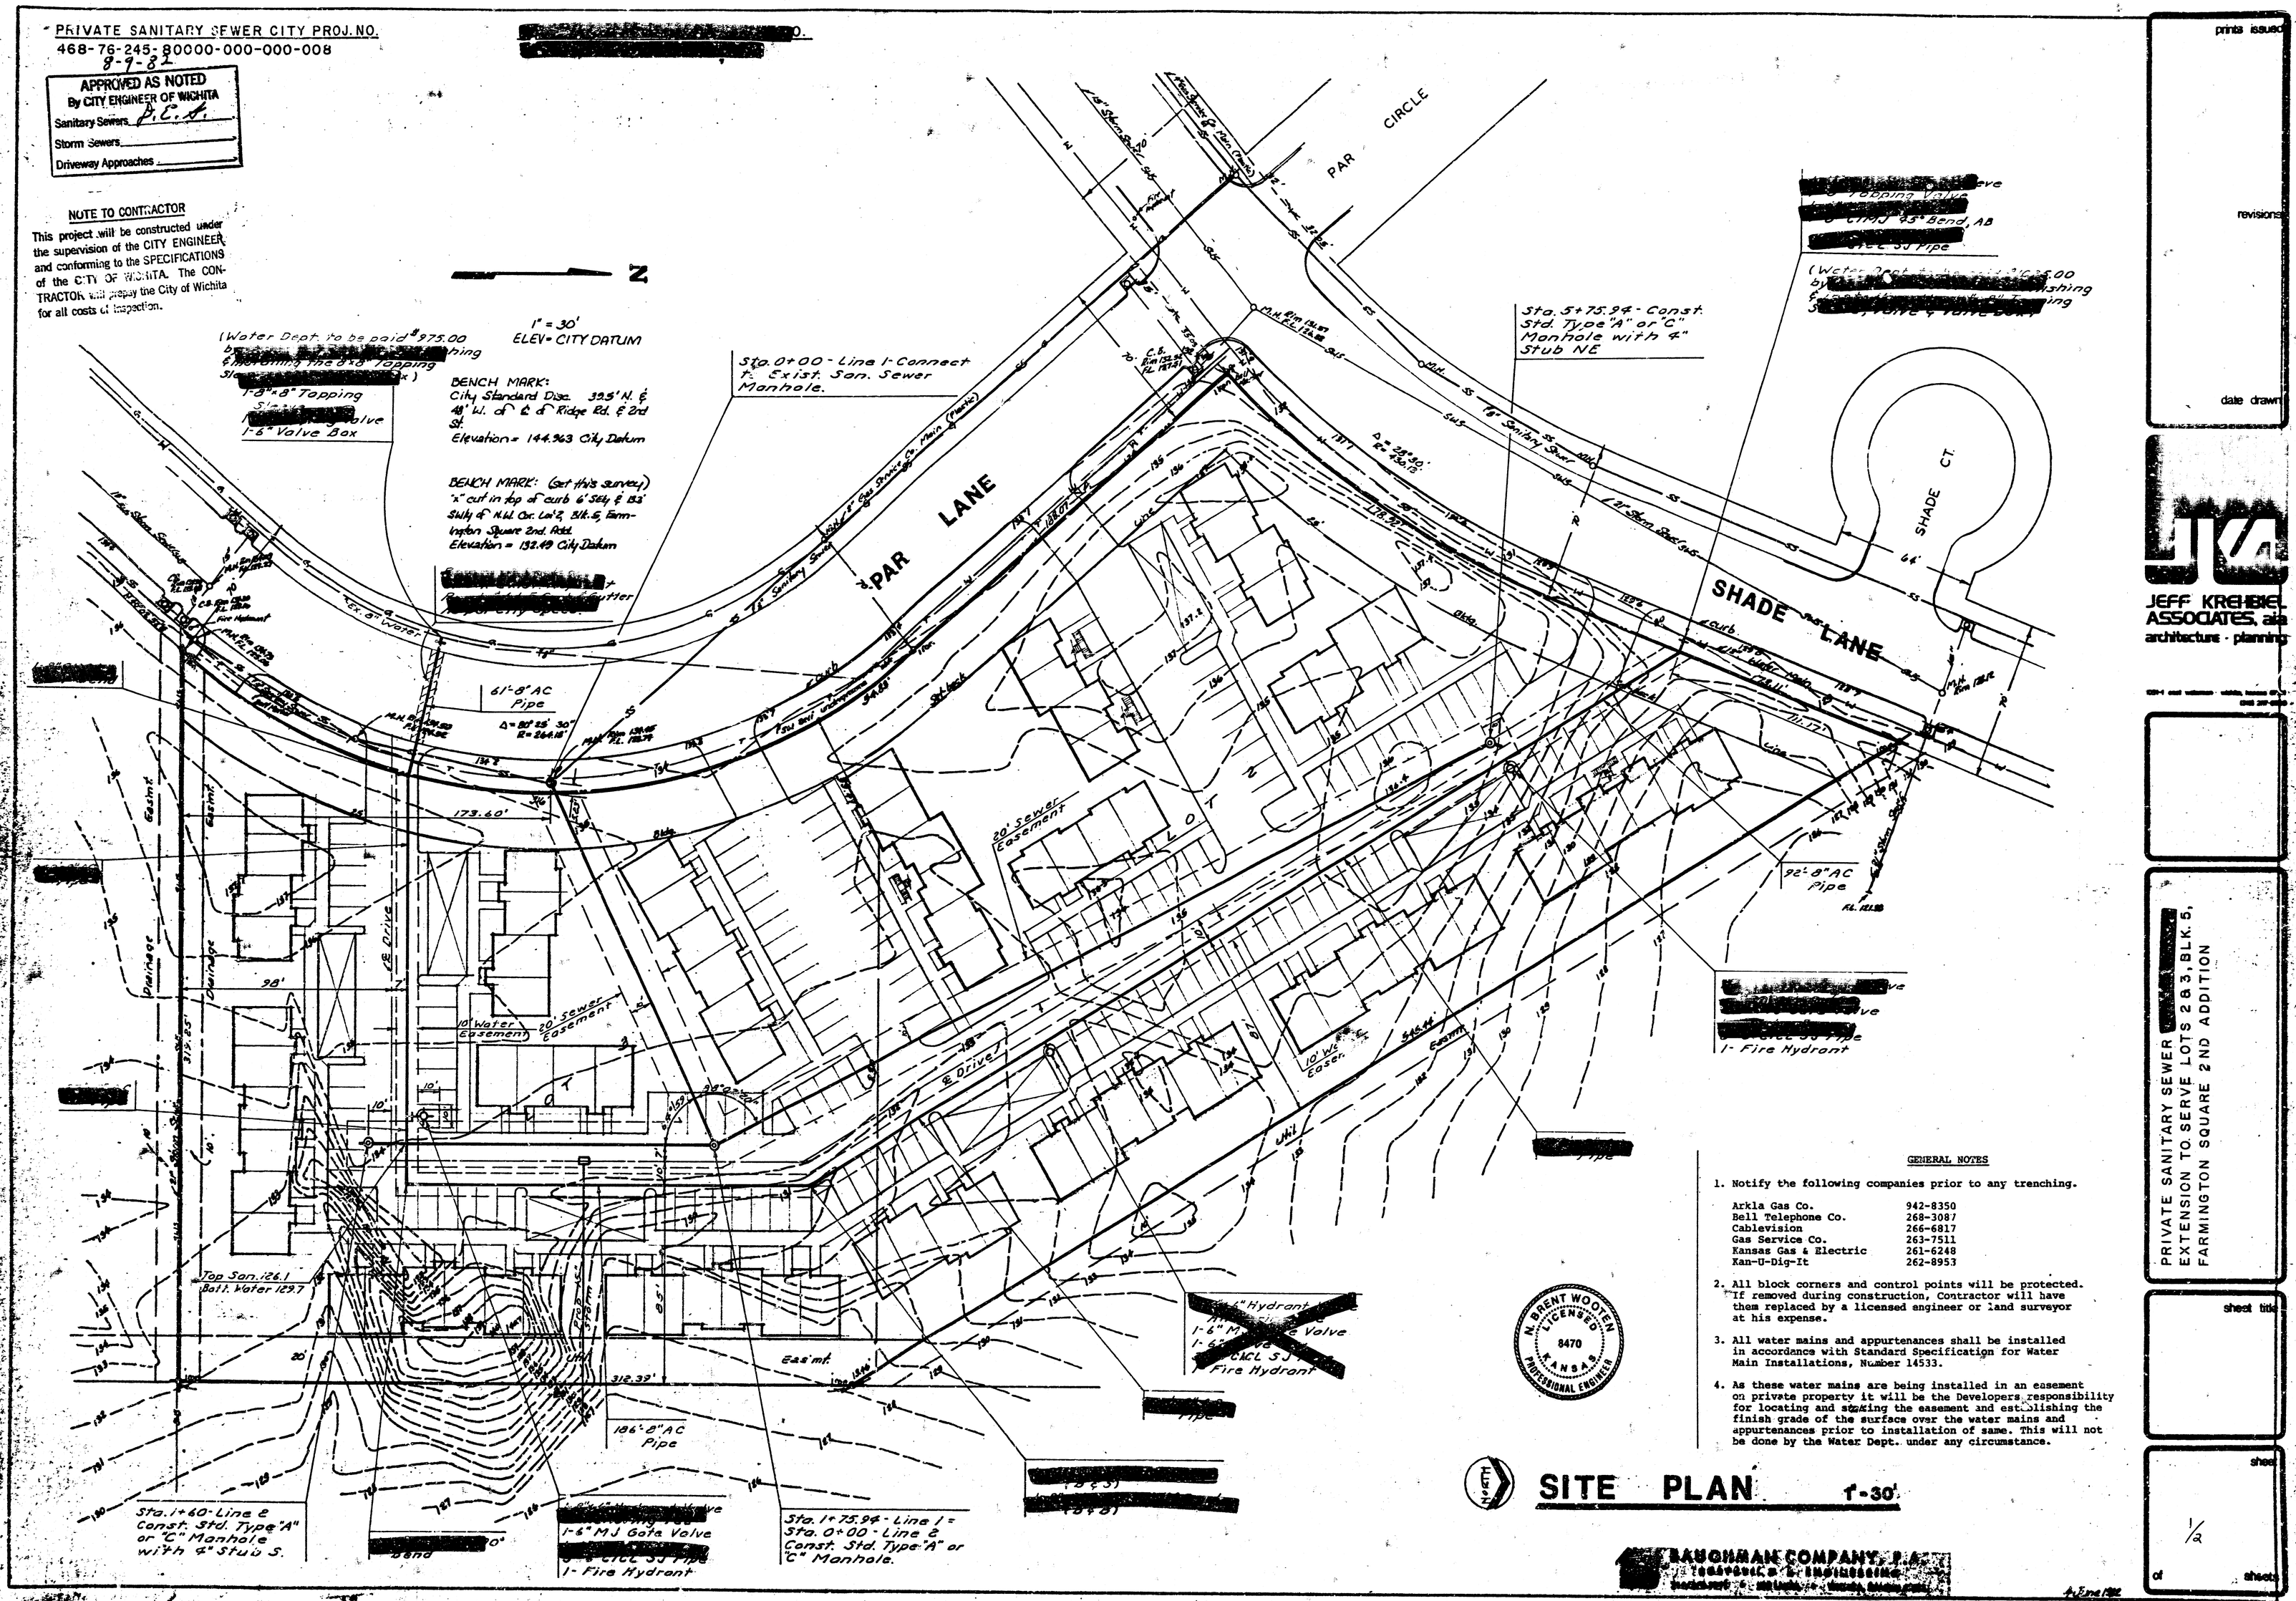

GENERAL NOTES

1. Notify the following companies prior to any trenching.

Arkla Gas Co.	942-8350
Bell Telephone Co.	268-3087
Cablevision	266-6817
Gas Service Co.	263-7511
Kansas Gas & Electric	261-6248
Kan-U-Dig-It	262-8953

2. All block corners and control points will be protected. If removed during construction, Contractor will have them replaced by a licensed engineer or land surveyor at his expense.

3. All water mains and appurtenances shall be installed in accordance with Standard Specification for Water Main Installations, Number 14533.

4. As these water mains are being installed in an easement on private property it will be the Developers responsibility for locating and staking the easement and establishing the finish grade of the surface over the water mains and appurtenances prior to installation of same. This will not be done by the Water Dept. under any circumstance.

N. BRENT WOOTEN LICENSED 8470 KANSAS PROFESSIONAL ENGINEER

NORTH

SITE PLAN 1"=30'

BAUGHMAN COMPANY, P.A.
CONSULTING & ENGINEERING
[redacted]

prints issued

revisions

date drawn

JKA
JEFF KREHBIEL ASSOCIATES, a.i.a.
architecture · planning

PRIVATE SANITARY SEWER [redacted]
EXTENSION TO SERVE LOTS 2 & 3, BLK. 5,
FARMINGTON SQUARE 2ND ADDITION

sheet title

sheet 1/2 of sheets

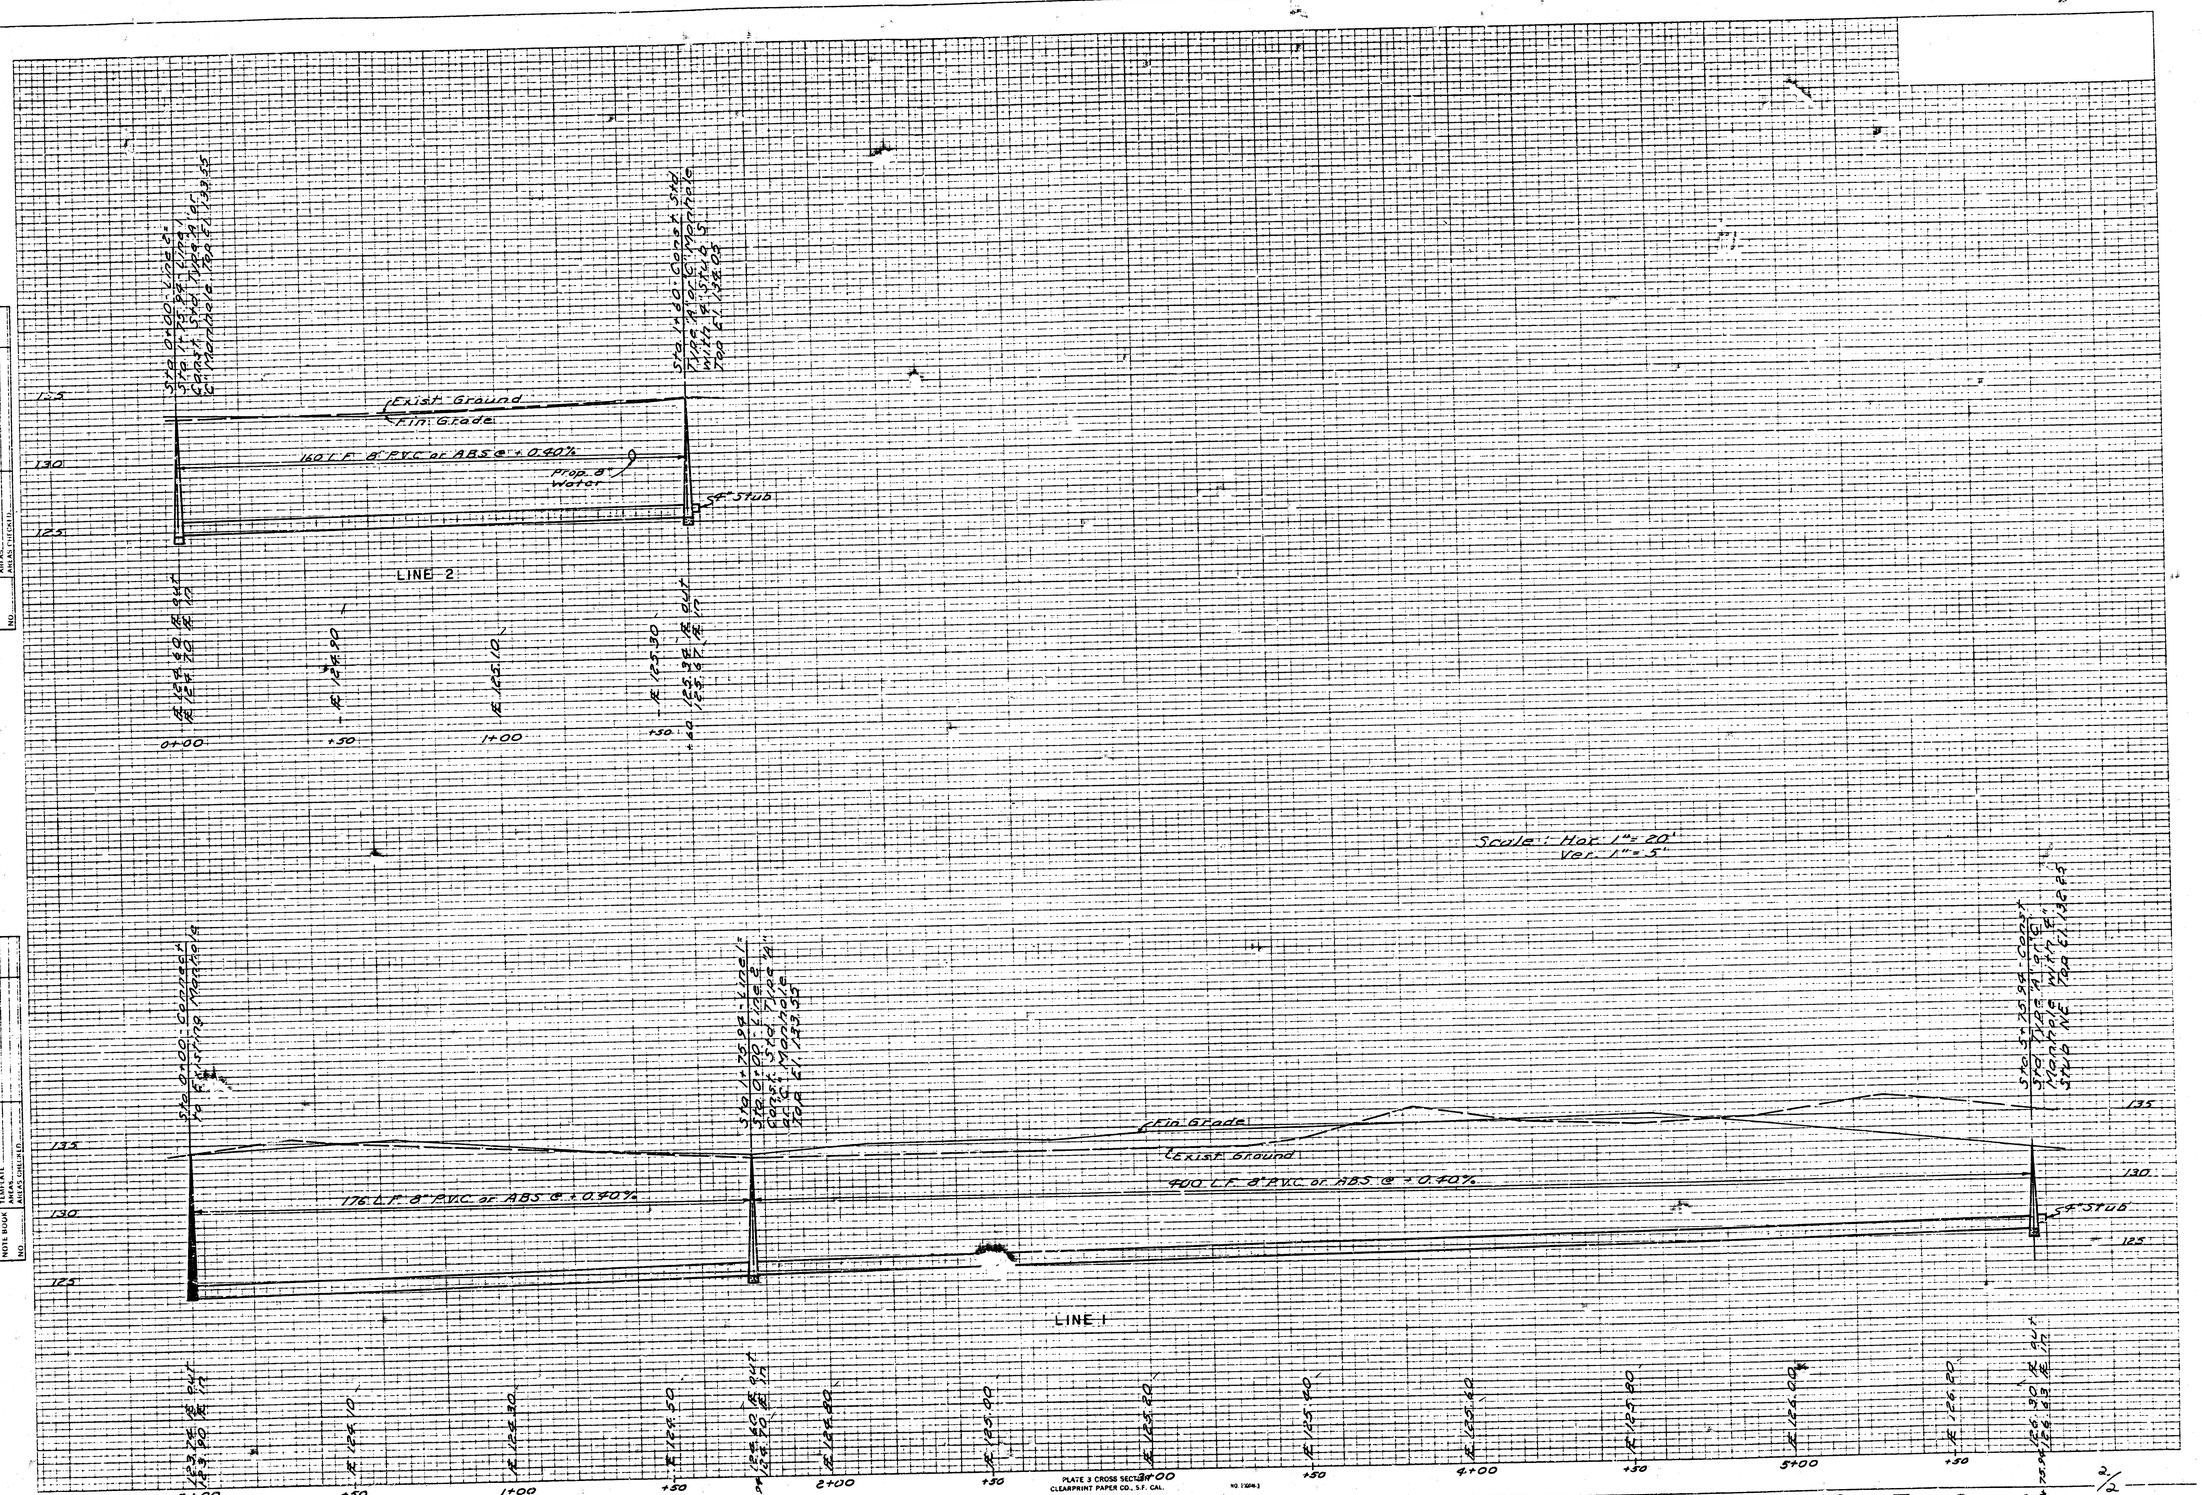

FINAL SURVEY | SURVEYED | PLOTTED | NOTE BOOK | TEMPLATE | AREAS | AREAS CHECKED | NO. | BY | DATE

FINAL SURVEY | SURVEYED | PLOTTED | NOTE BOOK | TEMPLATE | AREAS | AREAS CHECKED | NO. | BY | DATE