



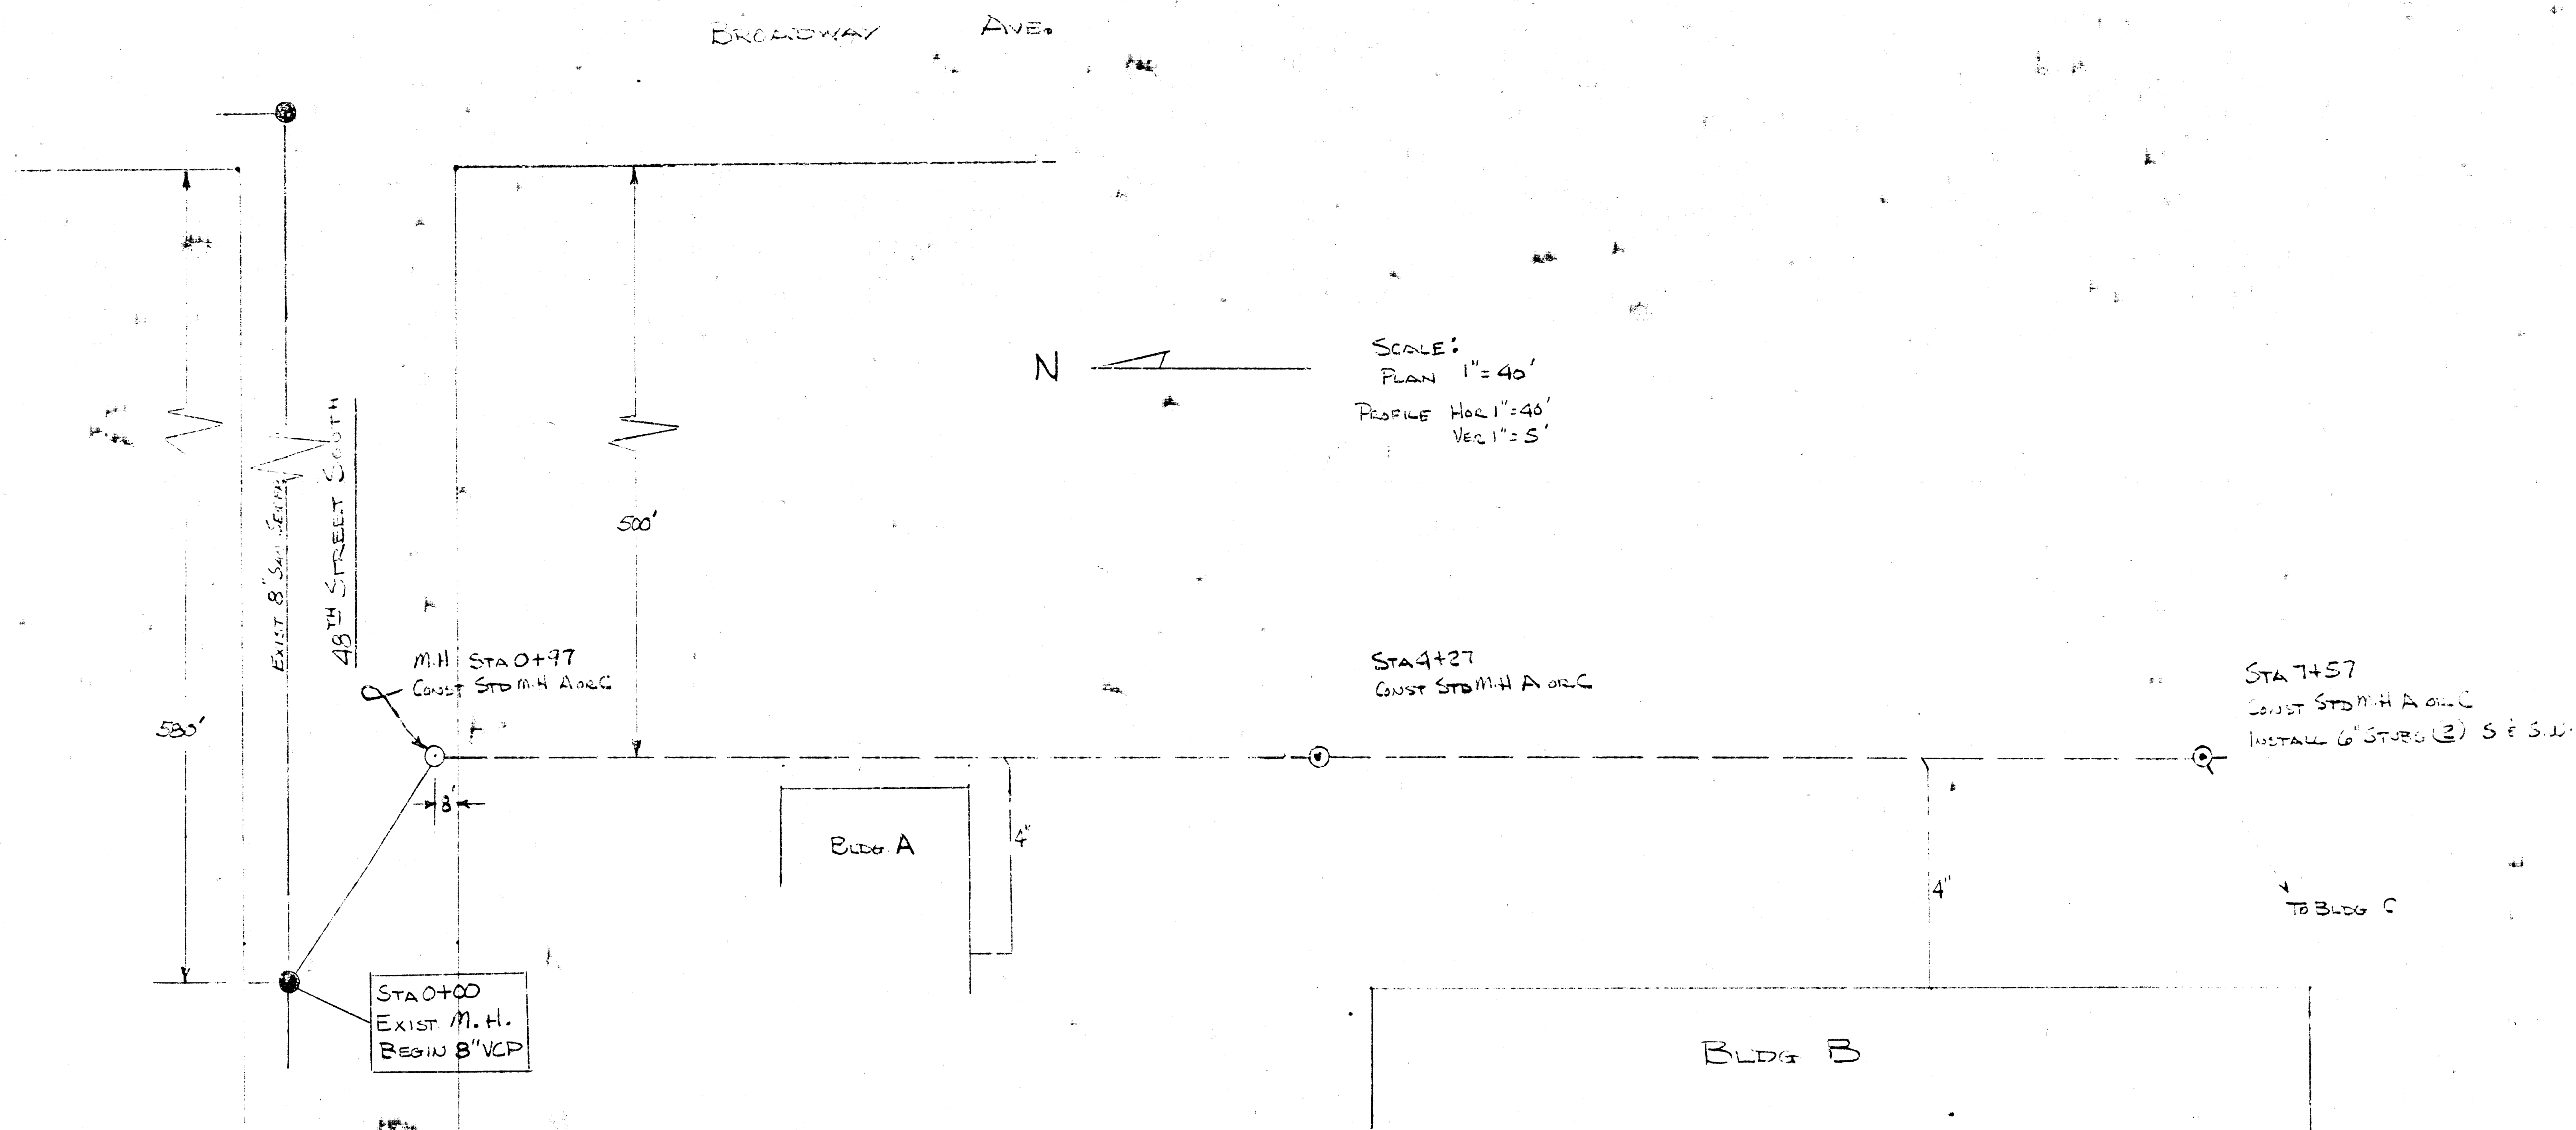

8-28-78

APPROVED AS NOTED
 BY CITY ENGINEER C. J. C. III
 Sanitary Sewers: *PCJ*
 Storm Sewers: _____
 Driveway Approaches: _____

NOTE TO CONTRACTOR

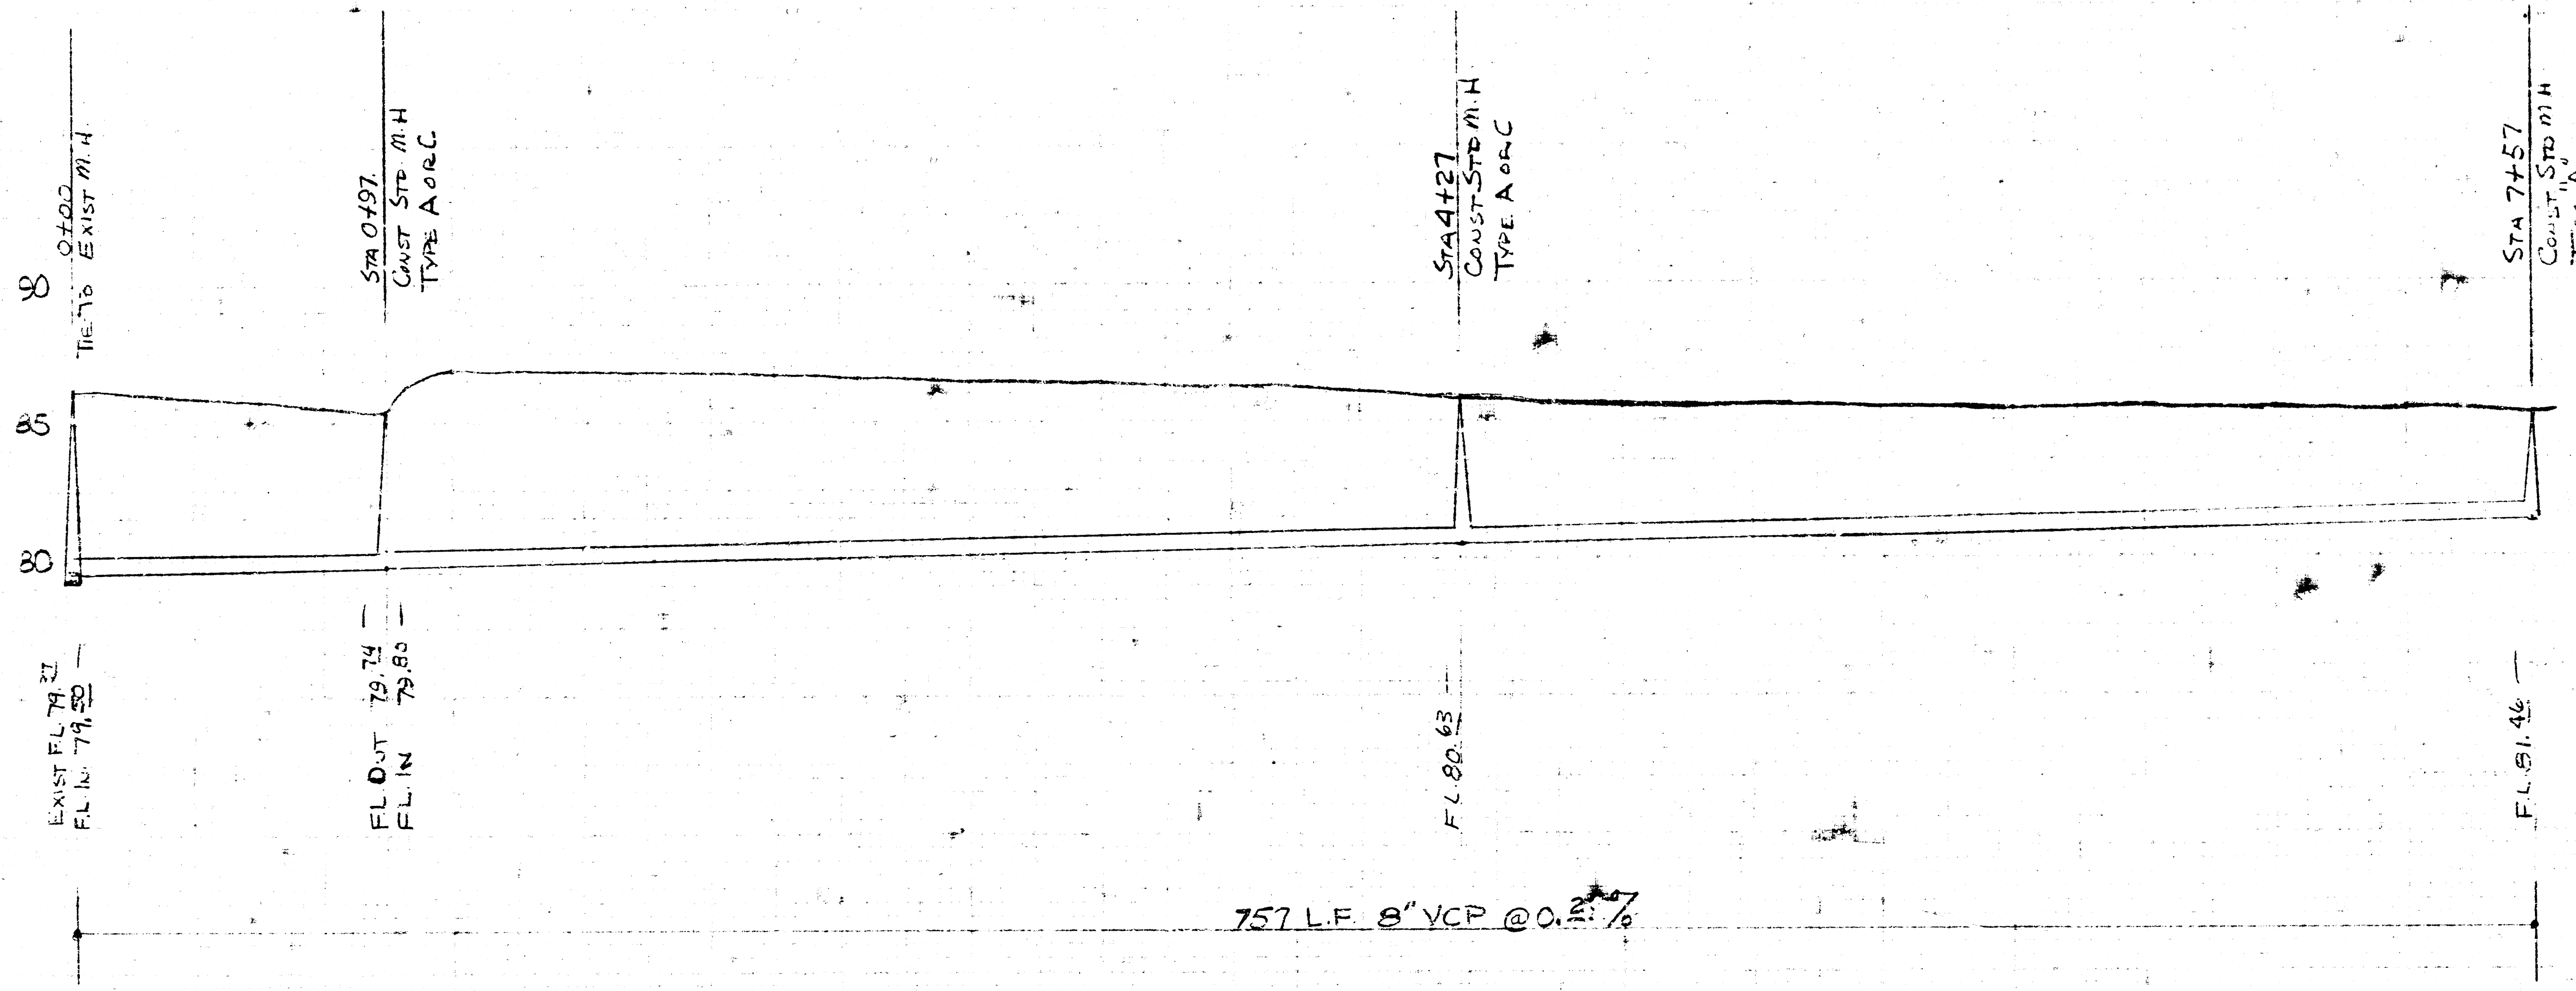

SANITARY SEWER EXTENSION
 FOR
 FIREBALL INDUSTRIES
 48TH ST SOUTH & BROADWAY
 MID STATES CONST. CO., INC. AUG - 78
 PROJ. NO. 468-76-245-80590-NON-000-008