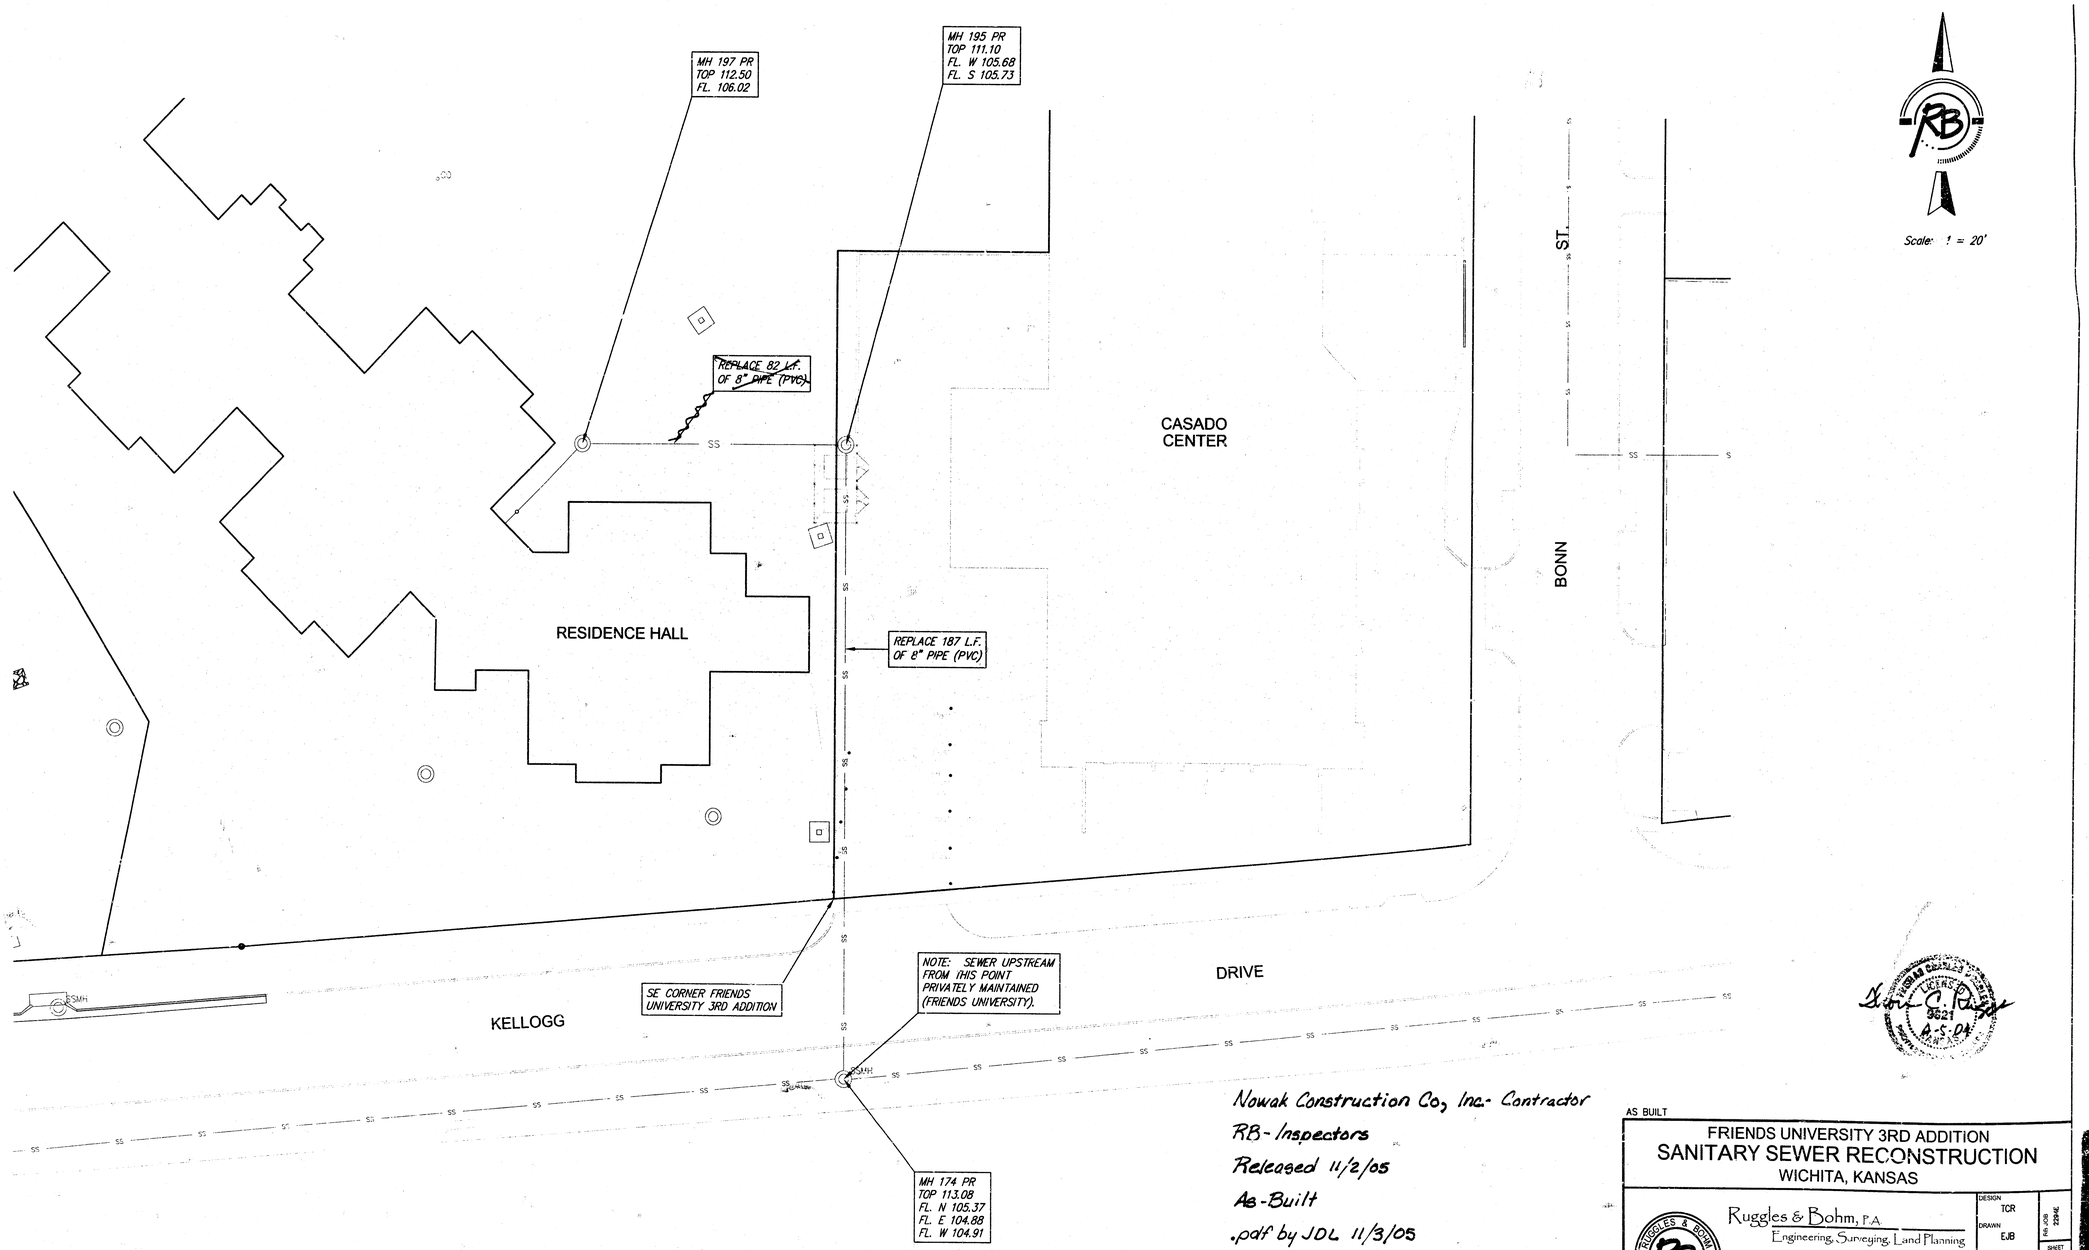

Nowak Construction Co, Inc- Contractor
RB- Inspectors
Released 11/2/05
As-Built
.pdf by JDL 11/3/05

AS BUILT

FRIENDS UNIVERSITY 3RD ADDITION
SANITARY SEWER RECONSTRUCTION
WICHITA, KANSAS

Ruggles & Bohm, P.A.
Engineering, Surveying, Land Planning
924 North Main
Wichita, Kansas 67203
www.rbkansas.com
(316) 264-8008
(316) 264-4621 fax
E-mail: info@rbkansas.com

DESIGN	TCR
DRAWN	EJB
REVIEW	
UTILITY	
DATE	Apr. 5, 2004
RB JOB	22946
SHEET	1 OF 1
DRAWING FILE	Base {As Built}
PROJECT NUMBER	1411 PPS (607861)