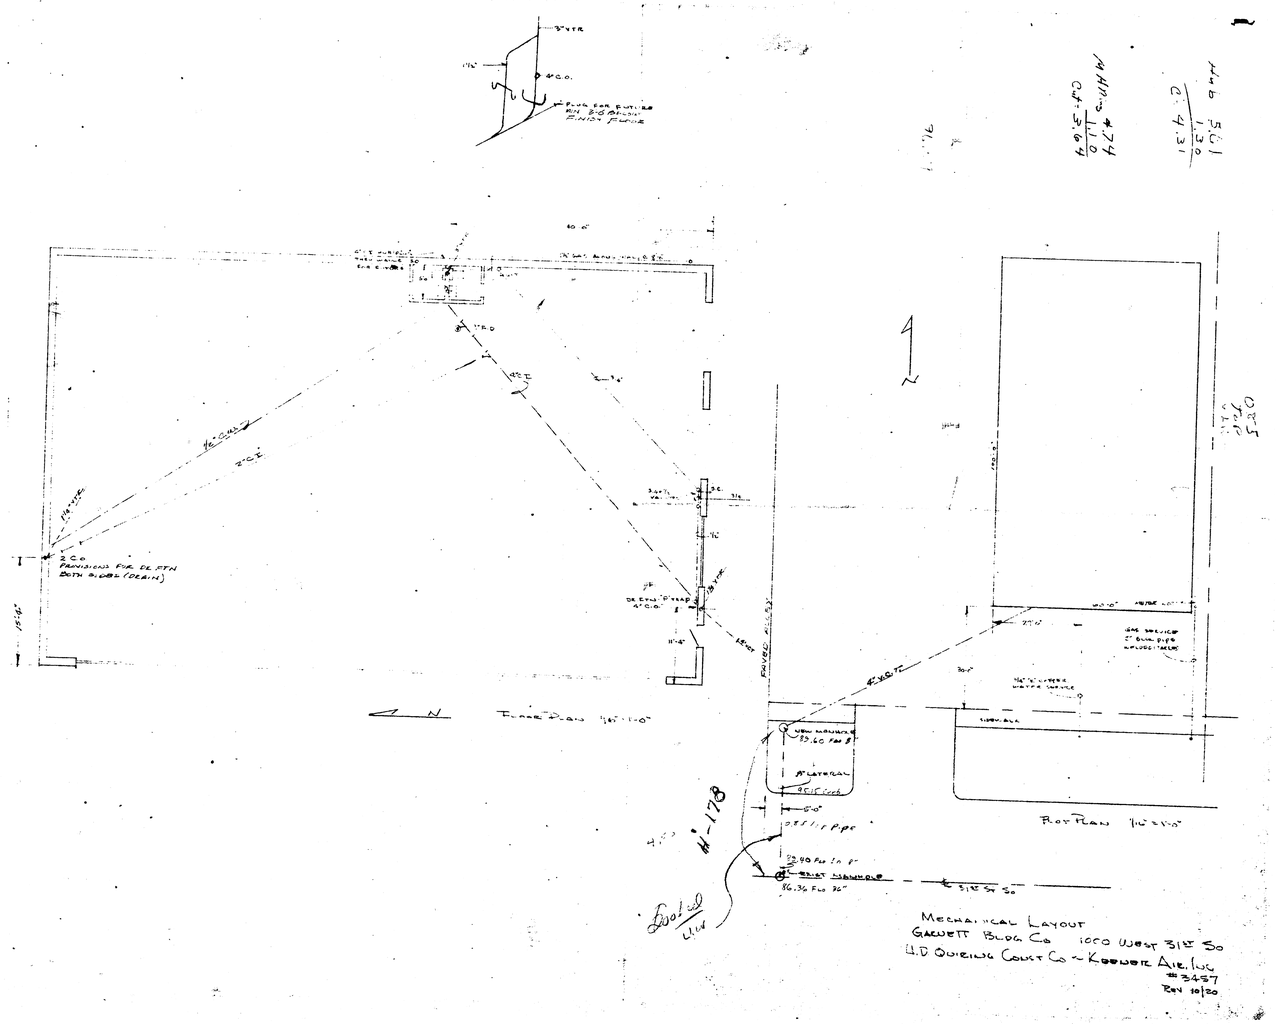
Floor Plan
Plot Plan
Mechanical Layout
Garrett Block Co 1000 West 31st So
U.D Quieing Court Co ~ Koenig Air, Inc
#3457
Rev 10/20
Hi-178
Sealed
4-14