



18m 168.59 Stand SW Douglas & Oliver
172.71 x on W side. Distance 10 N of NE Douglas

 

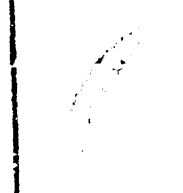

CARMICHAEL WHEATCROFT & ASSOCIATES
ARCHITECTS • ENGINEERS



Professional Engineer Seal

