

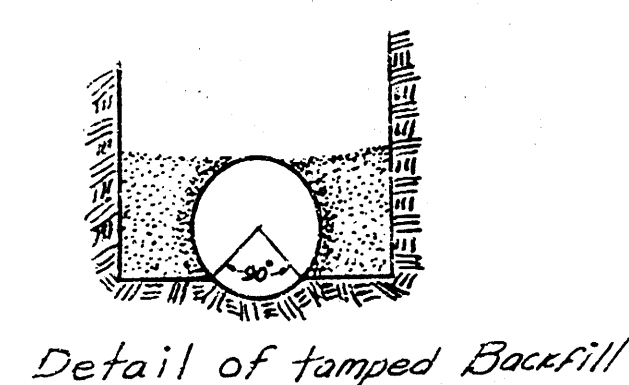
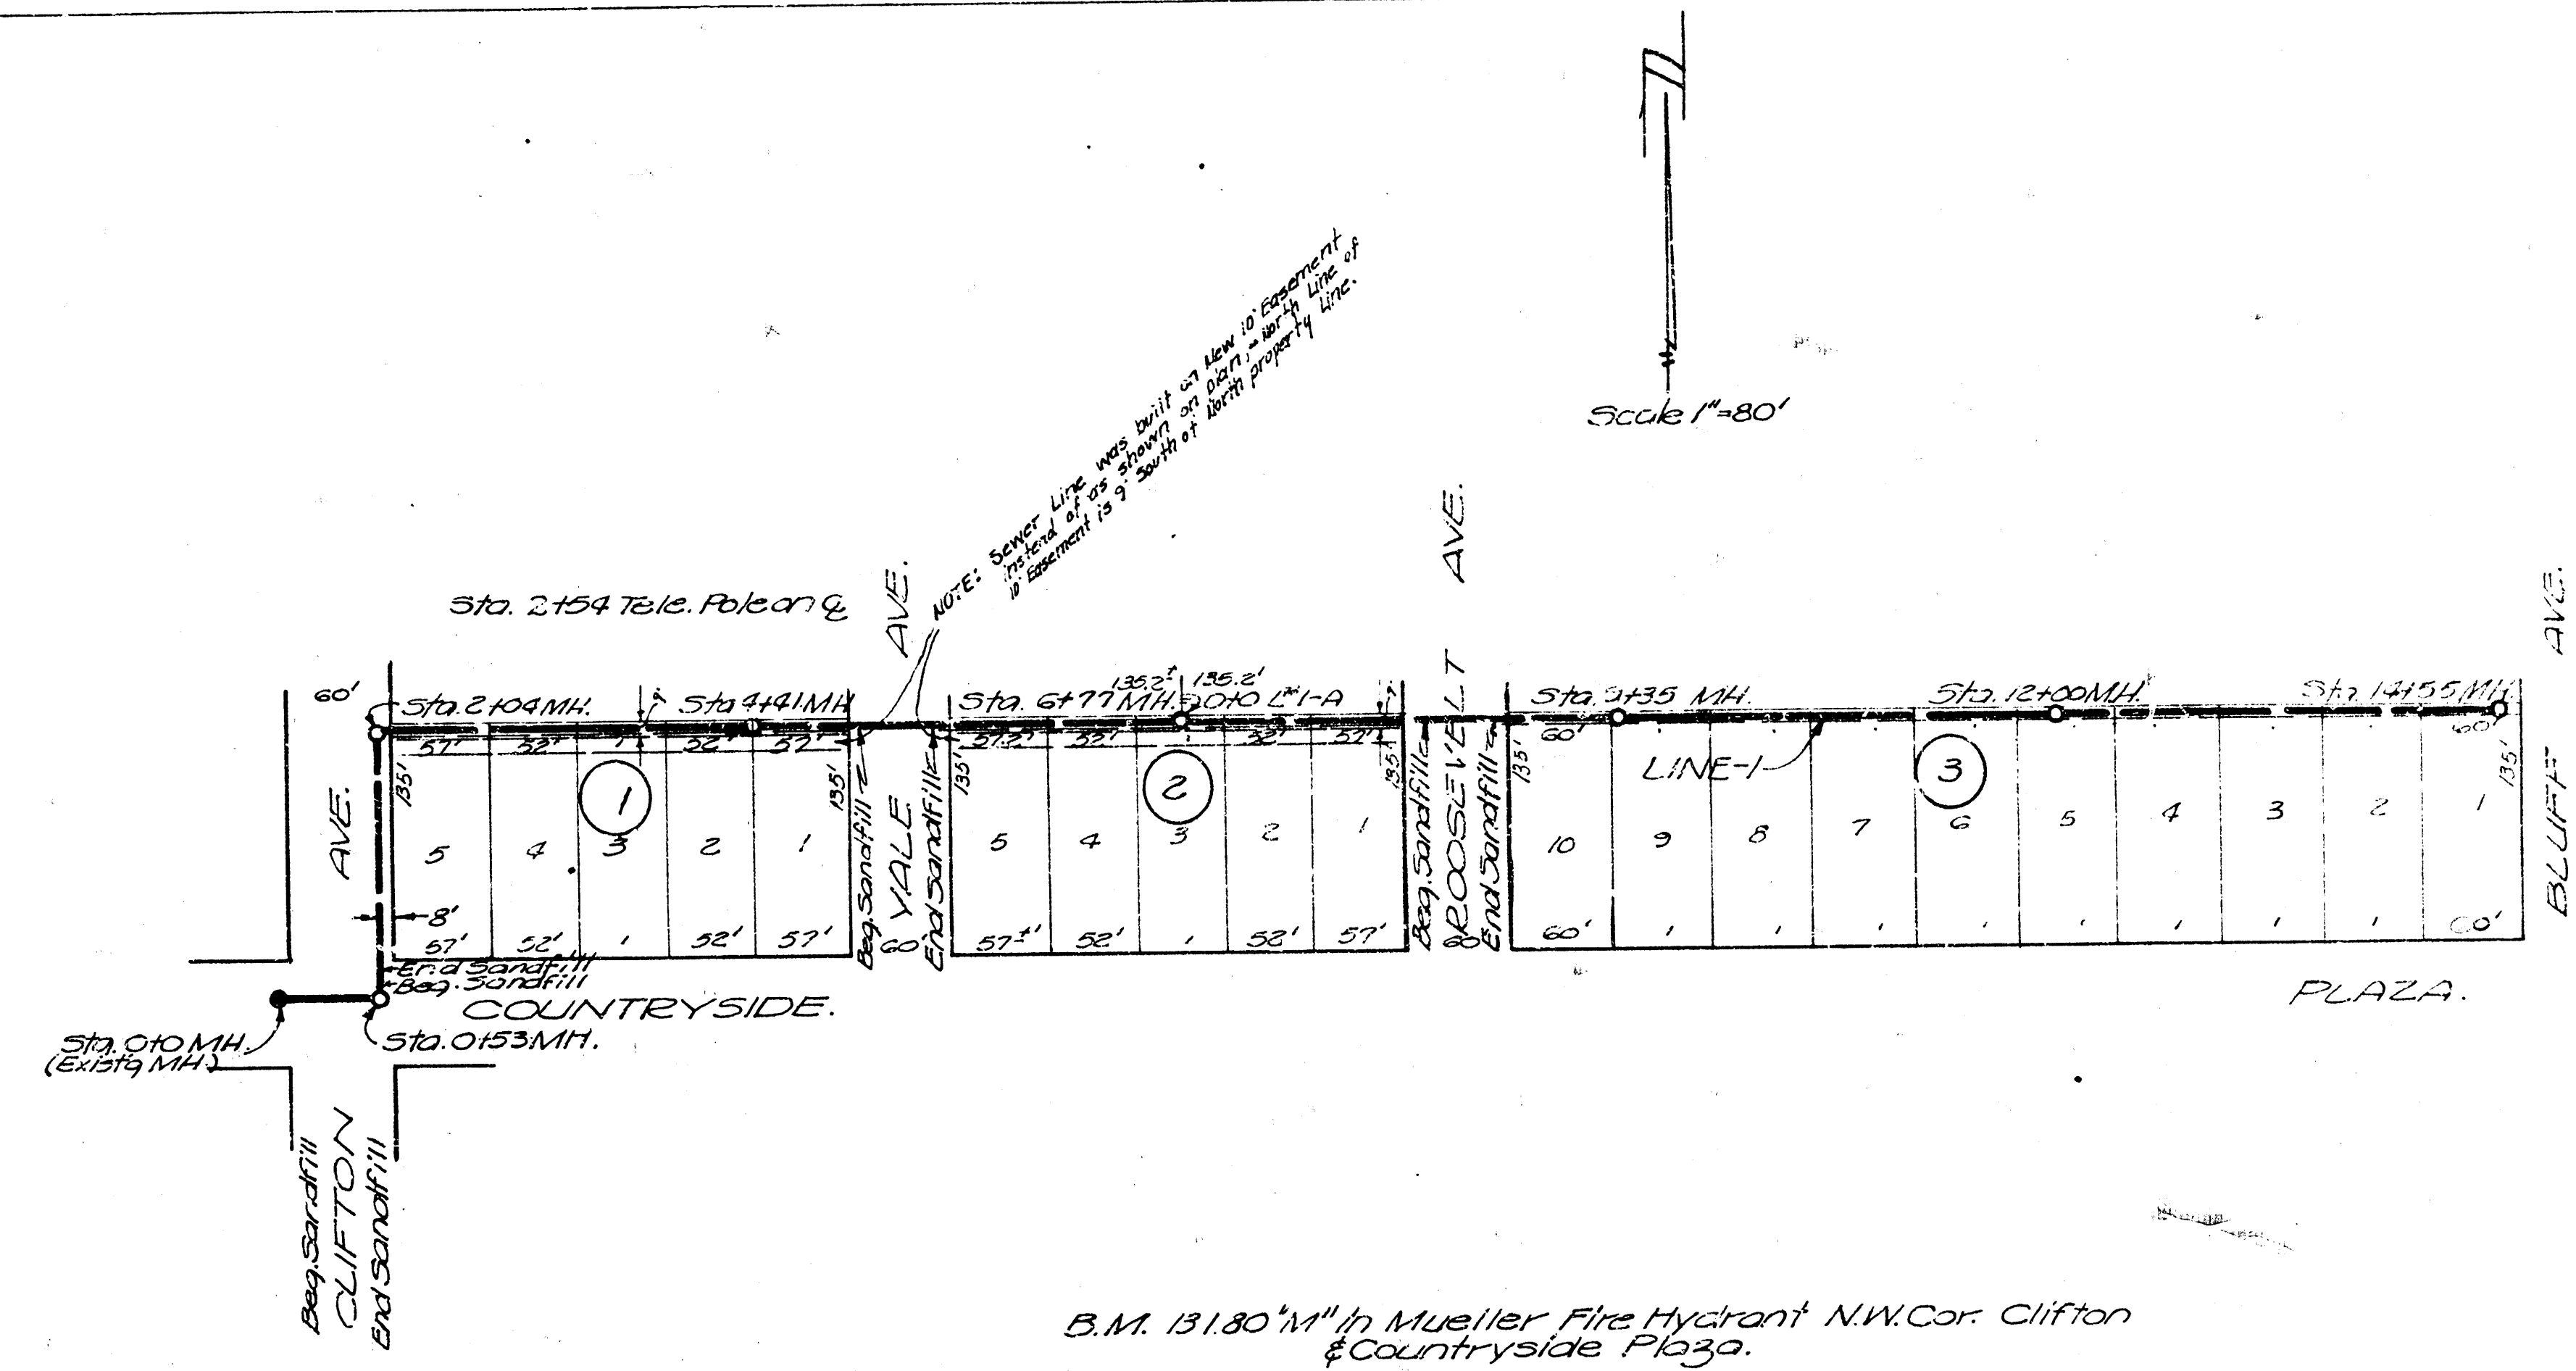
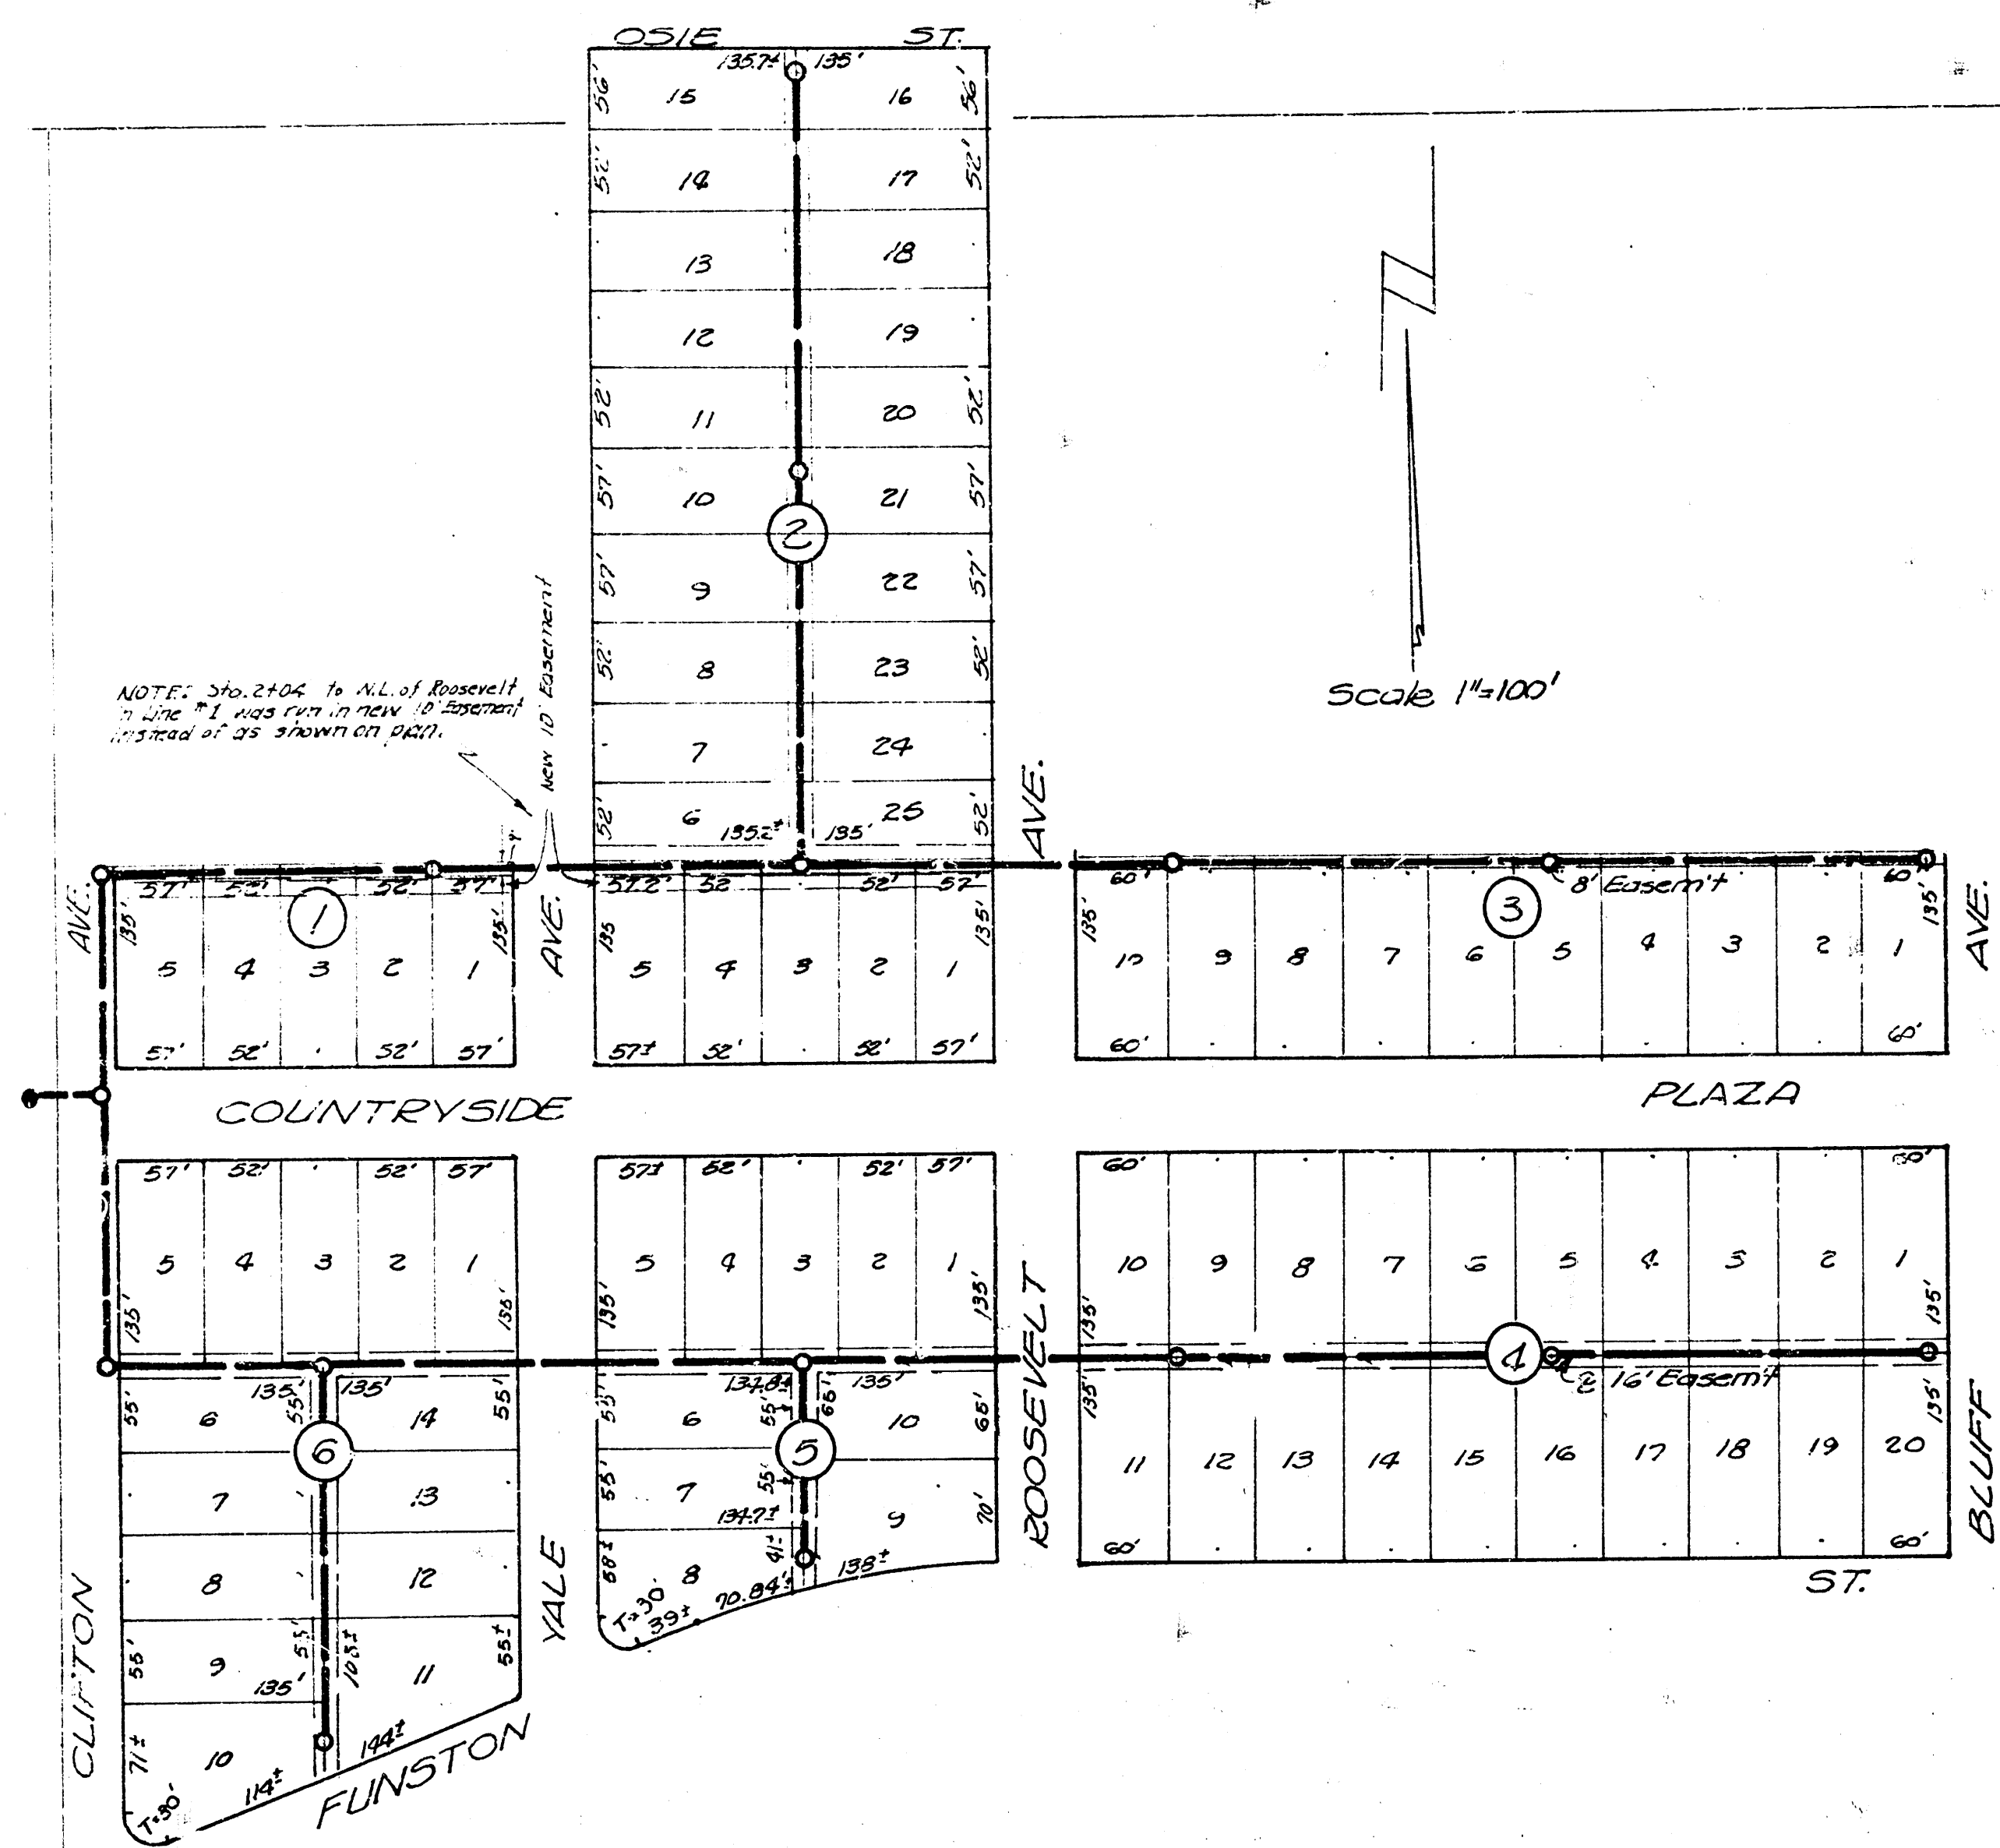


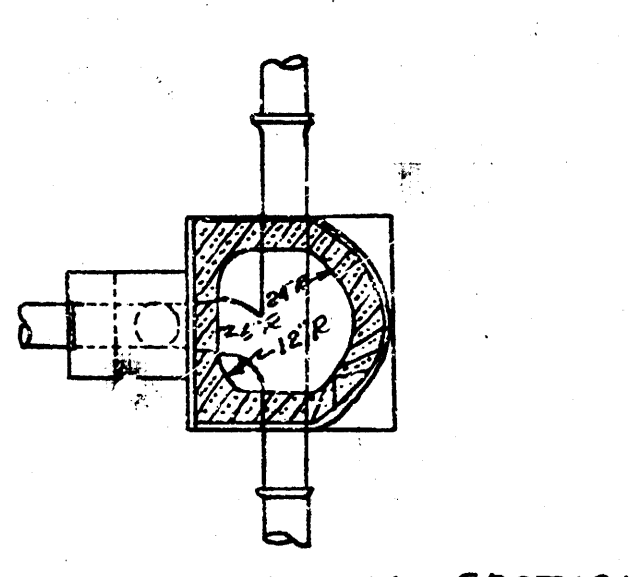


PIPE	24" TRENCH	27" TRENCH	30" TRENCH
8"	13'	NONE	10'
10"	13'	NONE	11'
12"	13'	NONE	14'
15"	13'	NONE	17'
18"	13'	NONE	20'

NOTE: If tamped backfill is not considered practical due to condition of ditch, sandfill to the top of pipe by the order of the City Engineer.

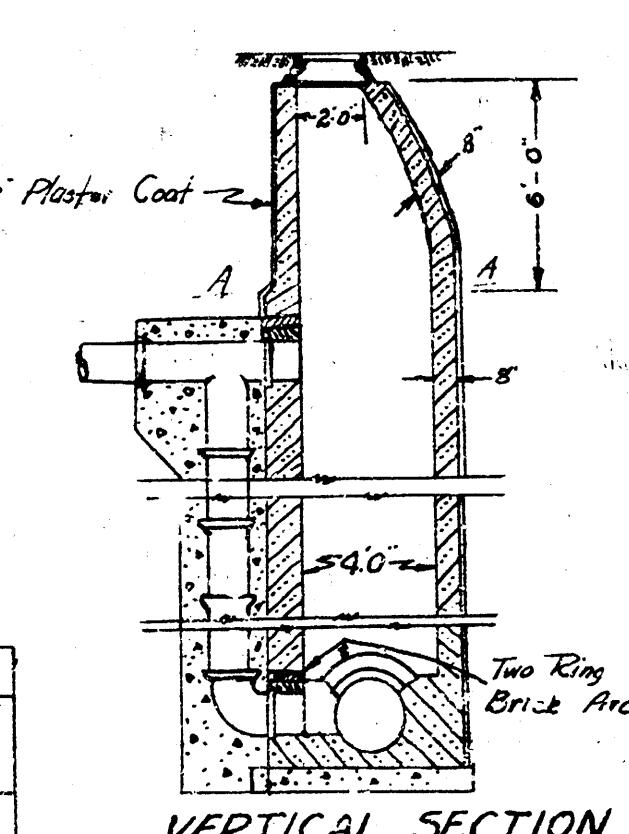

DETAIL OF SPECIAL MANHOLE Sta. 4+41

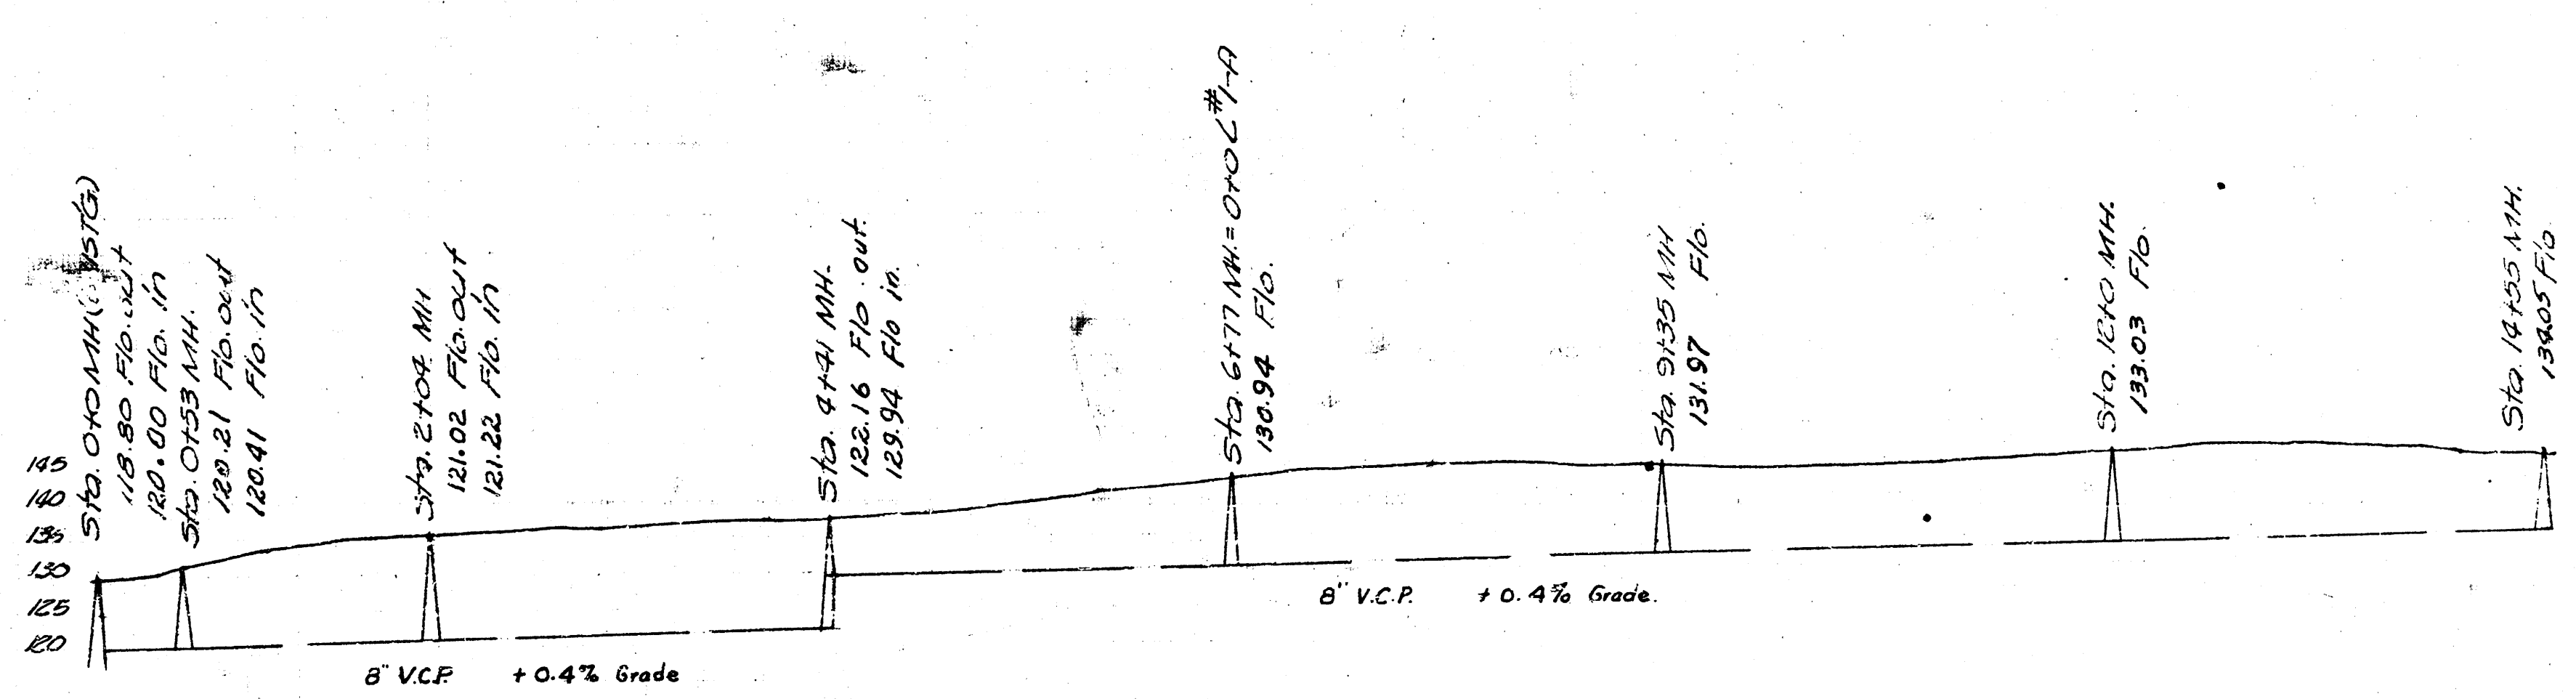

Sanitary Sewer Grandview Heights Addn.
City of Wichita, Kansas
Private Job

