

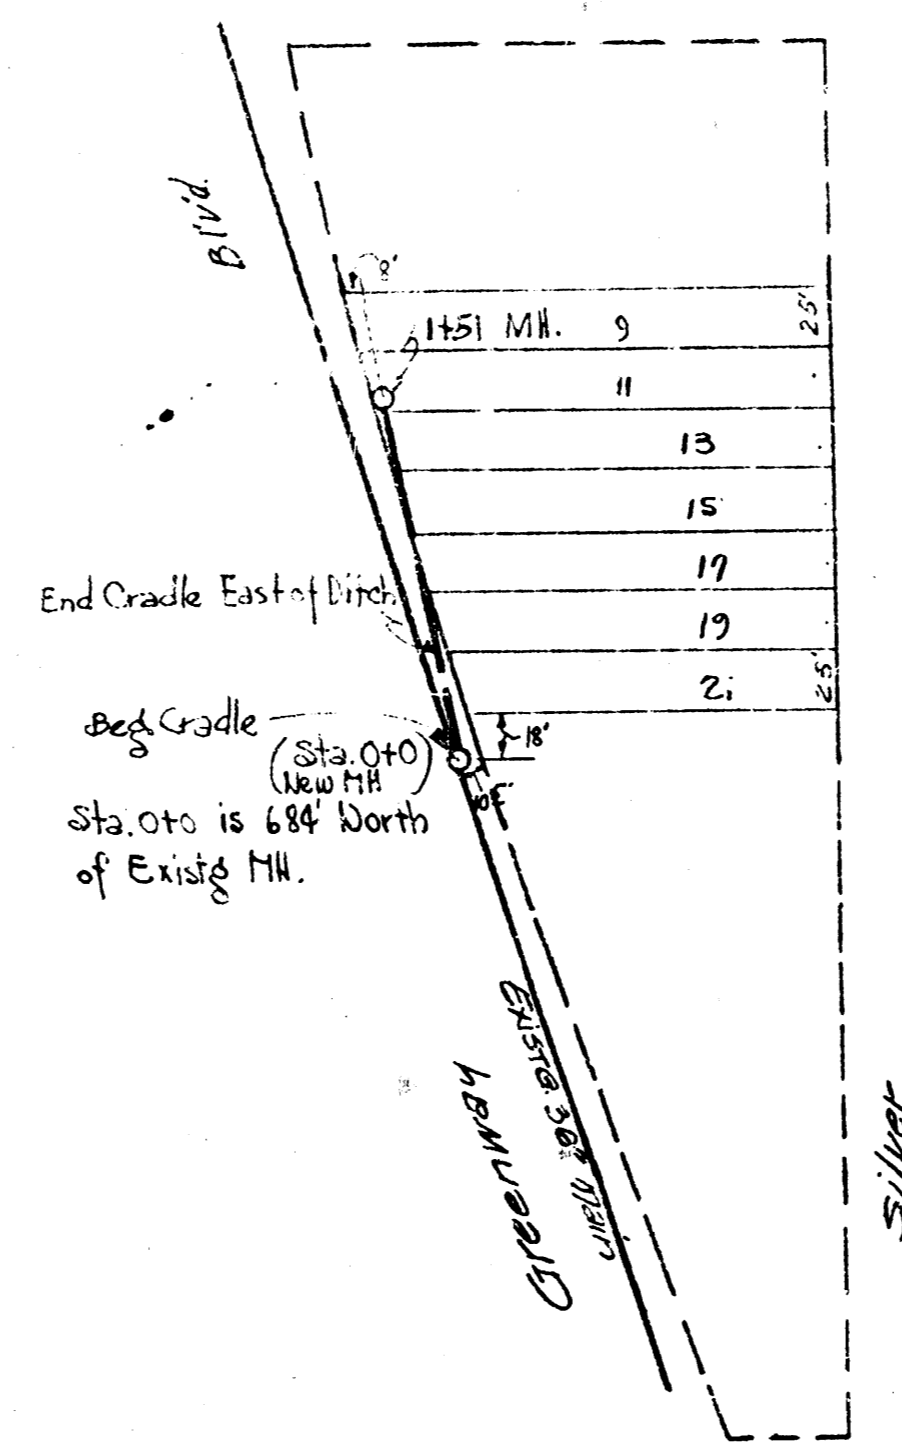
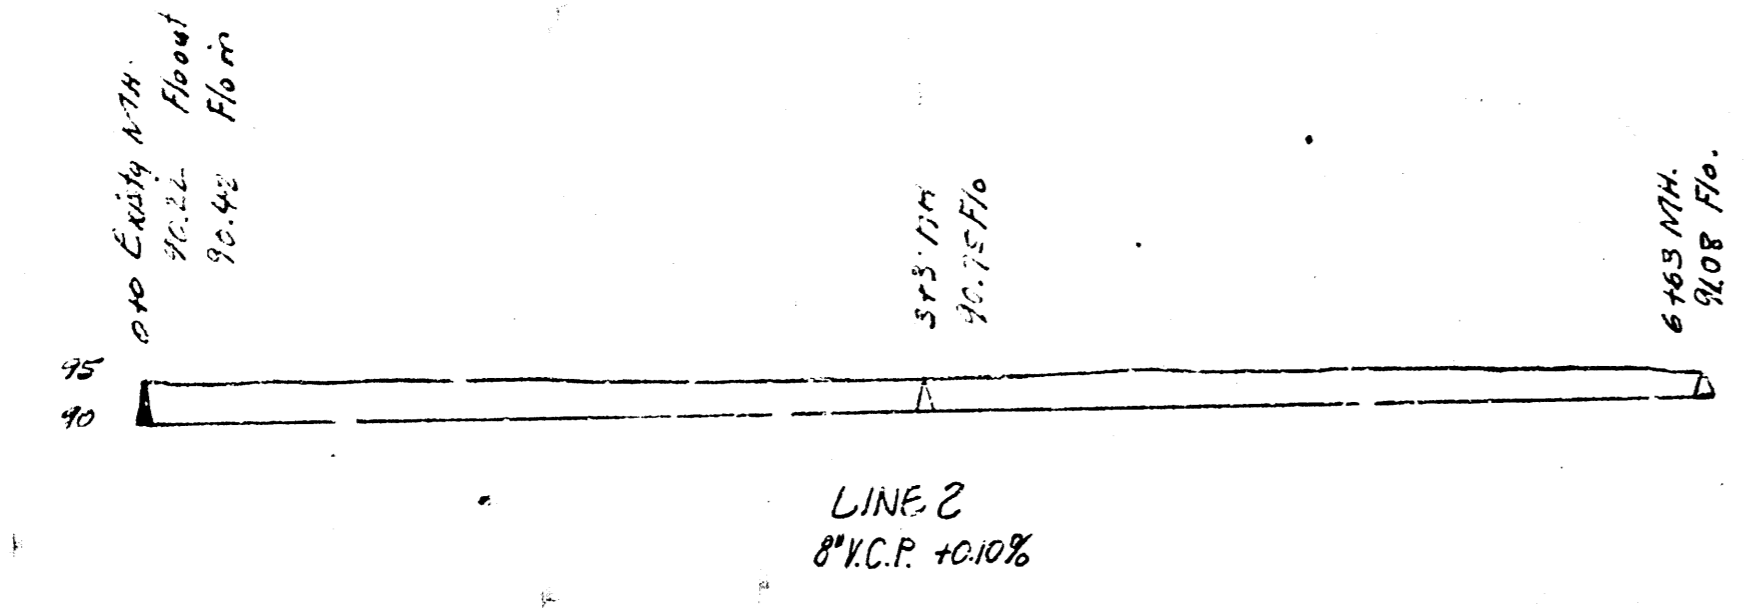


Sta. 97.57 S.W. Cor. Conc. Parot N.E. Cor. Ellis & Marion Ed.
 B.M. 97.63 N.W. Cor. Conc. Parot N.E. Cor. Lulu & Marion Ed.

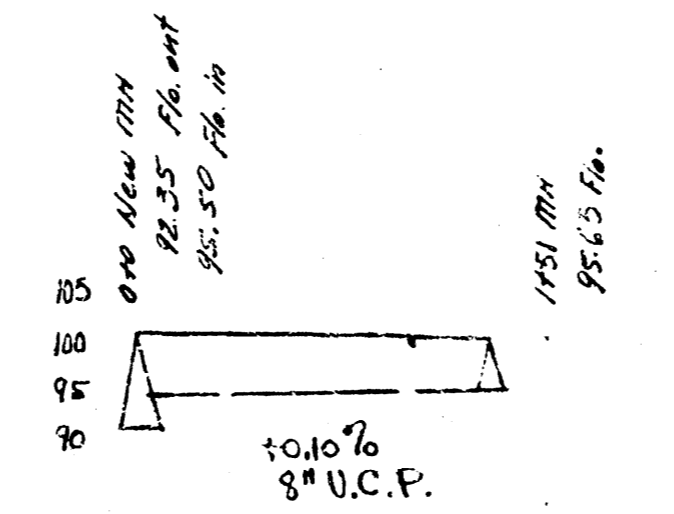

VOID BEACH M.H.
 B.M. 102.12 So. Rm. M.H. Sta. 100.102
 B.M. 103.19 Top Conc. Post U.C.P. Code

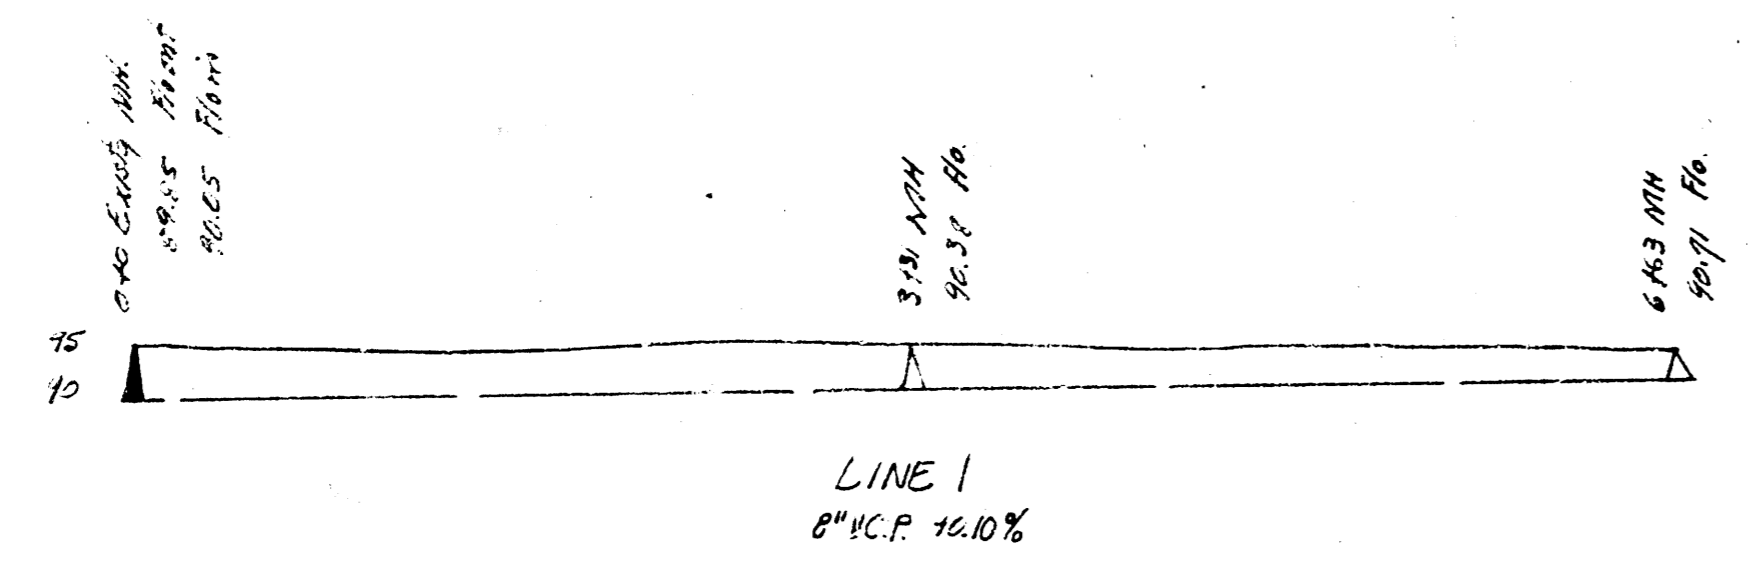

Private Sanitary Sewer Contracts
 City of Wichita, Kansas
 L.K. White City Engineer
 Date 9-21-50