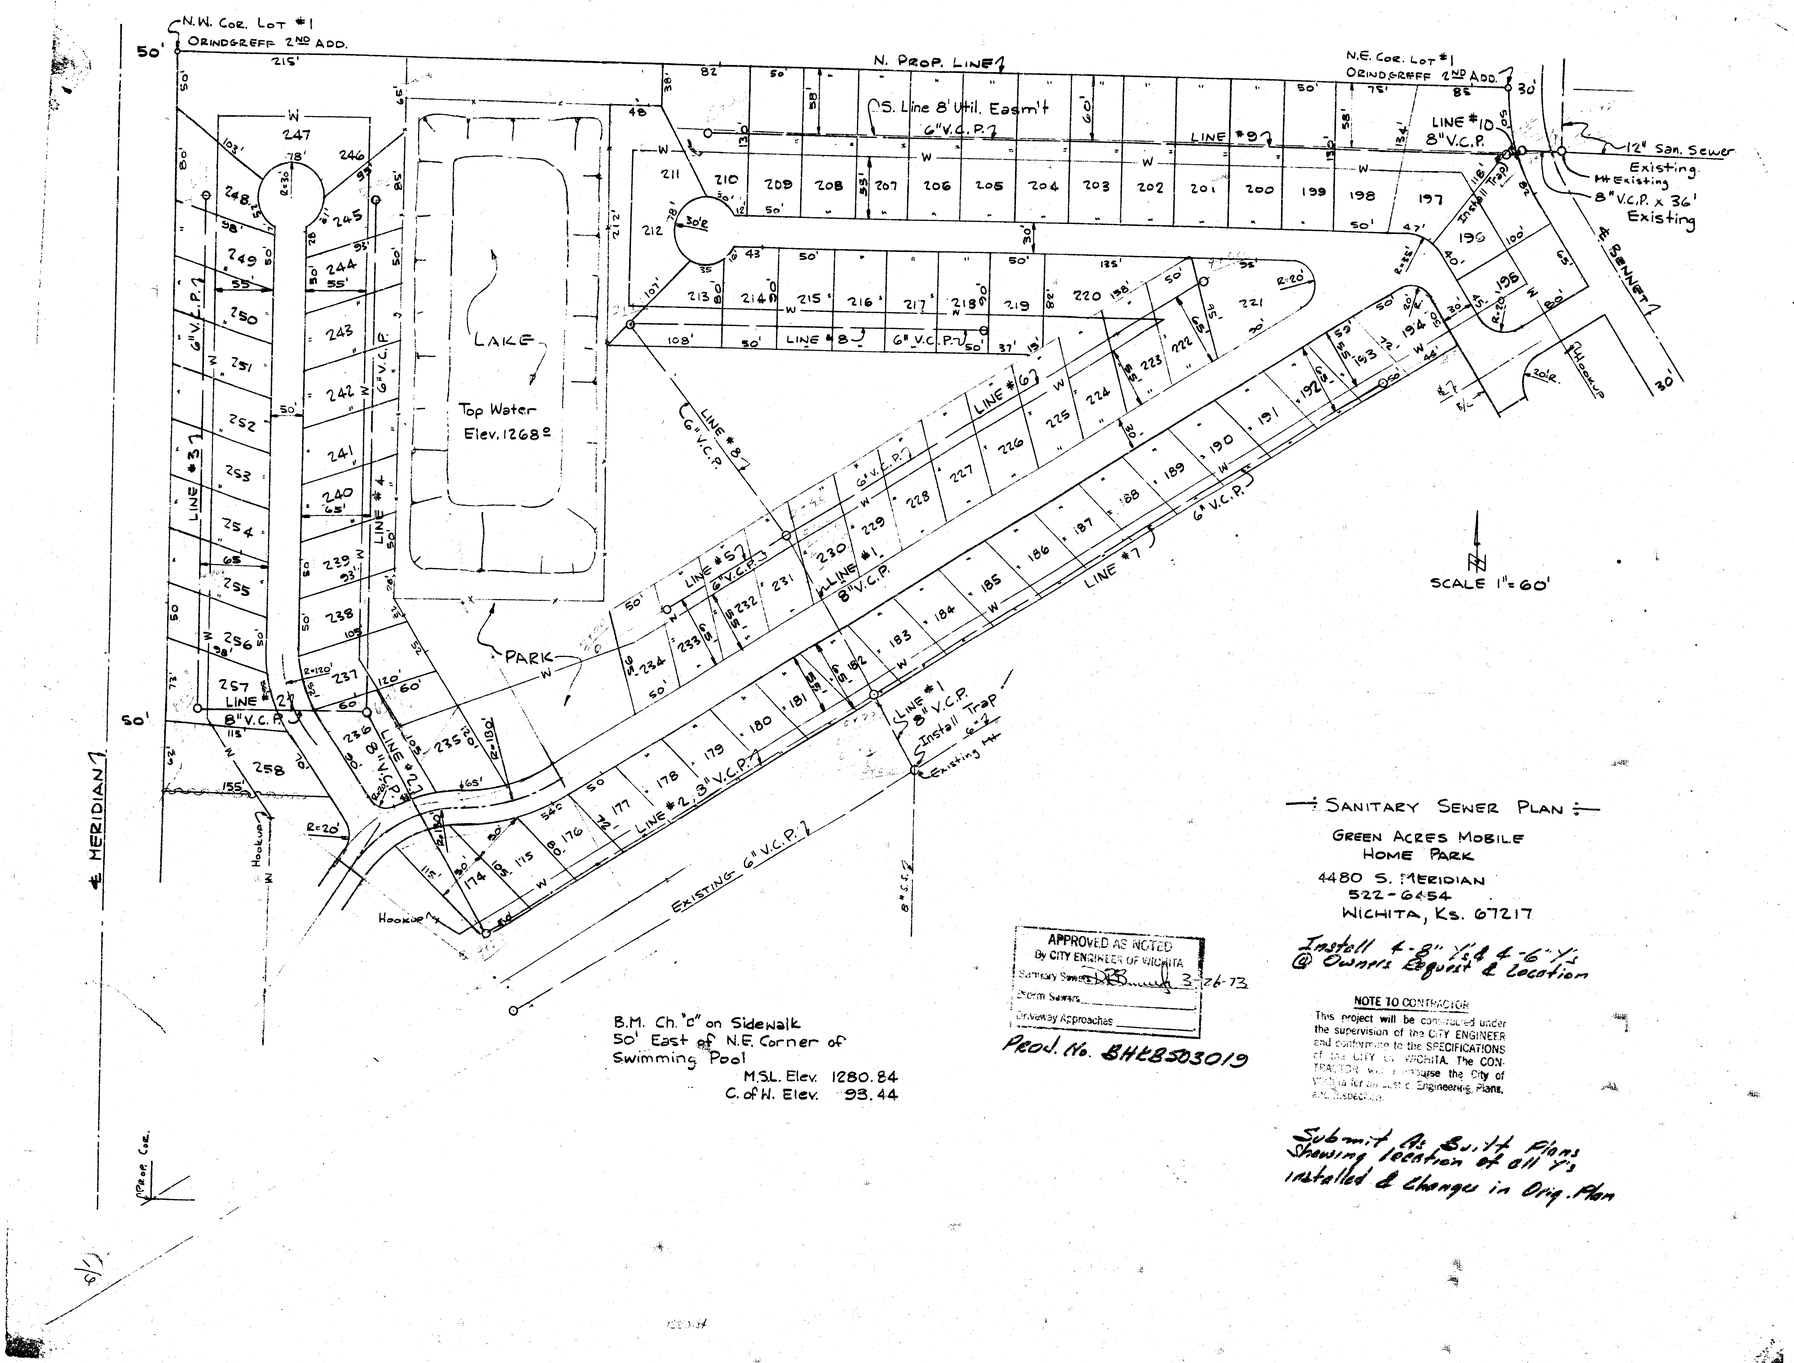


B.M. Ch. "C" on Sidewalk
50' East of N.E. Corner of
Swimming Pool
M.S.L. Elev. 1280.84
C. of W. Elev. 93.44

APPROVED AS NOTED
By CITY ENGINEER OF WICHITA
Sanitary Sewers 3-26-73
Storm Sewers
Driveway Approaches

Prod. No. BH28503019

Sanitary Sewer Plan

Green Acres Mobile
Home Park
4480 S. Meridian
522-6454
Wichita, Ks. 67217

Install 4-8" Y's & 4-6" Y's
@ Owners Request & Location

NOTE TO CONTRACTOR

This project will be constructed under the supervision of the CITY ENGINEER and conformance to the SPECIFICATIONS of the CITY OF WICHITA. The CONTRACTOR [illegible] the City of Wichita Standard Engineering Plans, and Specifications.

Submit As Built Plans
Showing location of all Y's
installed & change in Orig. Plan

GREEN ACRES MOBILE HOME RESORT
"Y" LOCATIONS SAN. SEWERS SHEET 2 OF 2

LINE #7	NOTE
0+00	MH
0+38	Y
0+88	Y
1+28	Y
1+81	Y
2+38	Y
2+81	Y
3+28	Y
3+81	Y
4+28	Y
4+88	Y
5+31	Y
5+88	Y
6+00	MH

LINE #8	NOTE
0+00	MH
1+00	Y
2+48	MH
2+65	Y
3+60	Y
4+00	Y
4+50	Y
5+00	Y
5+50	Y
5+78	MH

LINE #9	NOTE
0+00	MH
0+20	Y
1+10	Y
1+72	Y
2+22	Y
2+72	Y
3+22	Y
3+72	Y
4+27	Y
4+77	Y
5+22	Y
5+72	Y
6+22	Y
6+72	Y
7+25	Y
8+00	MH

GREEN ACRES MOBILE HOME RESORT
"Y" LOCATIONS SAN. SEWERS

No Y's LINE #1

LINE #2	NOTE
0+00	MH
0+08	Y
0+58	Y
1+08	Y
1+58	Y
2+02	Y
2+58	Y
3+08	Y
3+58	Y
4+20	MH
4+55	Y
5+69	Y
6+09	Y
7+85	Y
8+09	MH

LINE #3	NOTE
0+00	MH
0+31	Y
0+81	Y
1+31	Y
1+81	Y
2+31	Y
2+81	Y
3+31	Y
3+81	Y
4+31	Y
4+81	Y
5+10	MH


LINE #4

0+00	MH
0+26	Y
0+70	Y
1+20	Y
1+70	Y
2+20	Y
2+70	Y
3+20	Y
3+70	Y
4+20	Y
5+15	Y
5+25	MH

LINE #5	NOTE
0+00	MH
0+49	Y
0+98	Y
1+47	Y
1+96	Y
2+00	MH

LINE #6

0+00	MH
0+49	Y
0+98	Y
1+47	Y
1+96	Y
2+45	Y
2+94	Y
3+43	Y
3+92	Y
4+30	MH

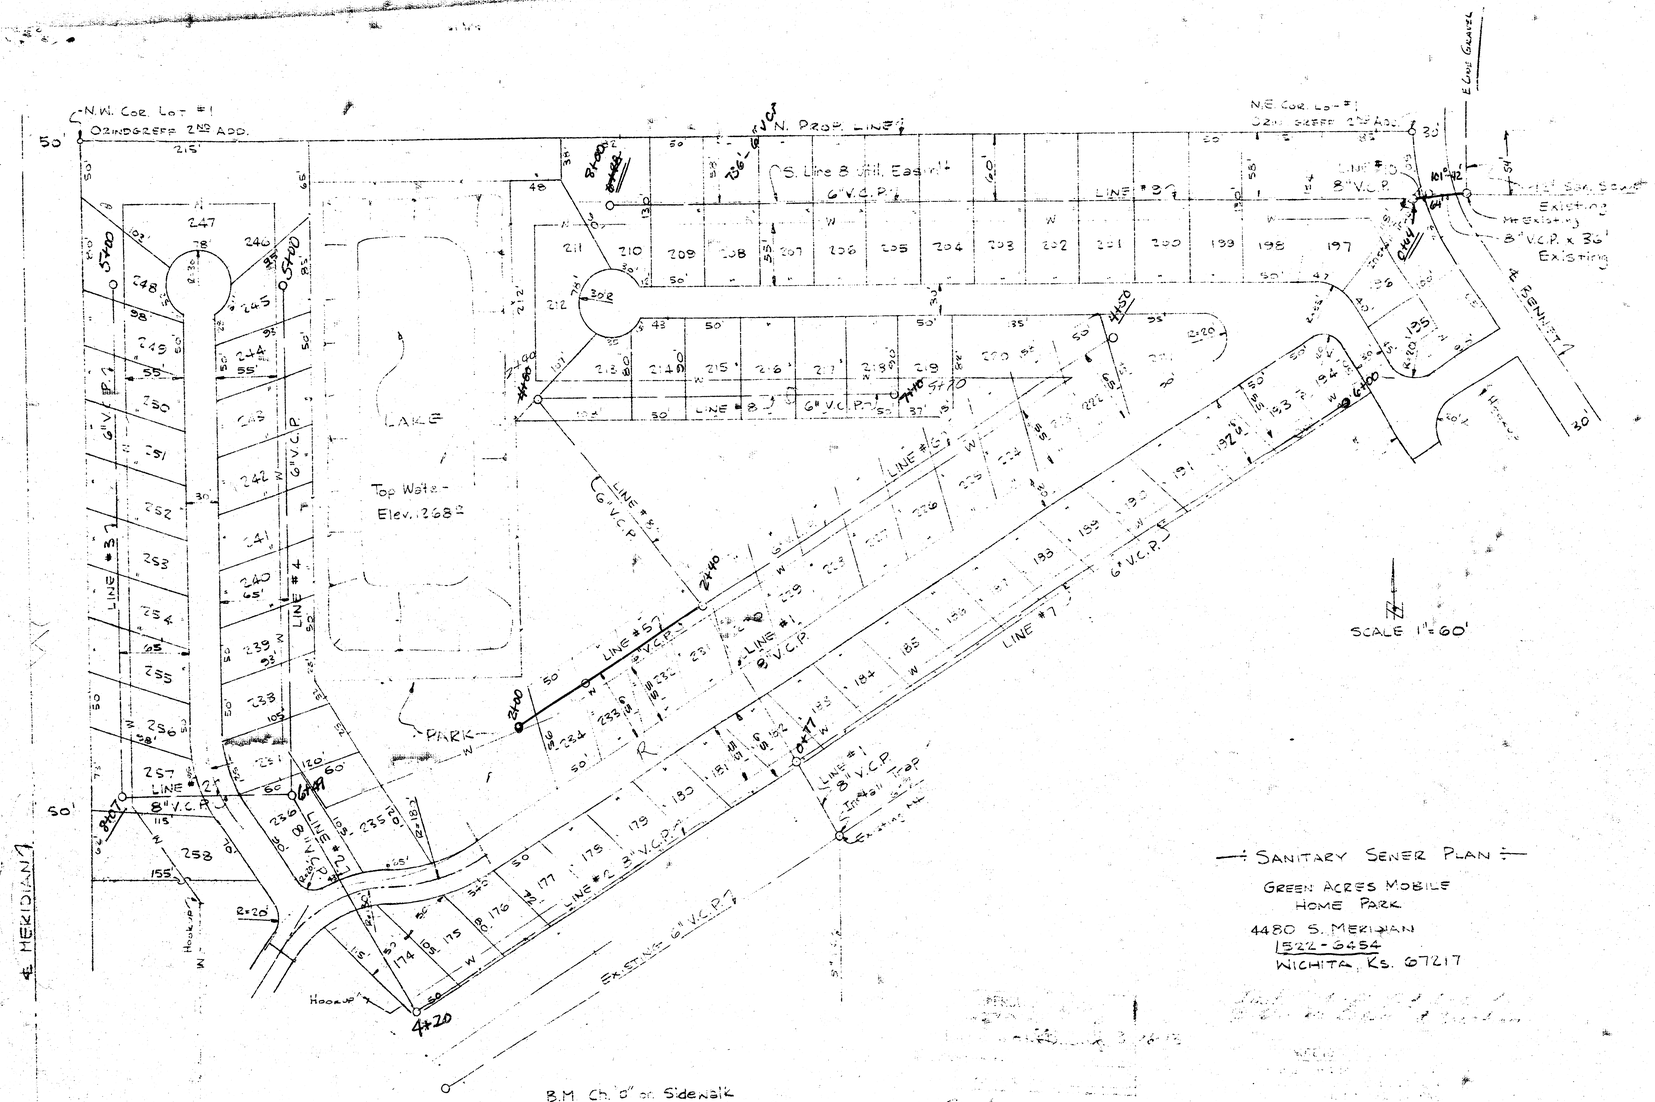

B.M. Ch. 5" on Sidewalk
50' East of N.E. Corner of Swimming Pool
MSL. Elev. 1280.84
C. of N. Elev. 98.44

SANITARY SEWER PLAN

GREEN ACRES MOBILE HOME PARK
4480 S. MERIDIAN
522-6454
WICHITA, KS. 67217

AS BUILT PLANS
GREEN ACRES MOBIL HOMES
H.C. Ladd

FILMED FROM THE BEST