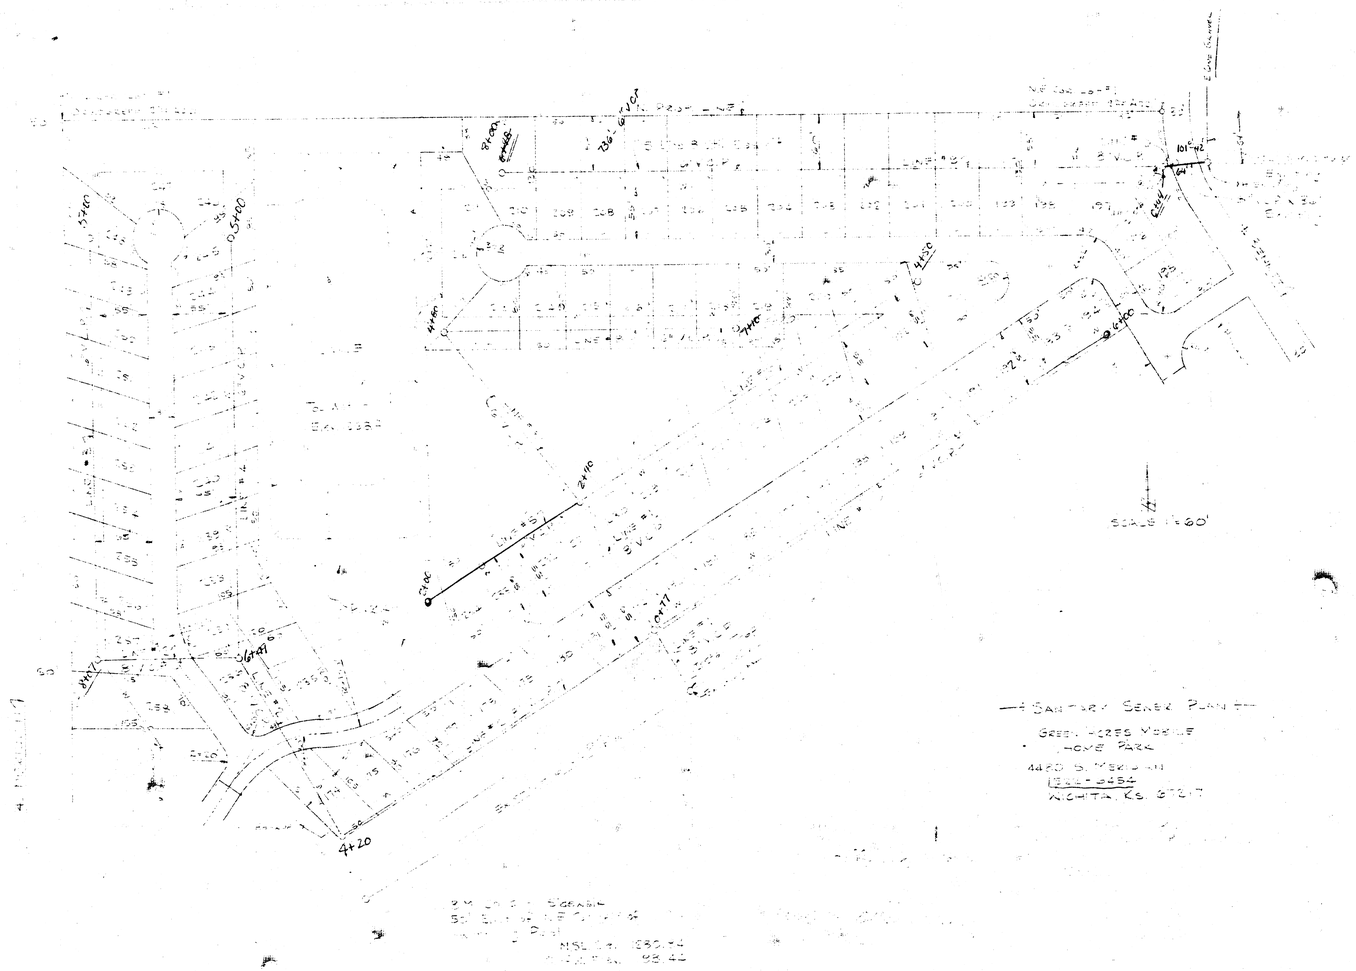

As Built Plans
Green Acres Mobile Homes
H.C. Lobb

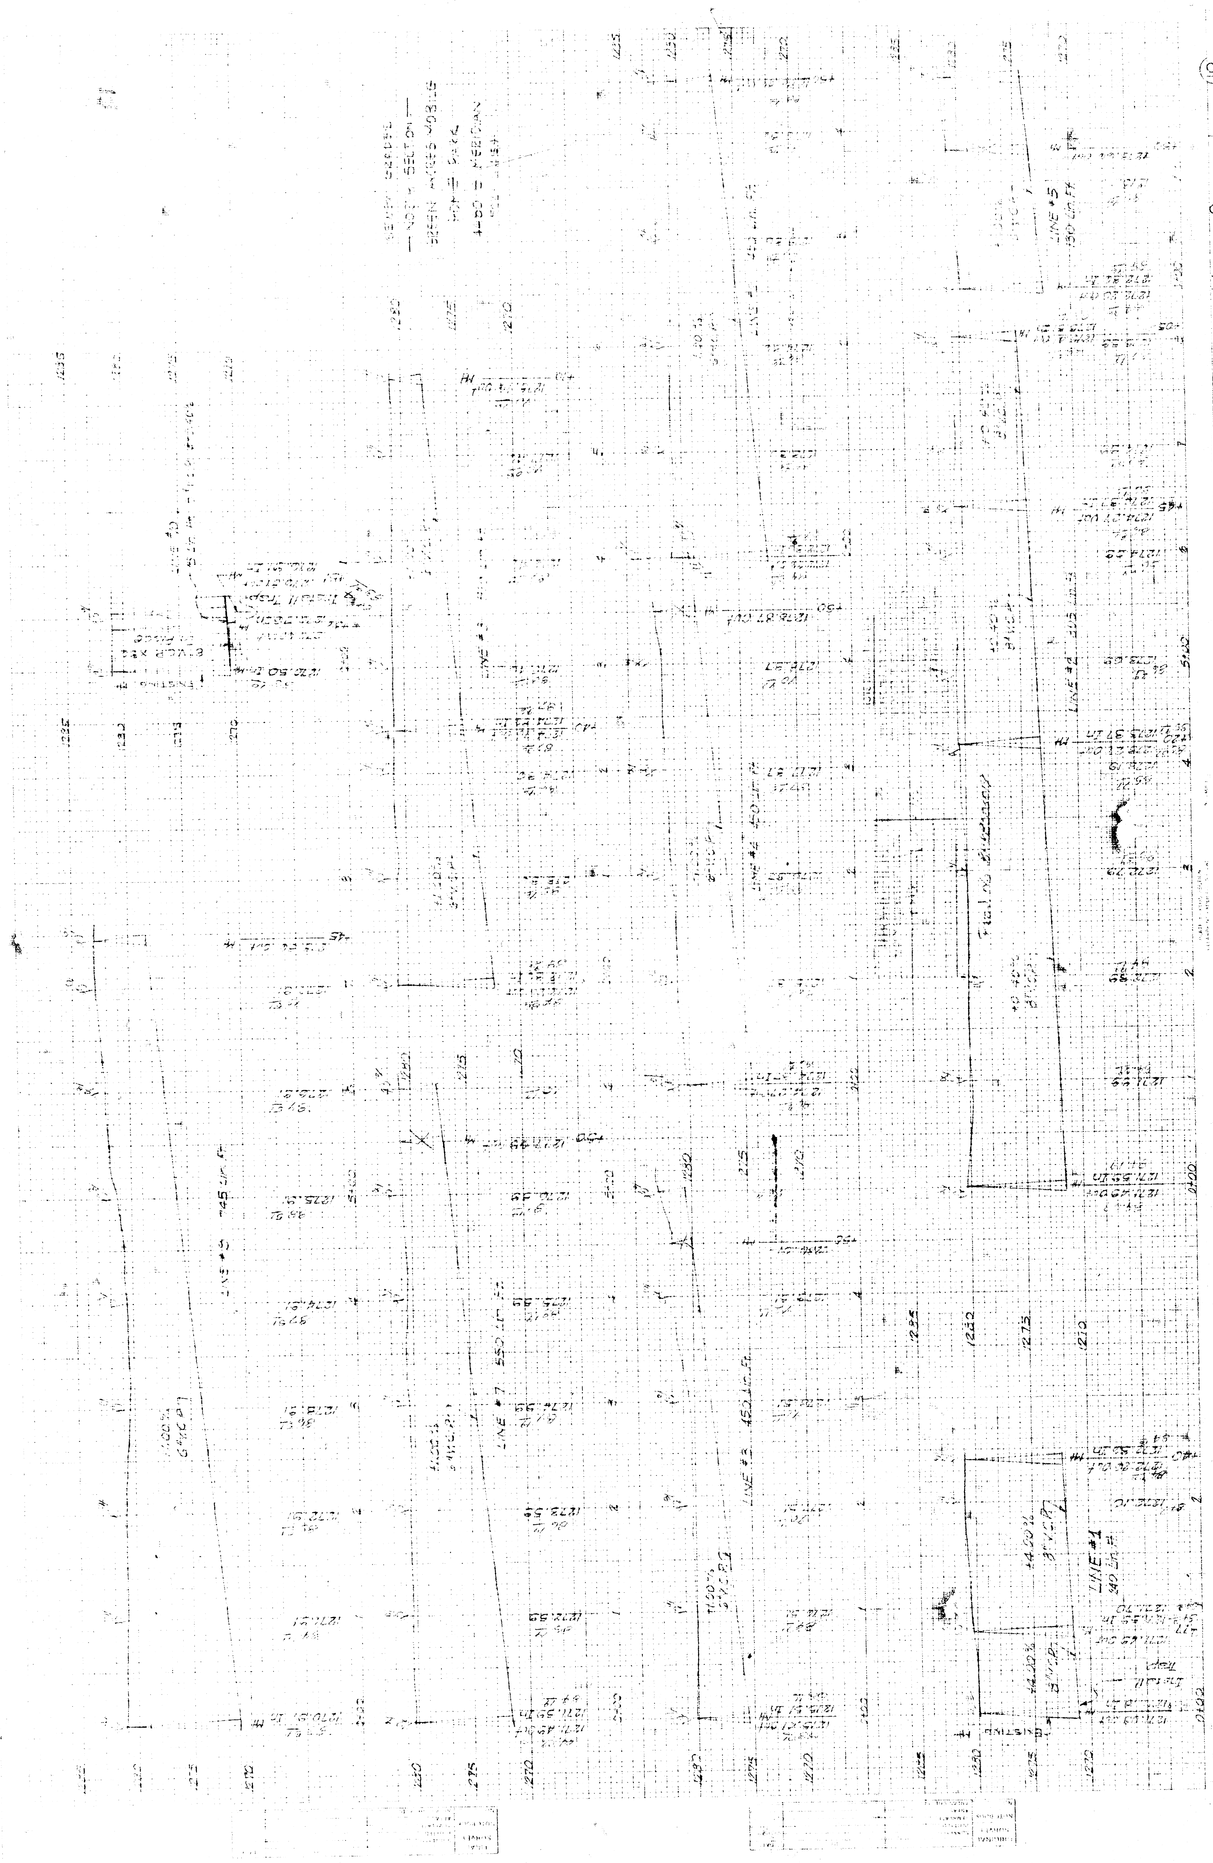
LINE #1
LINE #2
LINE #3
LINE #4
LINE #5
LINE #6
LINE #7
EXISTING
Trail