
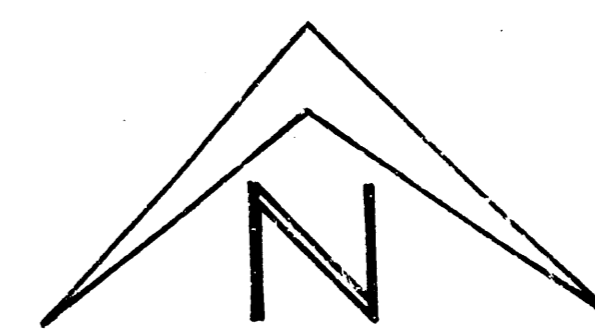


SANITARY SEWER LAYOUT
 GREEN ACRES MOBILE HOME RESORT
 CITY OF WICHITA, KANSAS
 B. E. SMITH CITY ENGINEER
 PRIVATE PROJECT

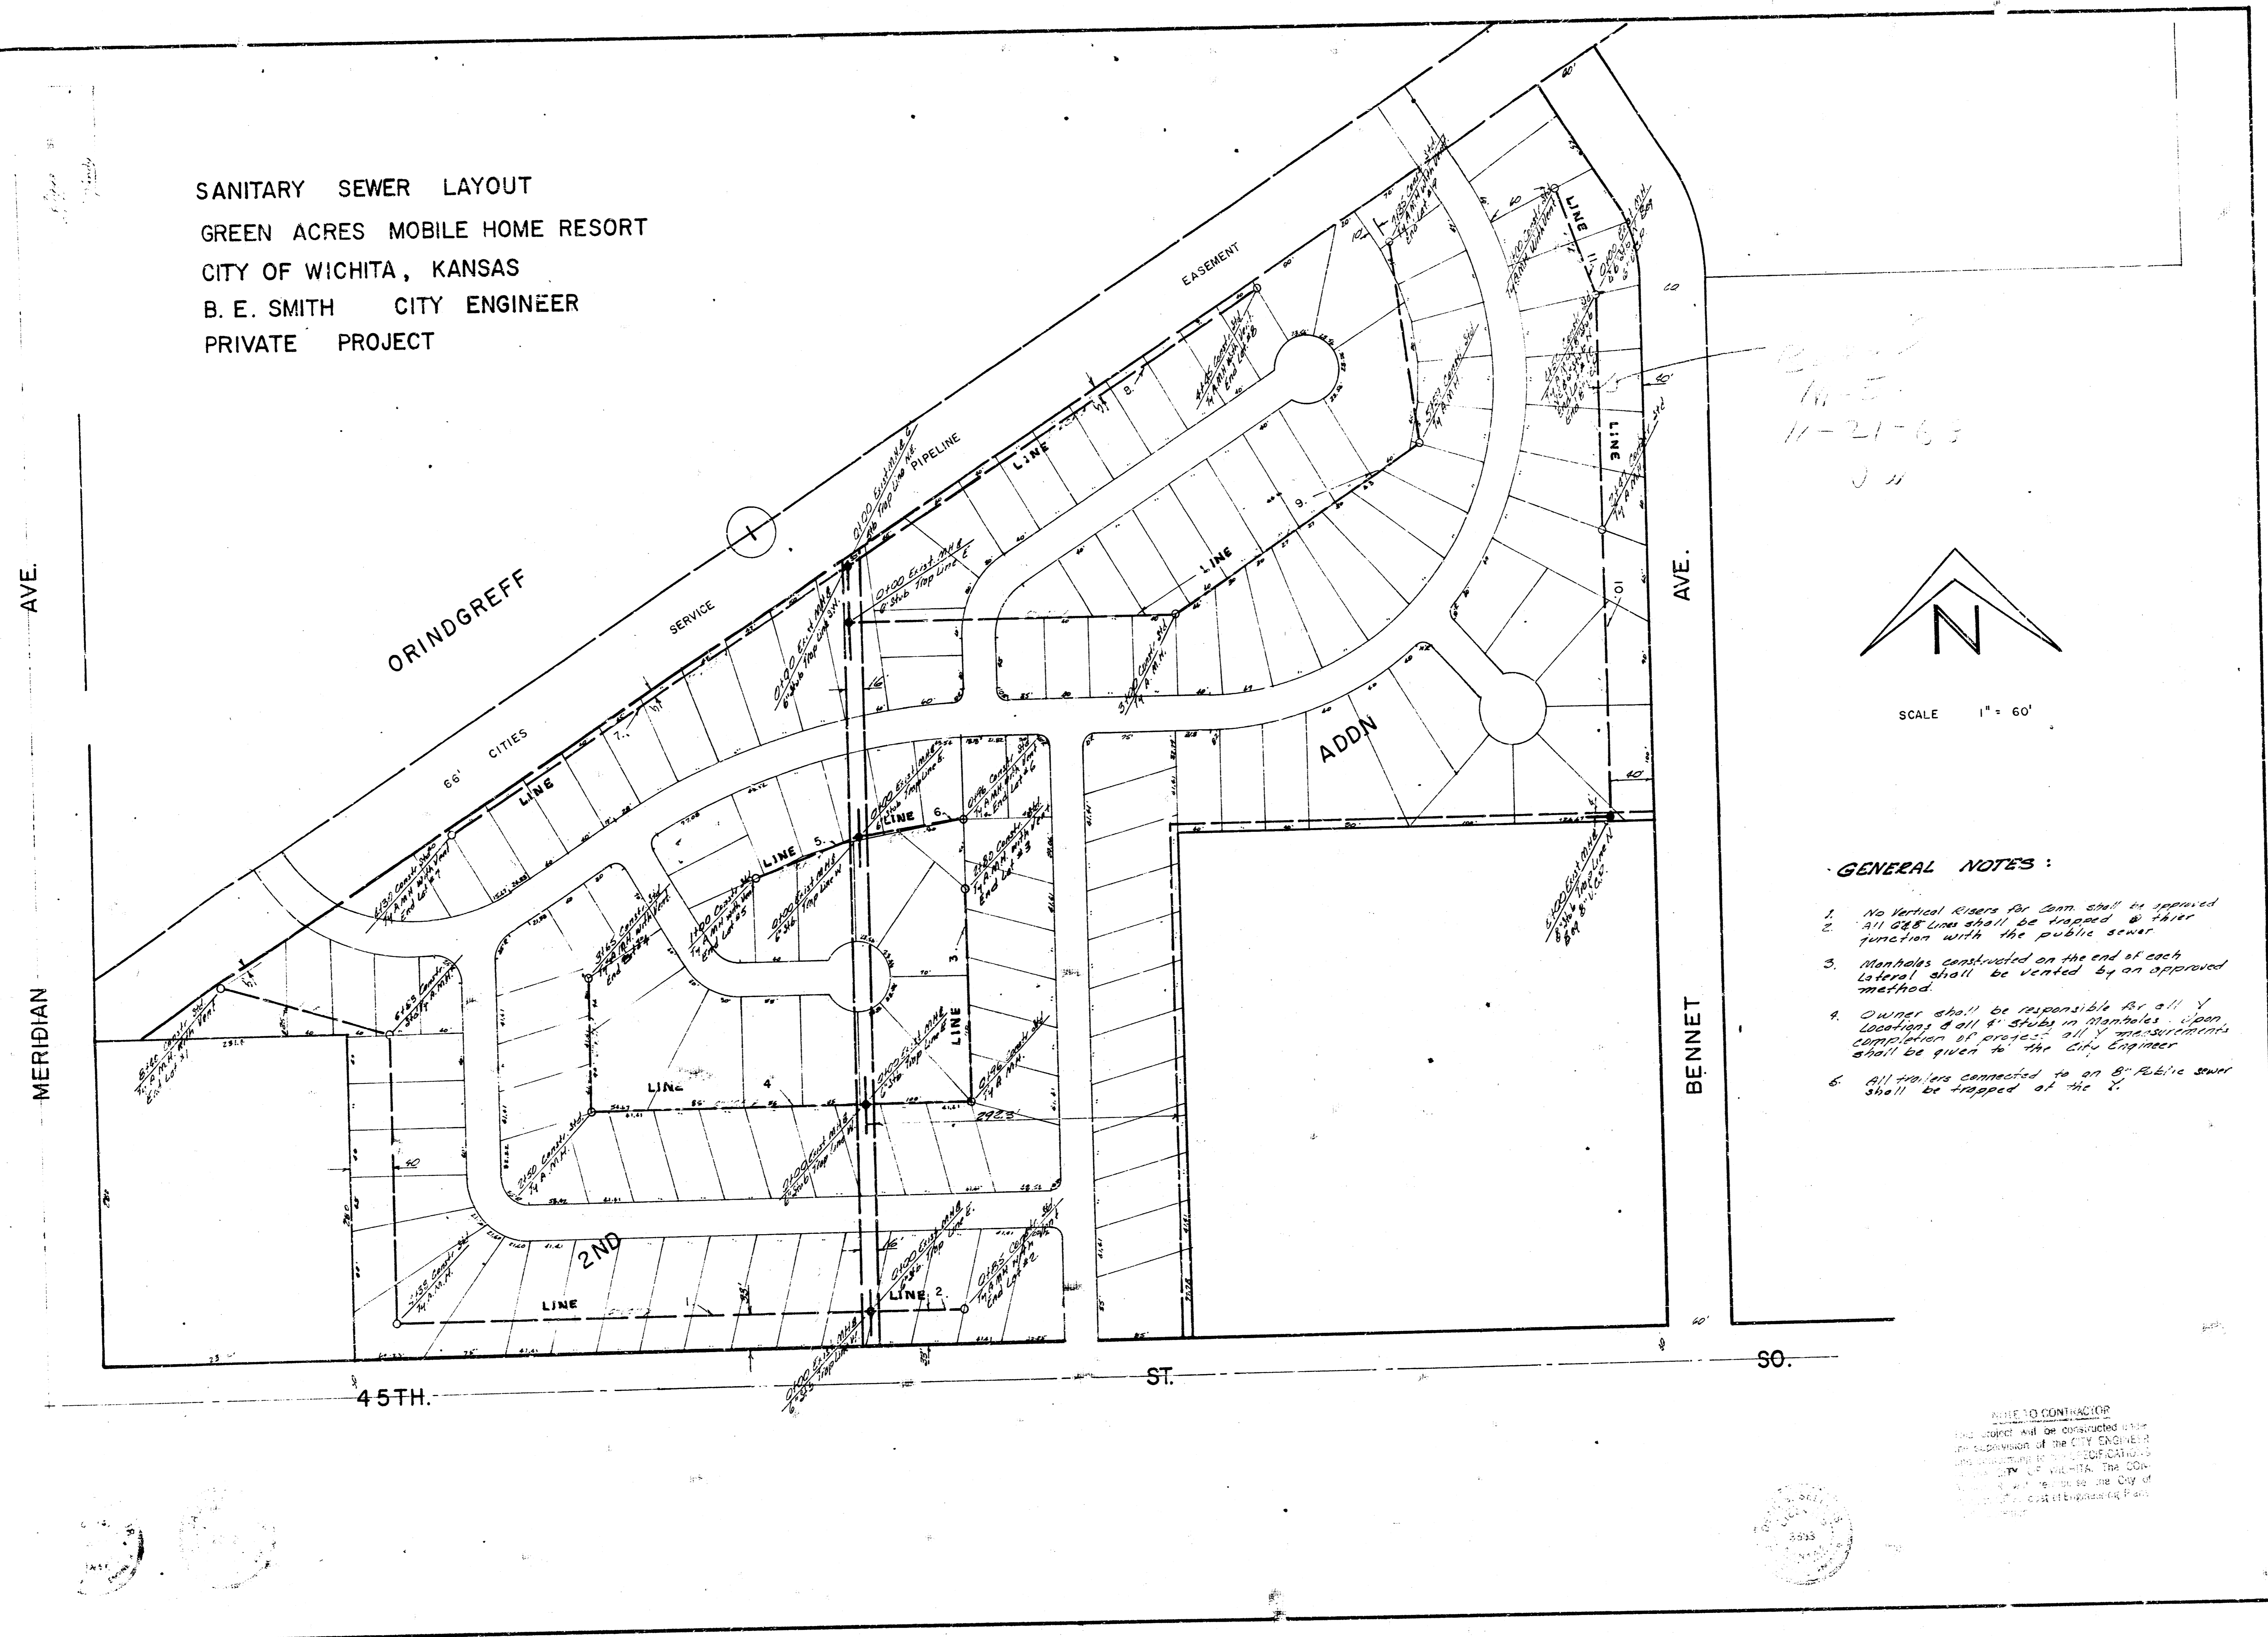

SCALE 1" = 60'

GENERAL NOTES:

3. Manholes constructed on the end of each lateral shall be vented by an approved method
4. Owner shall be responsible for all Y loadings & all Y studs in manholes. Upon completion of project all Y measurements shall be given to the City Engineer
5. All manholes connected to an 8" Public sewer shall be trapped at the Y.

WHILE IN CONTRACTOR
 AND SHALL BE CONSTRUCTED UNDER
 THE SUPERVISION OF THE CITY ENGINEER



