


APPROVED AS NOTED
By CITY ENGINEER OF WICHITA
Sanitary Sewers *QDE 11/28/84*
Storm Sewers
Driveway Approaches


NOTE TO CONTRACTOR
This project will be constructed under the supervision of the CITY ENGINEER and conforming to the SPECIFICATIONS of the CITY OF WICHITA. The CONTRACTOR will prepay the City of Wichita for all costs of Inspection.

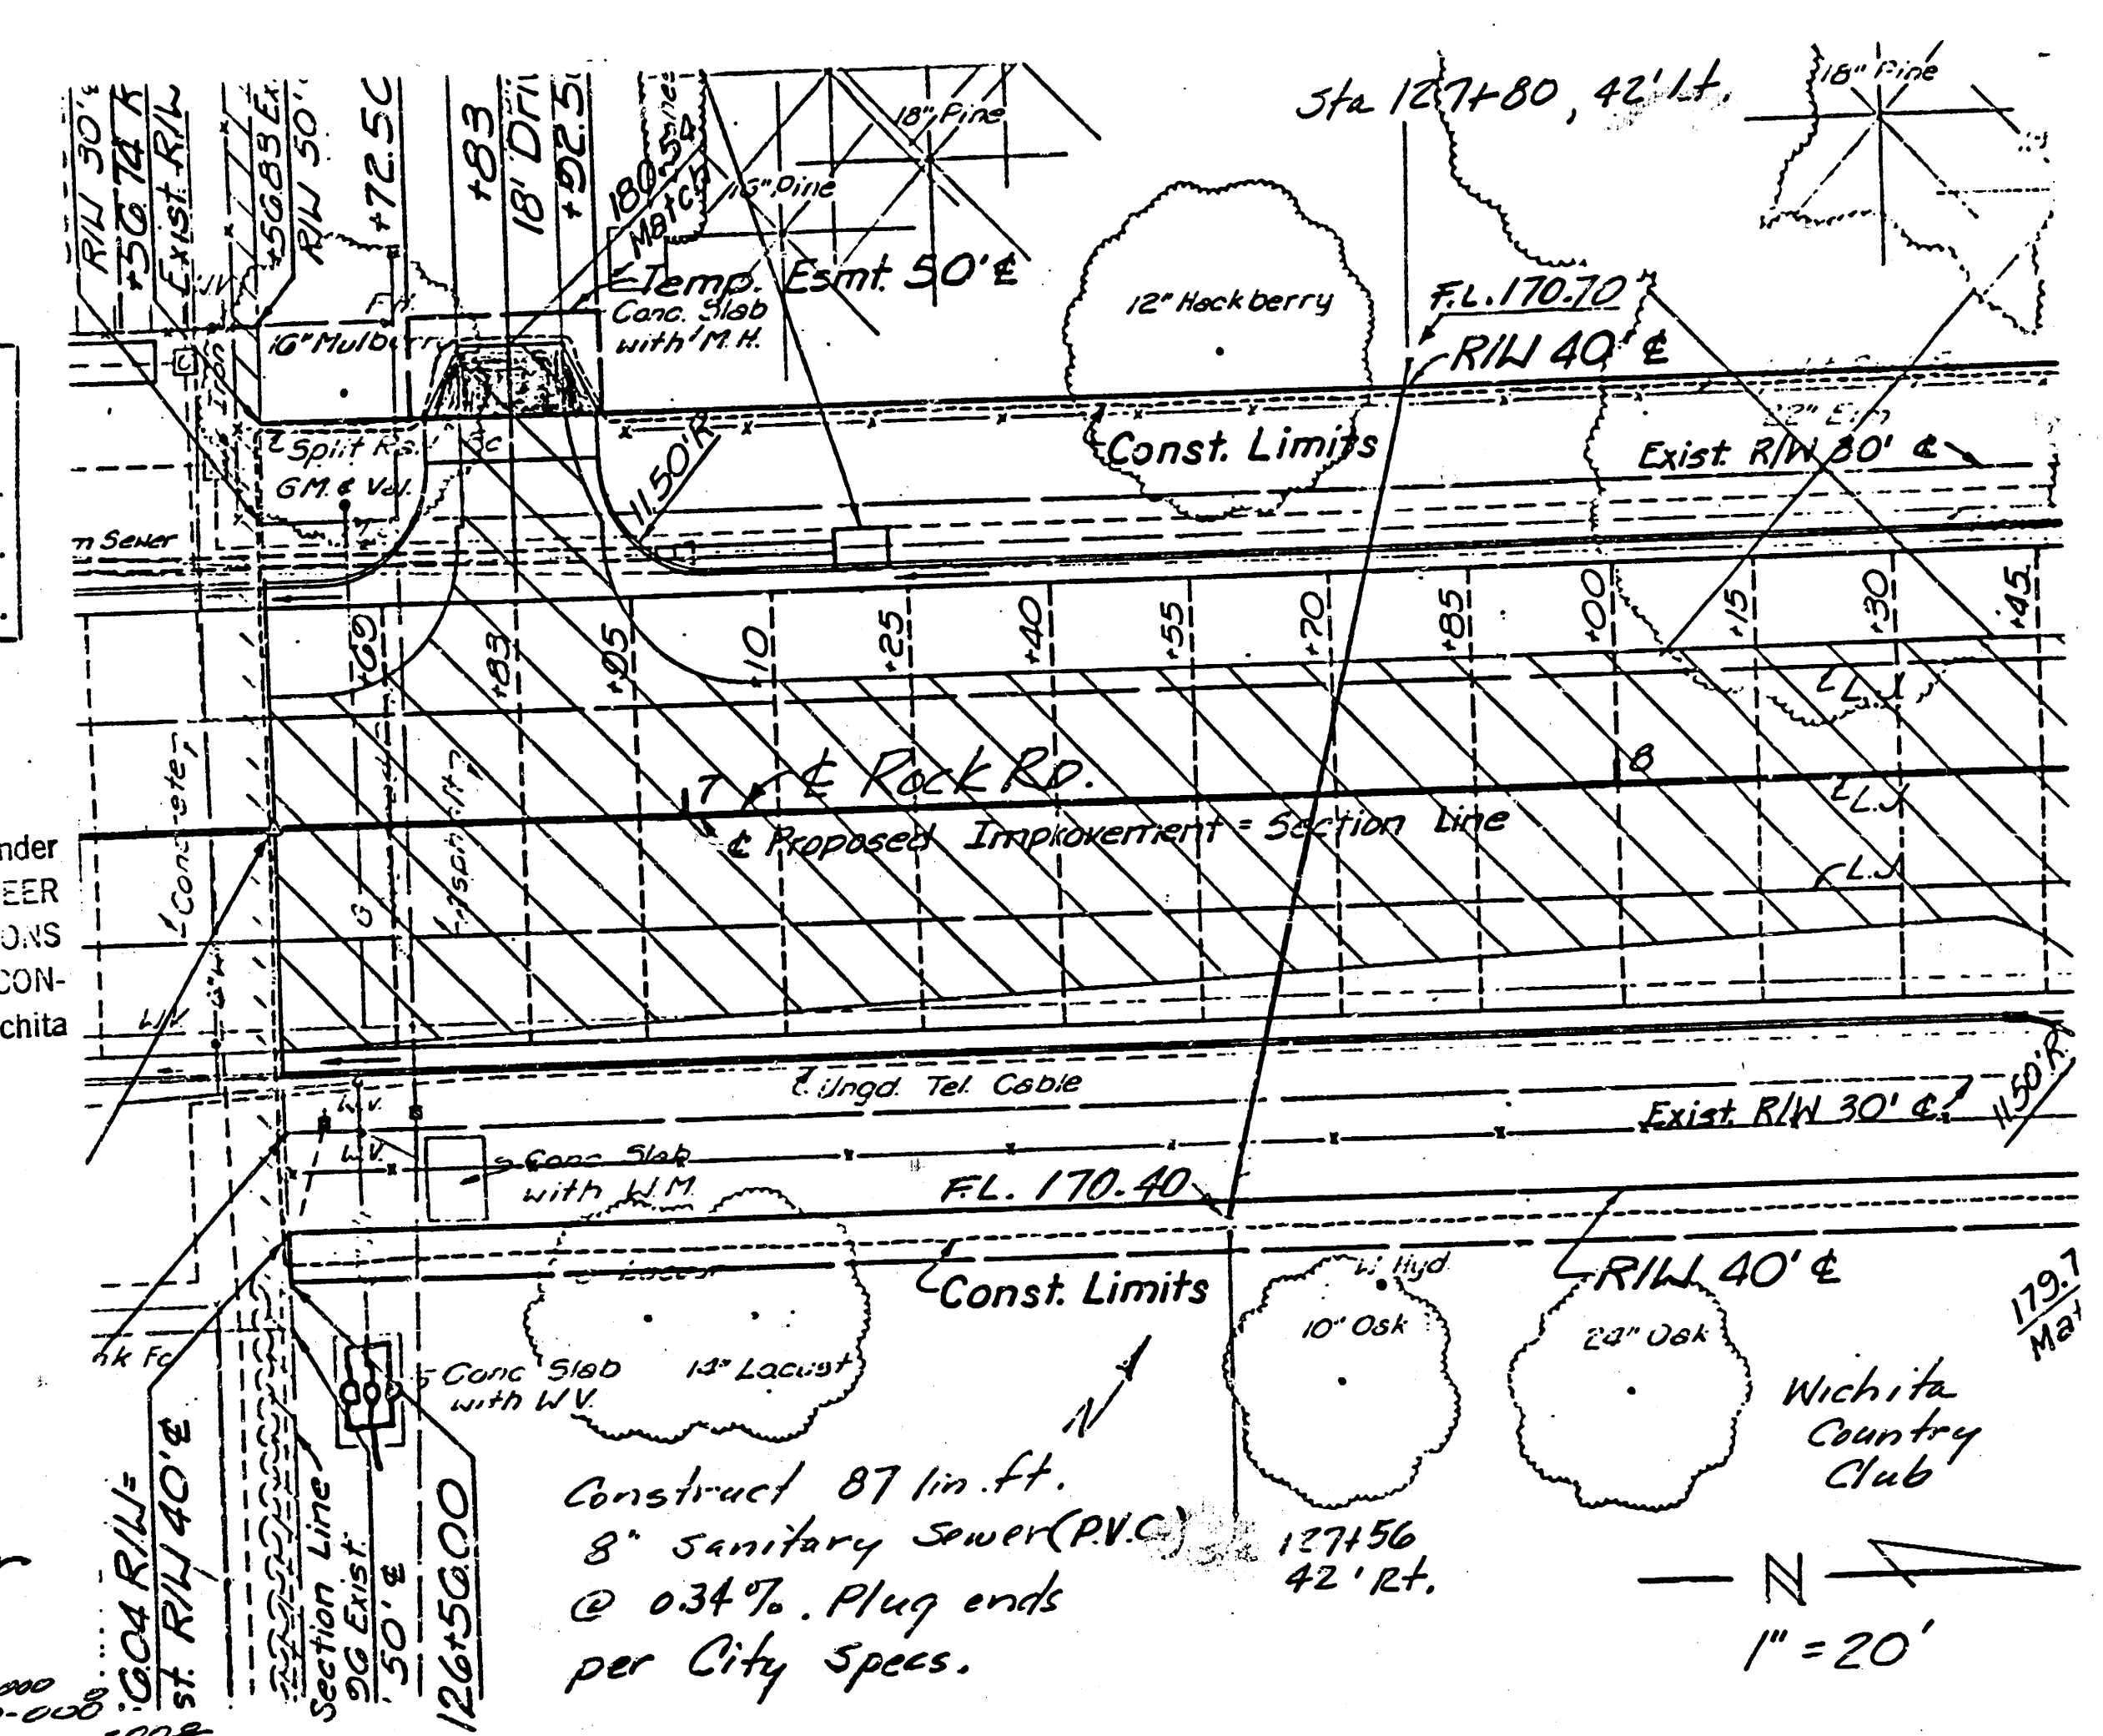

Sanitary Sewer
Hartmoor
468-76-245-80000-000-000-008




Connect to existing W.H.
Fl. in 177.80

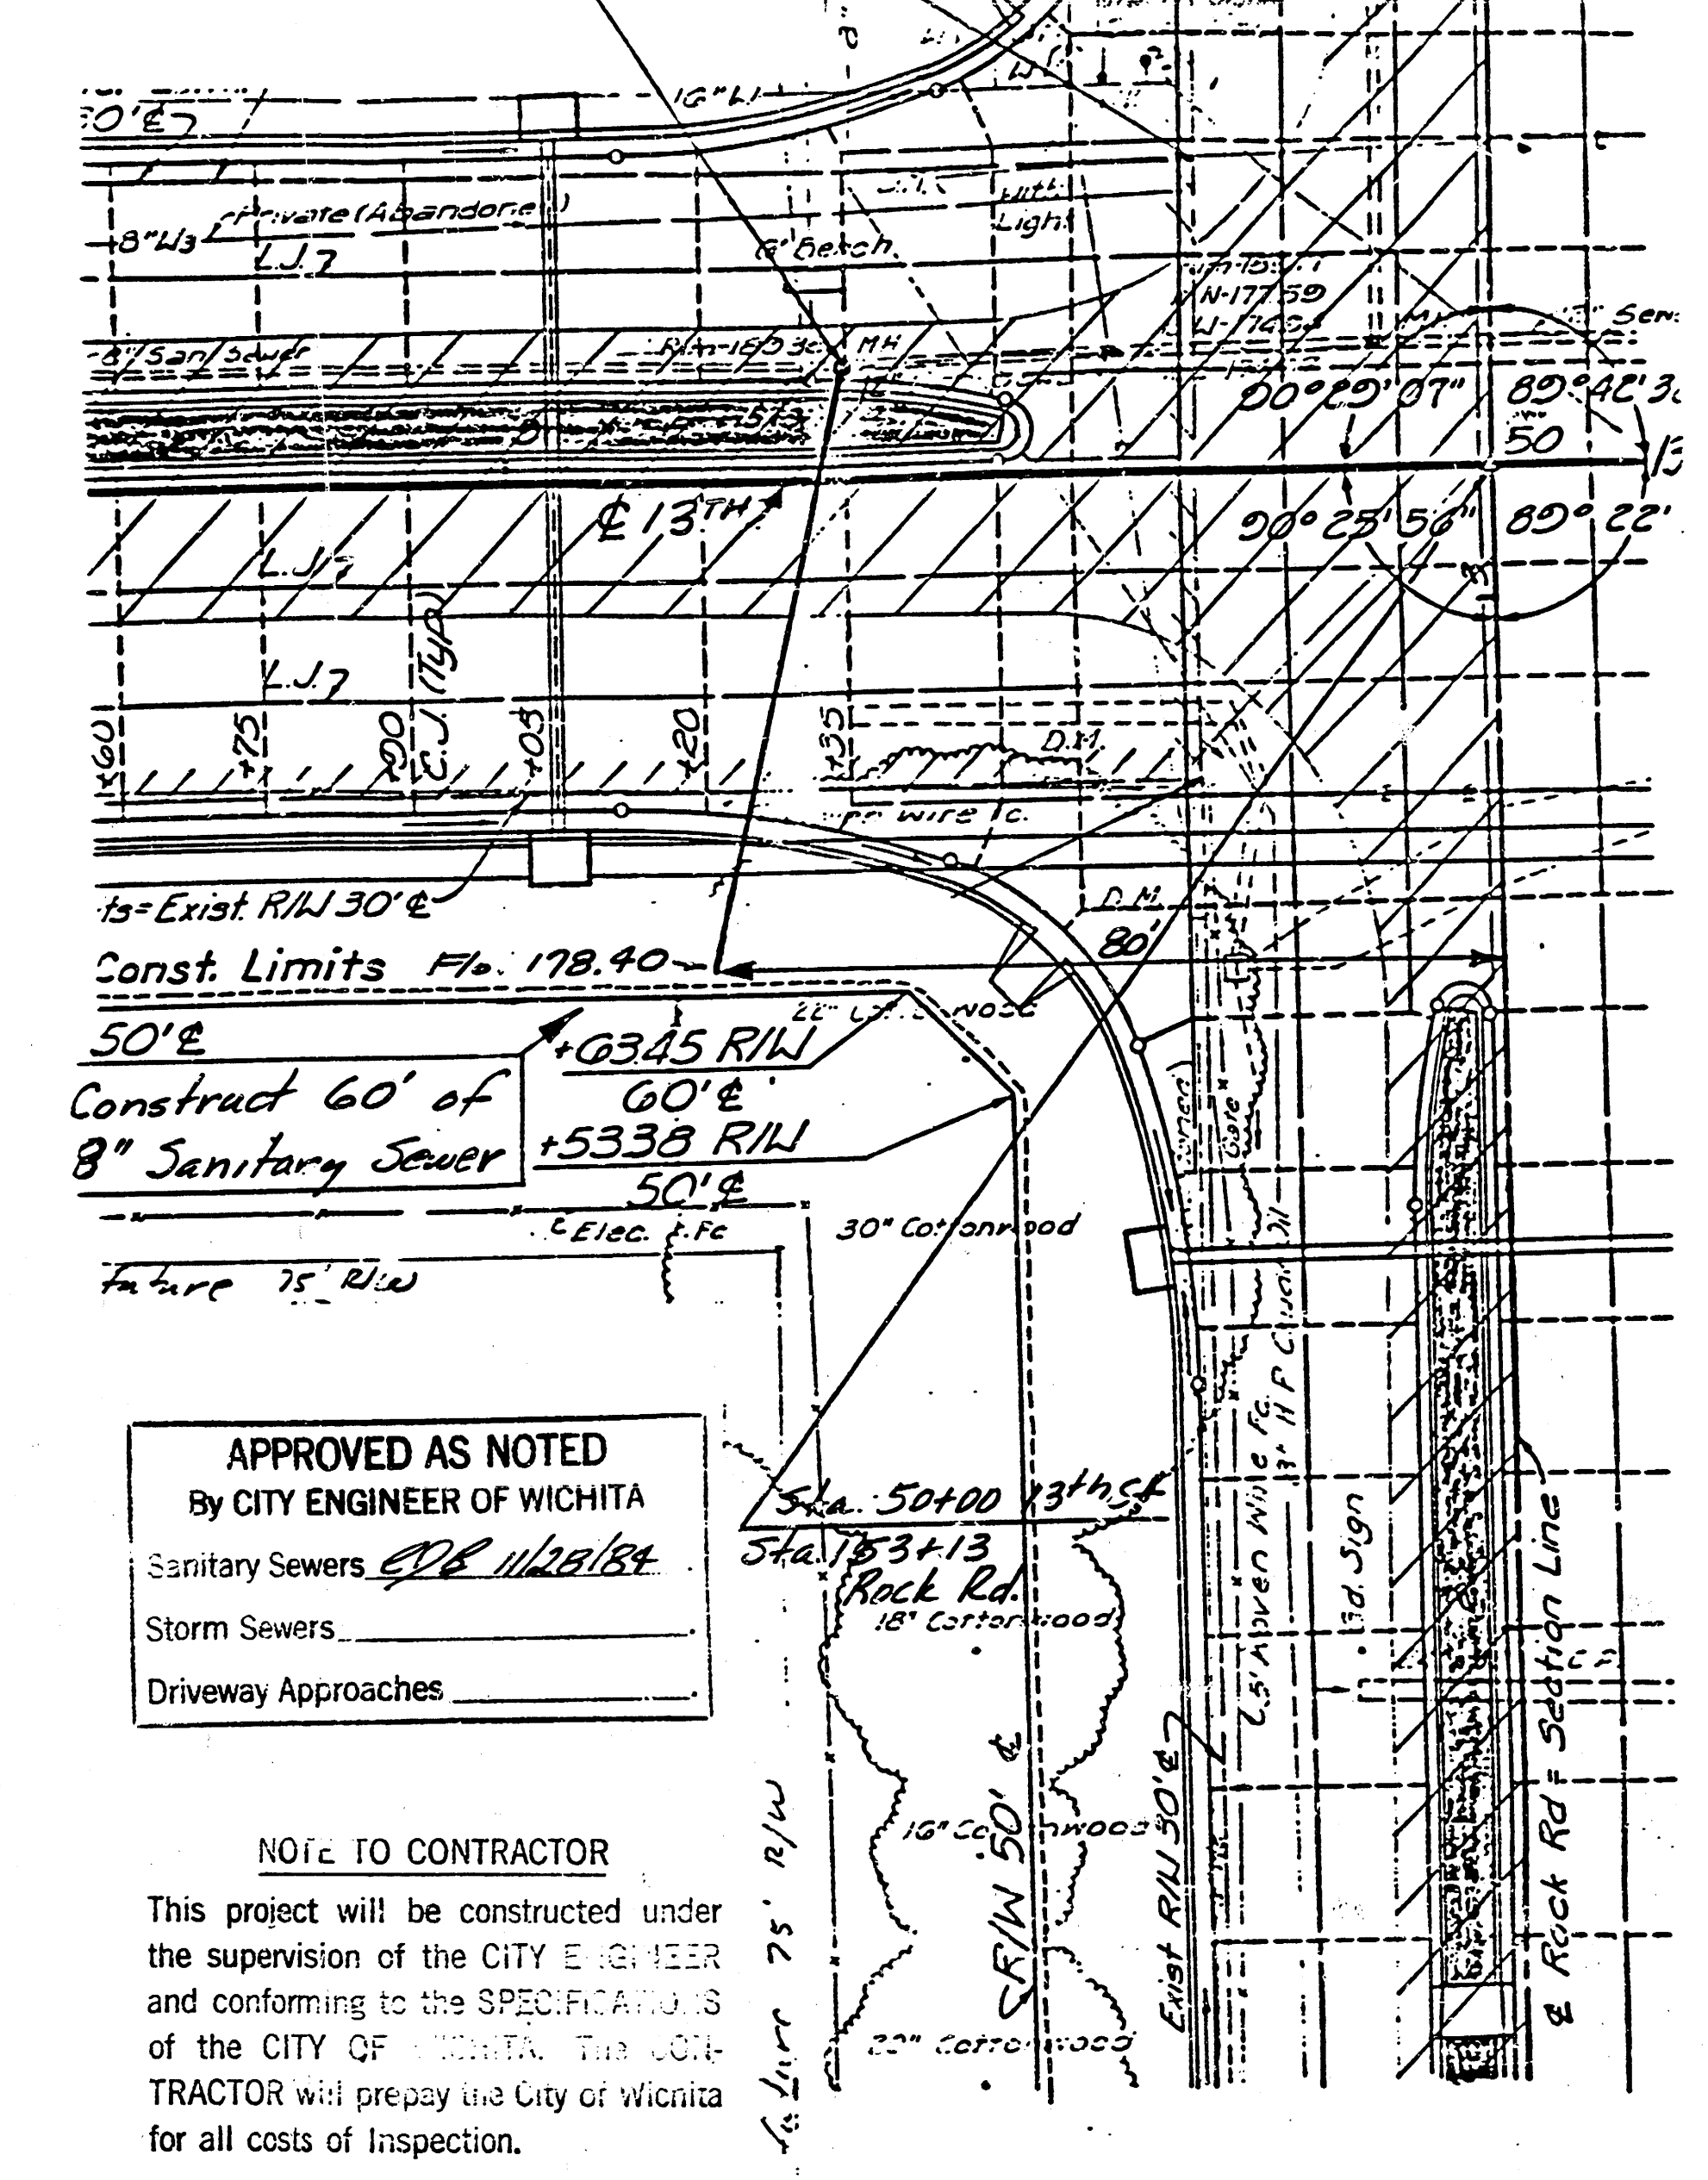

APPROVED AS NOTED
By CITY ENGINEER OF WICHITA
Sanitary Sewers *QDE 11/28/84*
Storm Sewers
Driveway Approaches

NOTE TO CONTRACTOR
This project will be constructed under the supervision of the CITY ENGINEER and conforming to the SPECIFICATIONS of the CITY OF WICHITA. The CONTRACTOR will prepay the City of Wichita for all costs of Inspection.

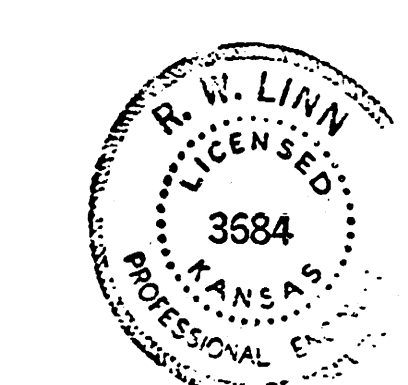

Sanitary Sewer Extension
S.W. Cor. 13th & Rock Rd.
468-76-245-80000-000-000-008

PRIVATE SANITARY SEWER EXTENSION
FOR HARTMOOR FARMS
468-76-245-80000-000-000-008