
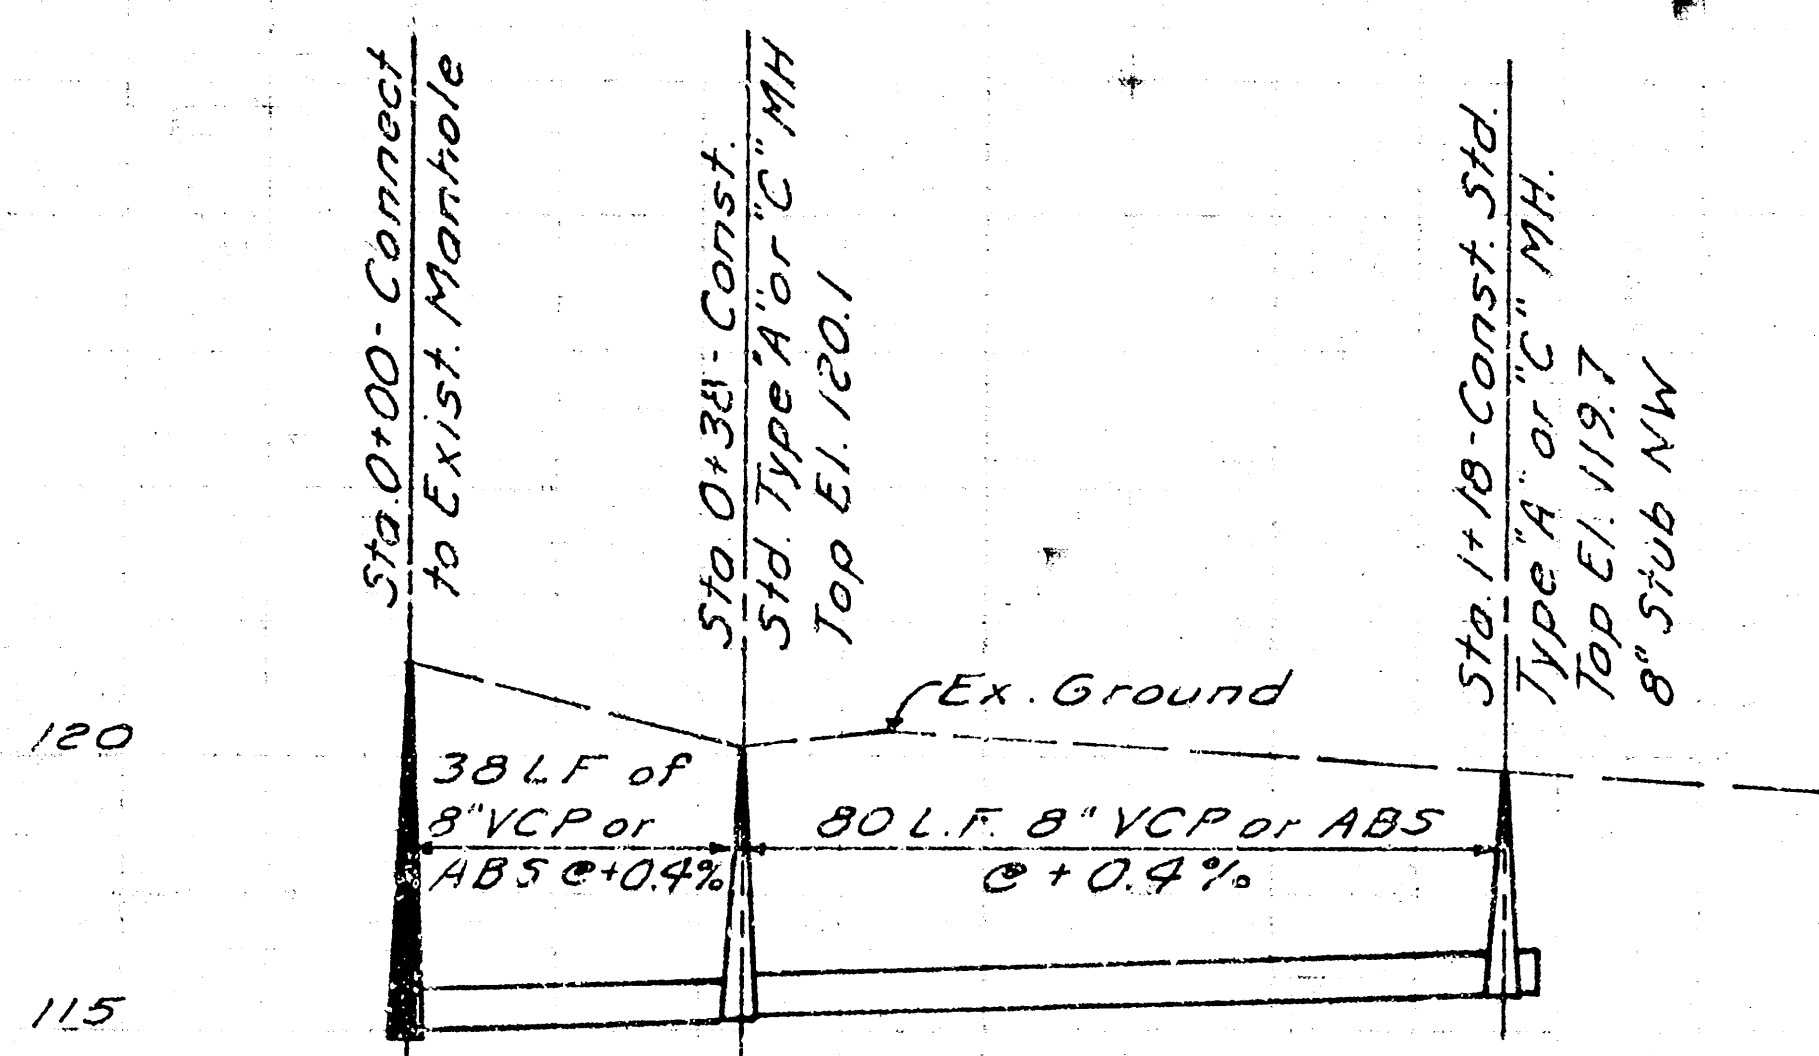


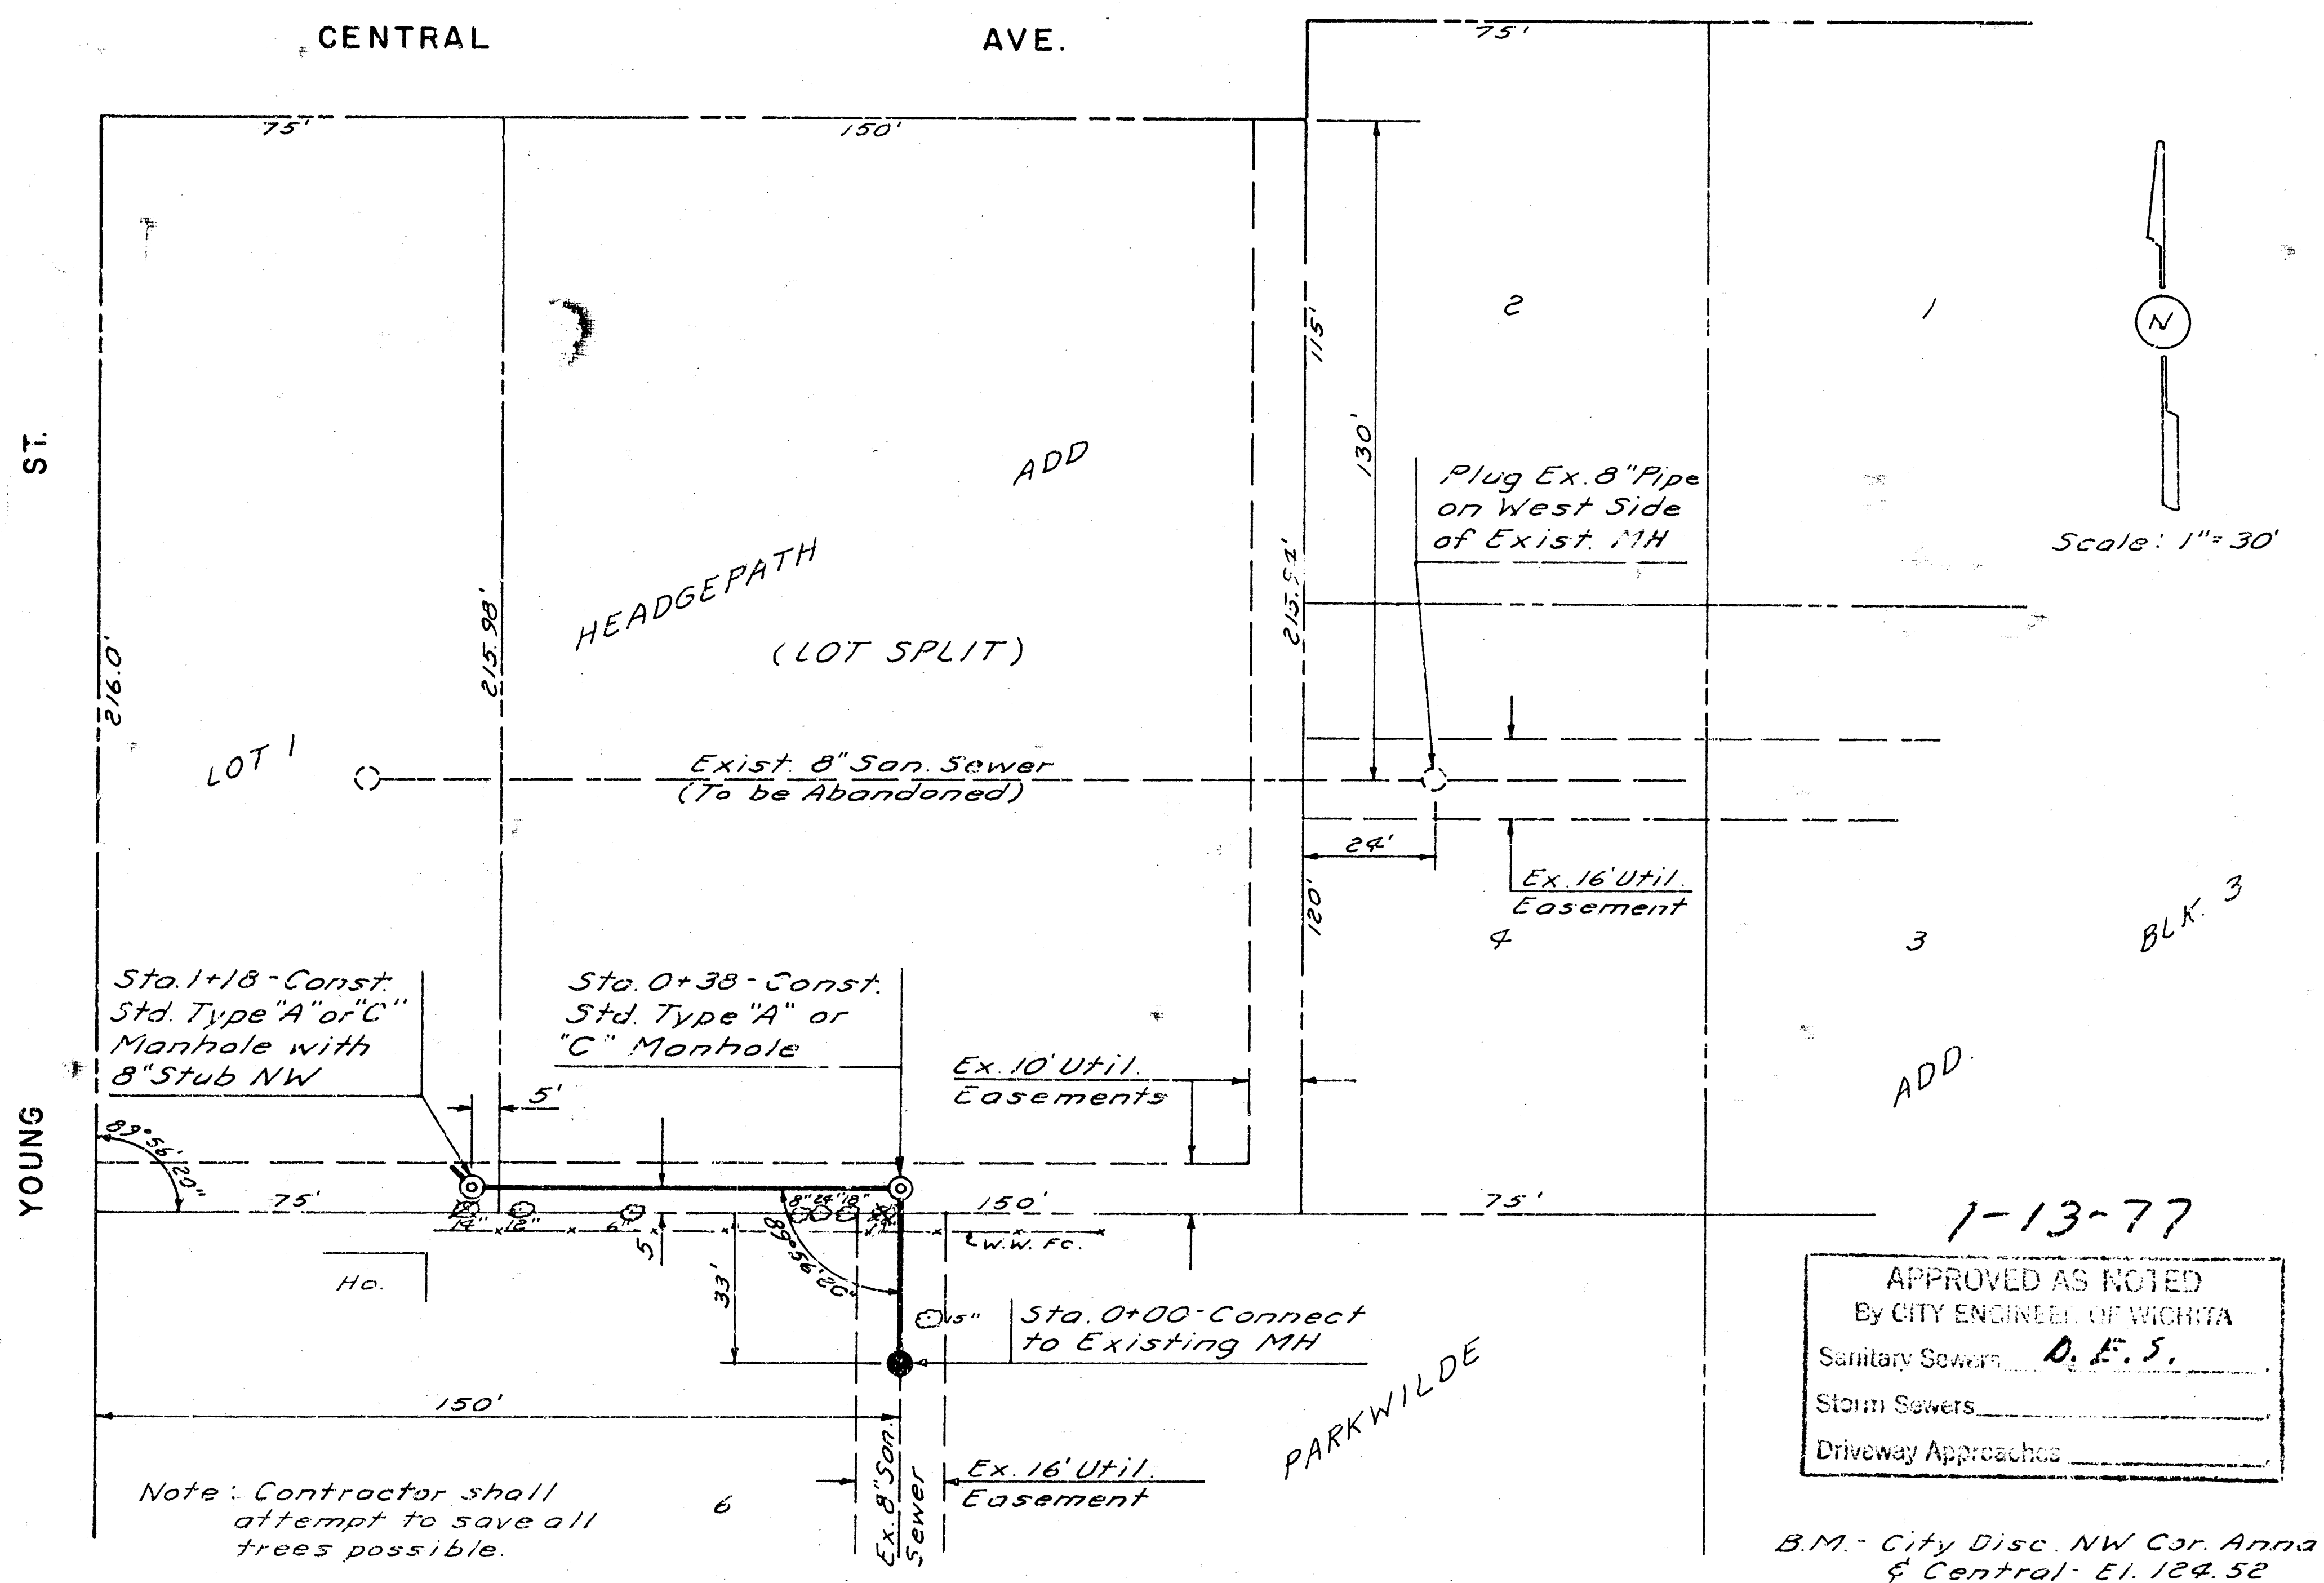

E out 114.91
 E in 115.01
 E out 115.16
 E in 115.26
 E 115.36
 E out 115.58
 E in 115.68
 1+80

CITY PROJ. NO. DBKW 707004
 SANITARY SEWER TO SERVE
 HEADGEPAATH ADDITION