
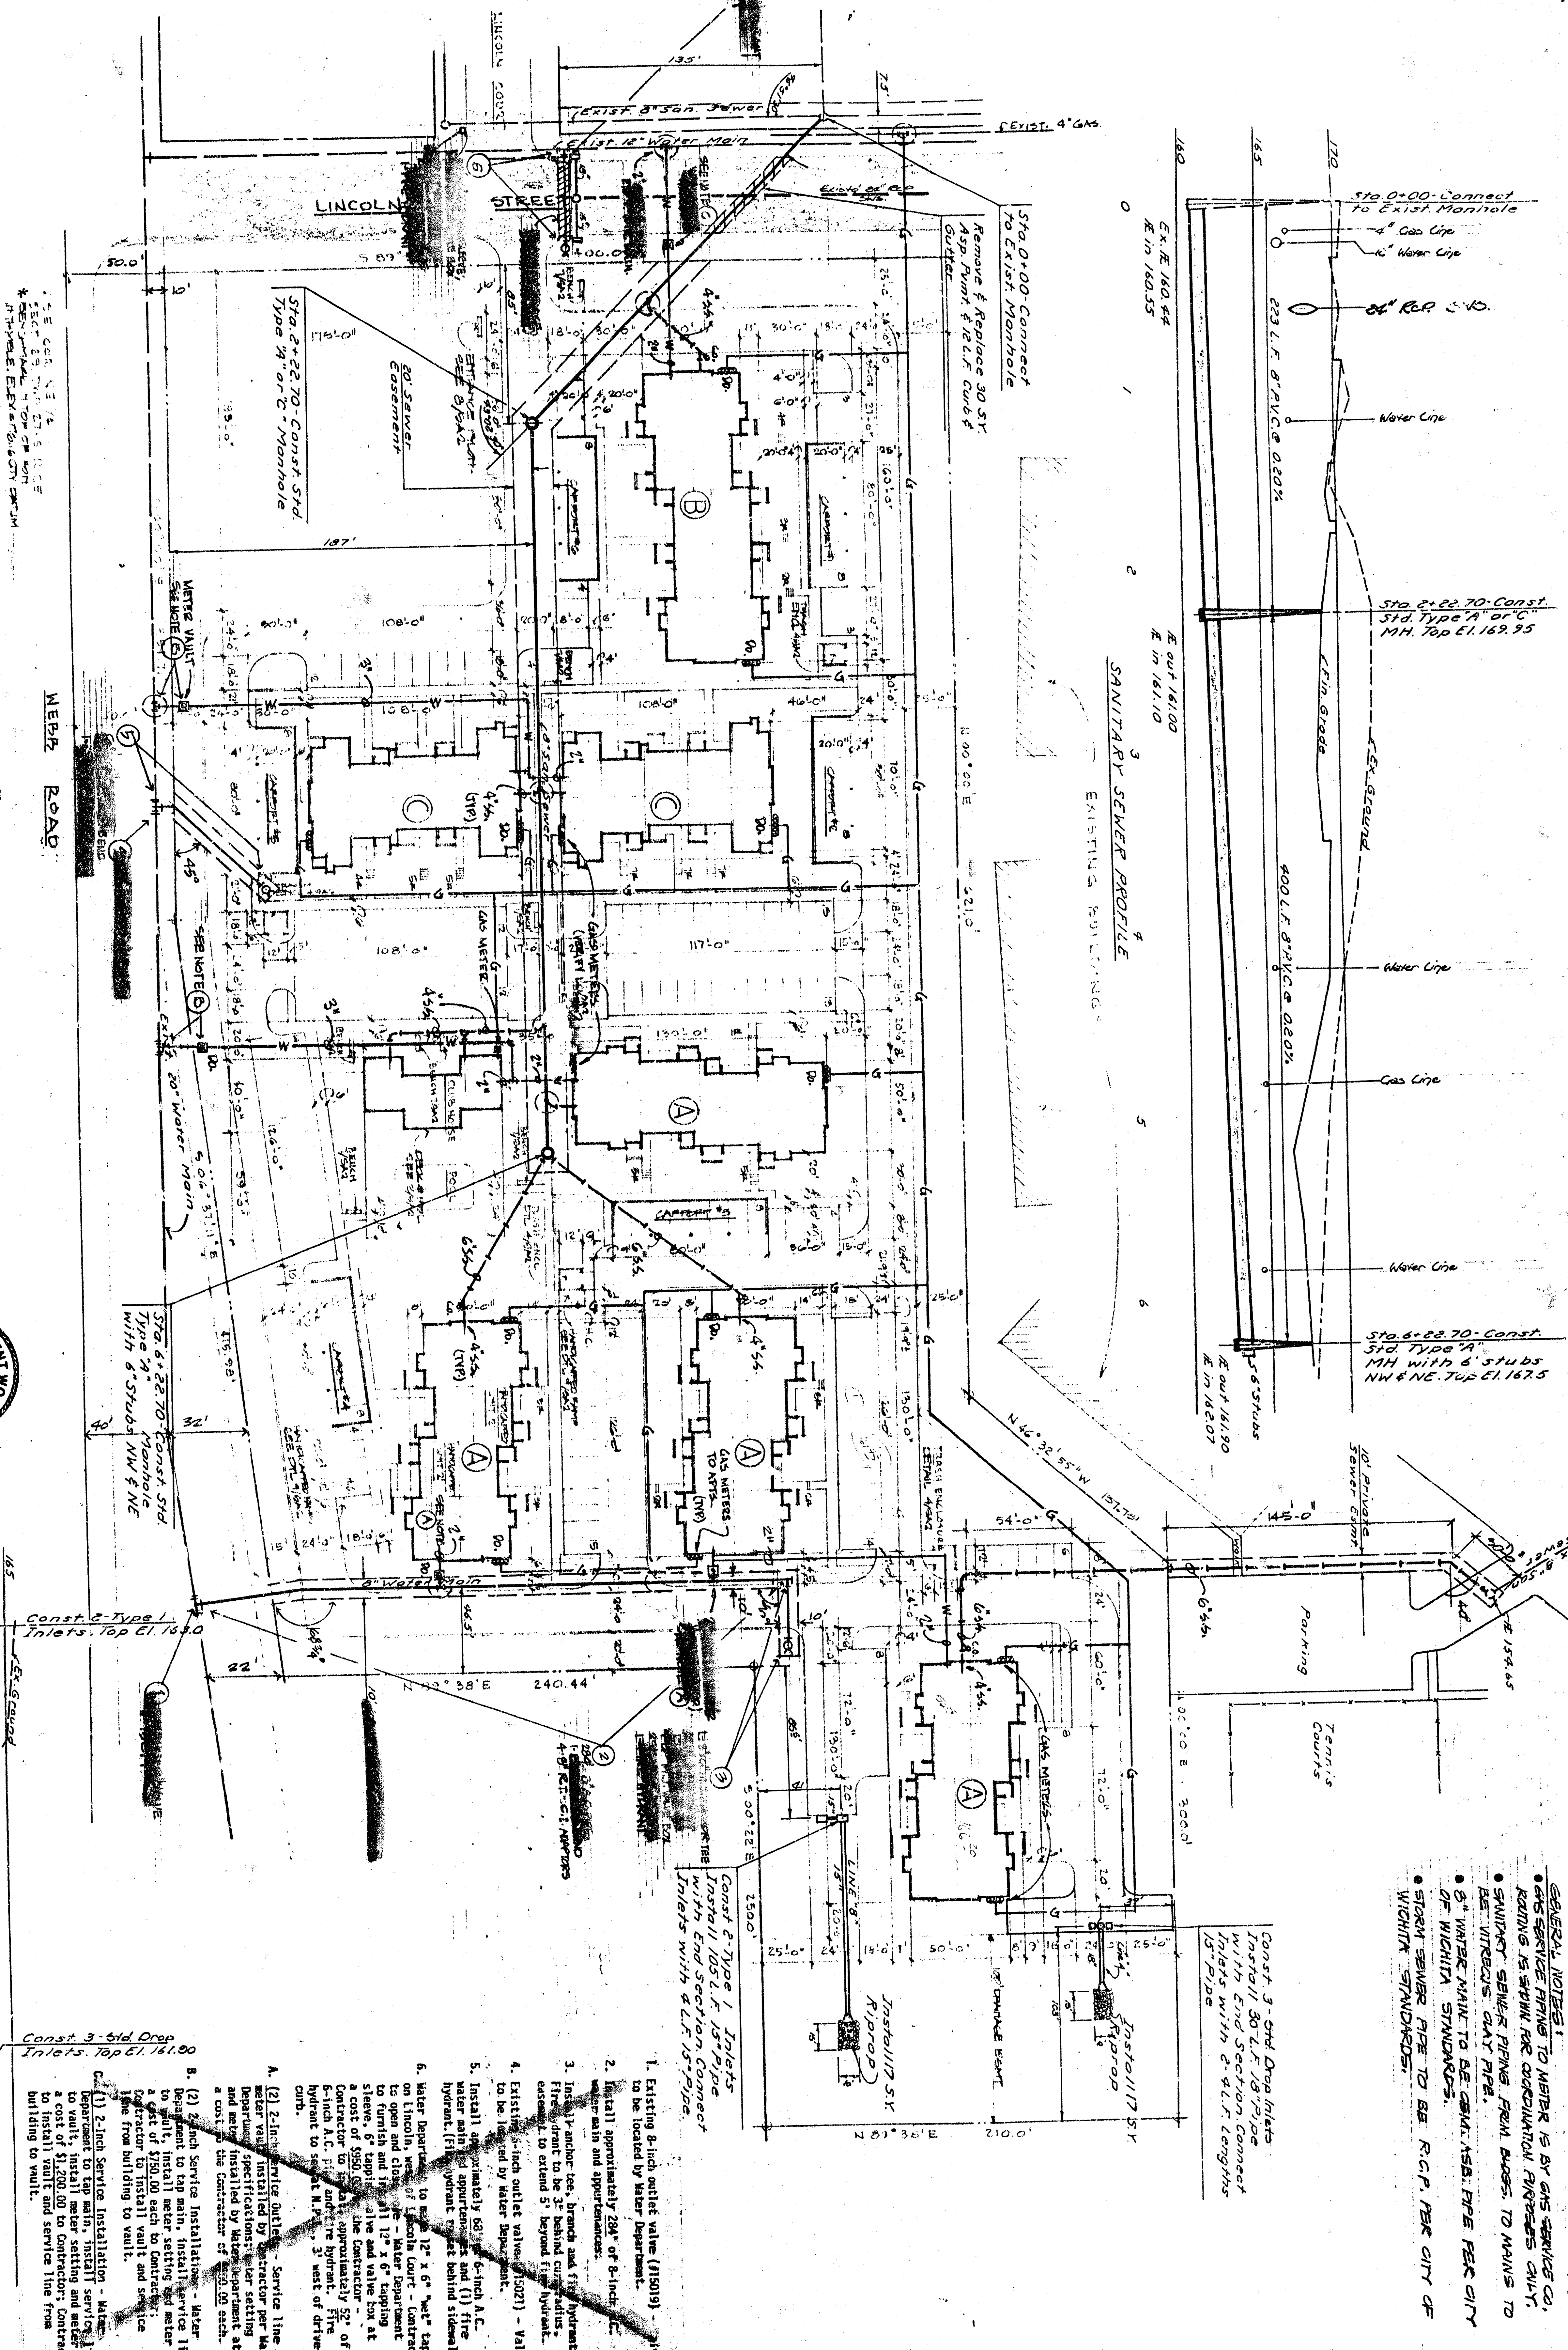
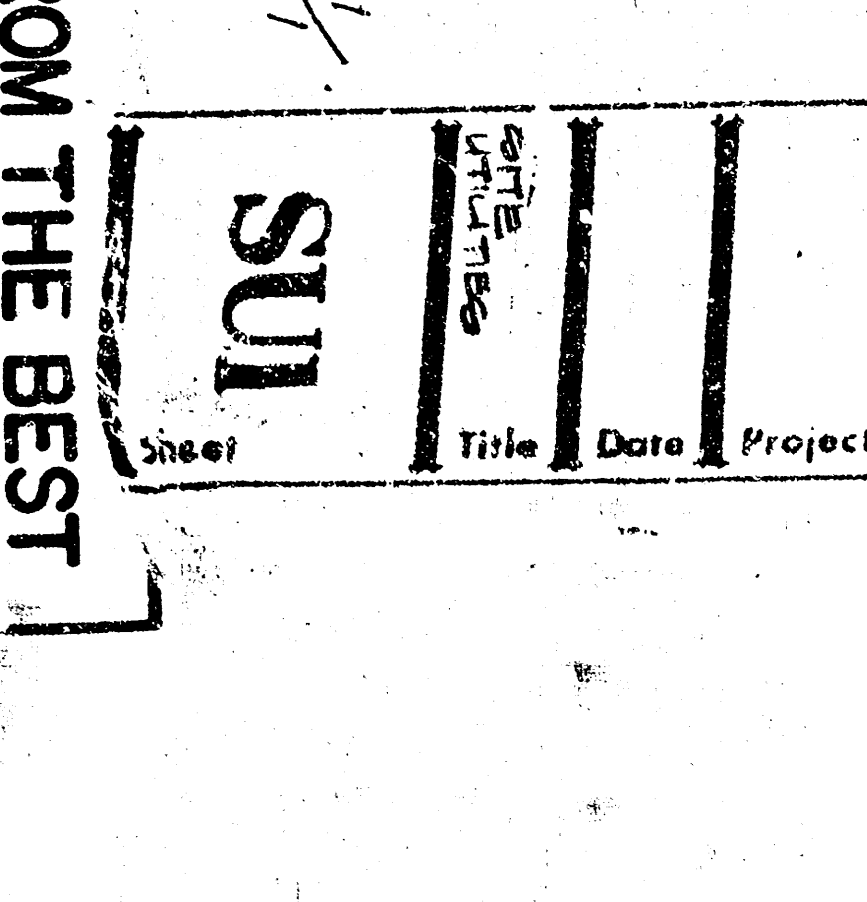
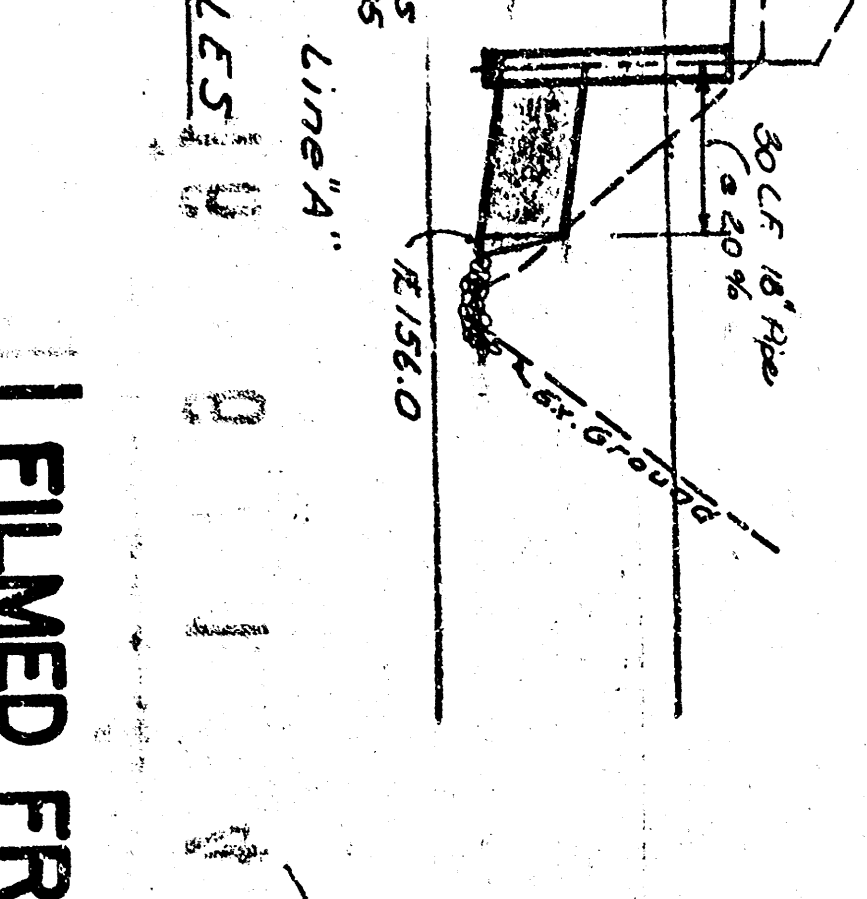
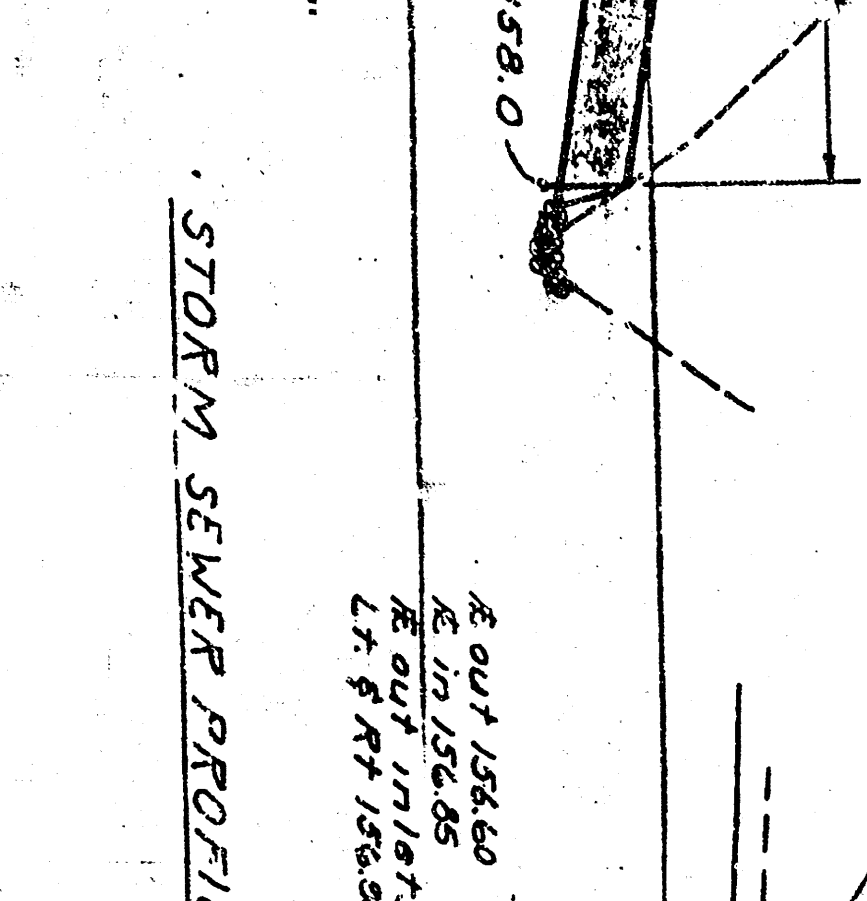
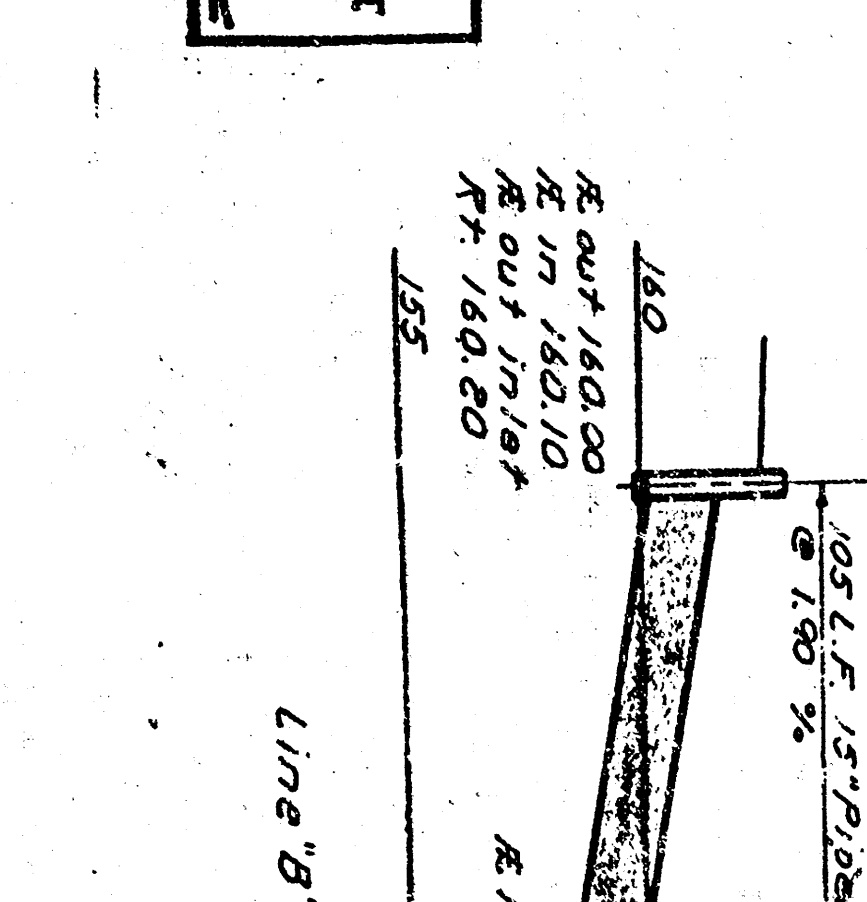
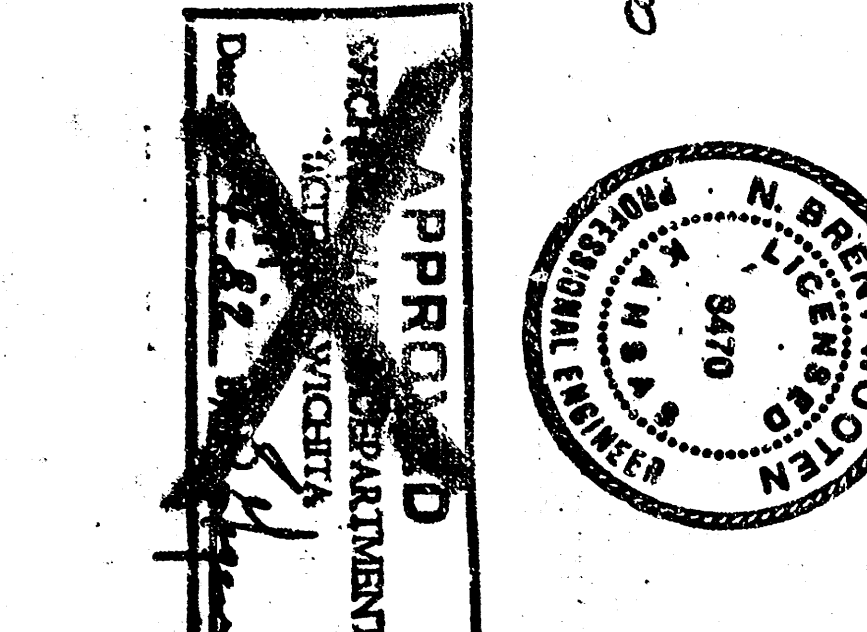
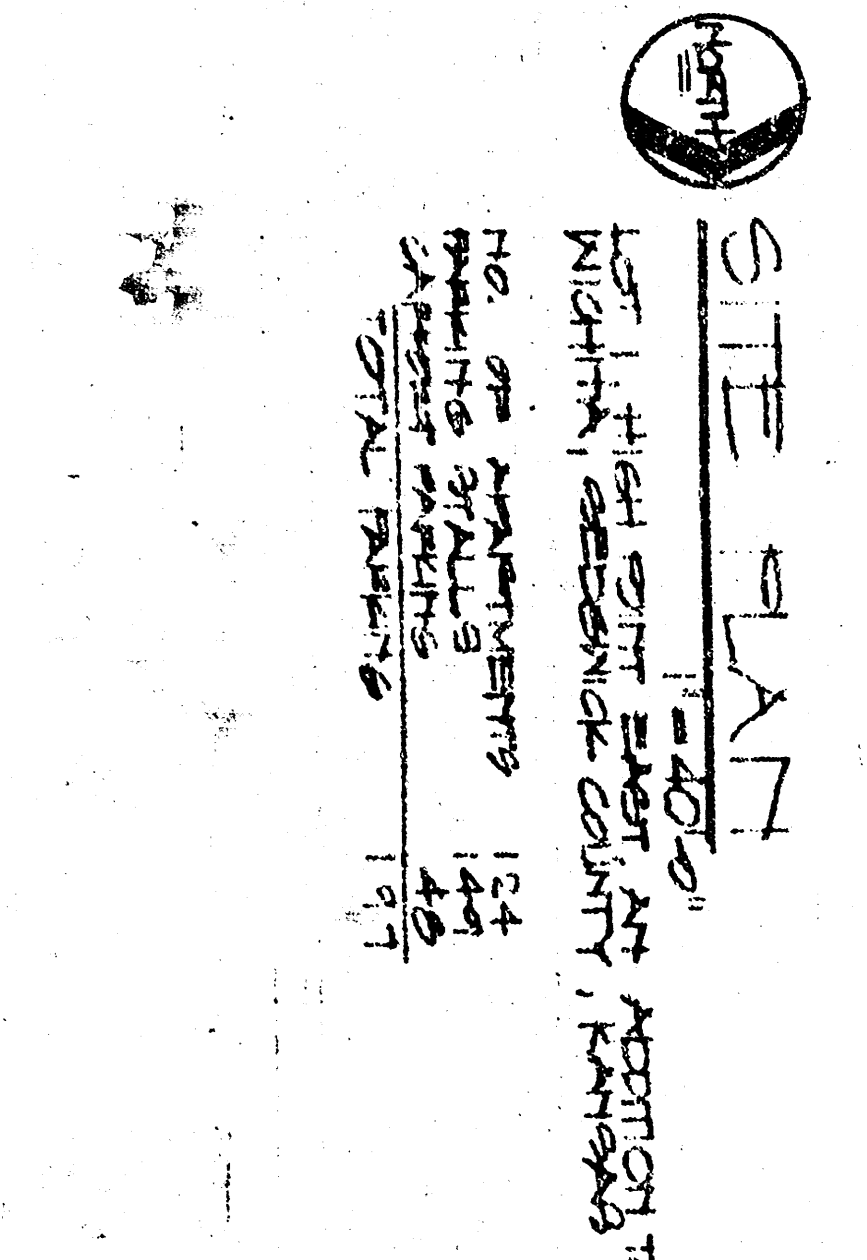


8-10-82  
APPROVED AS NOTED  
BY CITY ENGINEER OF WICHITA  
Sanitary Sewer  
Storm Sewer  
The City of Wichita  
\* 8" Sanitary Sewer only

Note: San. sewer Contractor shall maintain one lane open to traffic on Lincoln during construction of the sanitary sewer.

NOTE TO CONTRACTOR  
This project will be constructed under the supervision of the CITY ENGINEER and conforming to the SPECIFICATIONS of the CITY OF WICHITA. The CONTRACTOR will prepare the City of Wichita for all costs of inspection.

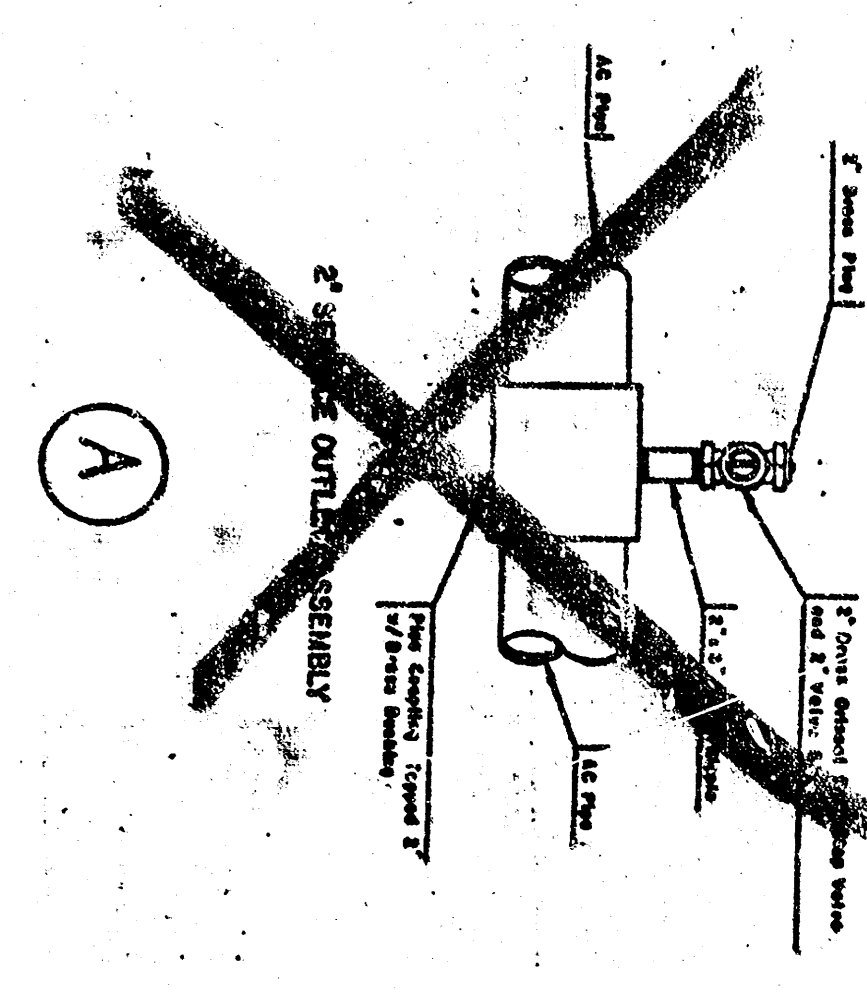

PRIVATE SANITARY SEWER, STORM WATER SEWER,  
A WATER LINE EXTENSIONS TO SERVE LOT 1,  
HIGH POINT EAST ADDITION, CITY OF WICHITA, KS.  
PROJECT NO. 468-76-245-80000-000-000-008

239 Patton • Suite 2  
Wichita, Kansas • 67211  
(316) • 263-8261

Architects • Planners • Commercial Consultants  
Keith Parker Associates

Issue

TO: CHIEF OF  
SANITARY SEWER  
DIVISION  
FROM: CHIEF OF  
STORM SEWER  
DIVISION  
DATE: 8-10-82  
BY: [Signature]  
CHECKED BY: [Signature]  
APPROVED BY: [Signature]

FILED FROM THE BEST  
AVAILABLE COPY