
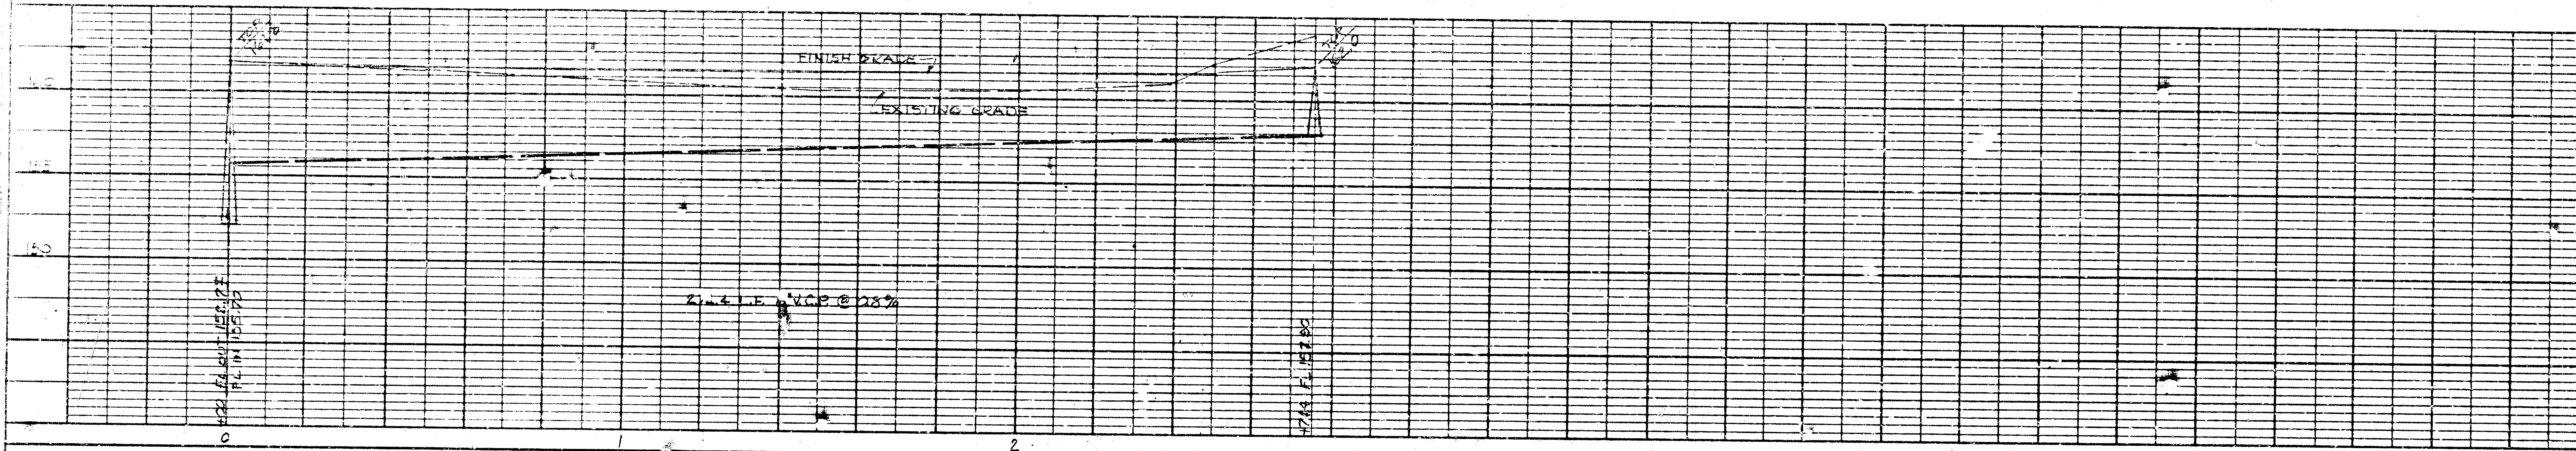


5-29-74

APPROVED AS NOTED
By CITY ENGINEER OF WICHITA
Sanitary Sewers D.E.S.
Storm Sewers _____
Driveway Approaches _____

SCALE
1" = 5' VERT.
1" = 20' HORIZ.

NOTE TO CONTRACTOR
This project will be constructed under the supervision of the CITY ENGINEER and conforming to the SPECIFICATIONS of the CITY OF WICHITA. The CONTRACTOR will reimburse the City of Wichita for all cost of Engineering, Plans, and Inspection.

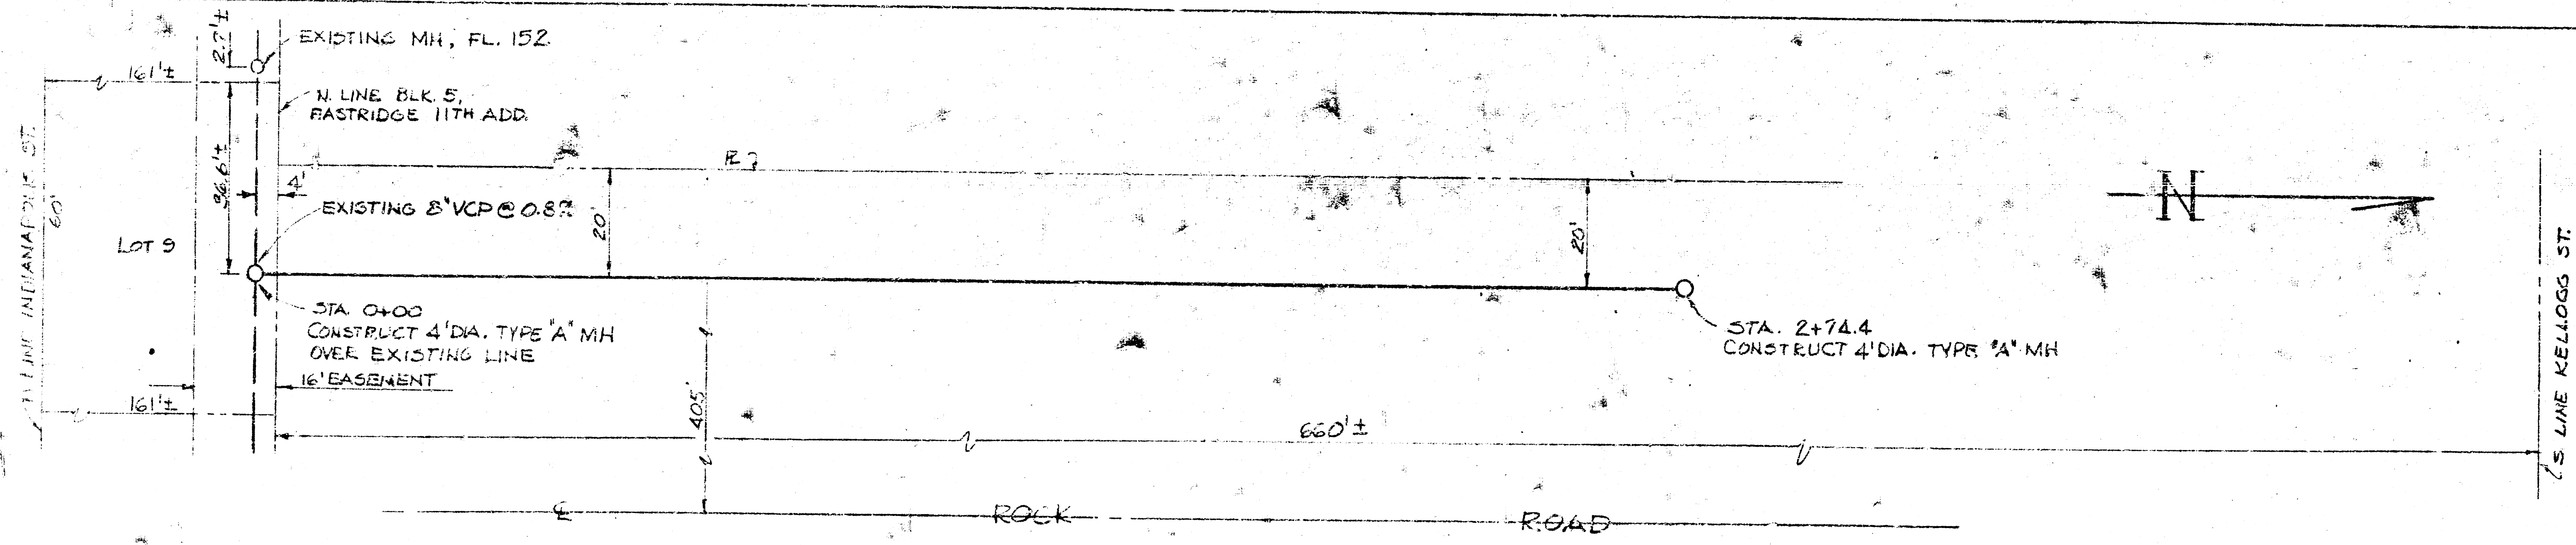

SCALE
1" = 5' VERT.
1" = 20' HORIZ.

NOTES:
ALL MANHOLES TO BE BUILT TO CITY OF WICHITA SPECIFICATIONS (SEE SHEET 2).
LINE TO BE SAND BACKFILLED AND FLUSHED.



PLAN & PROFILE
PRIVATE SANITARY SEWER
TO SERVE HILTON INN
WICHITA, KANSAS
PROJ. NO. DBKW 704031

MOHRING & ASSOC. CONSULTING ENGINEERS
314 BROWN BLDG. WICHITA, KANSAS