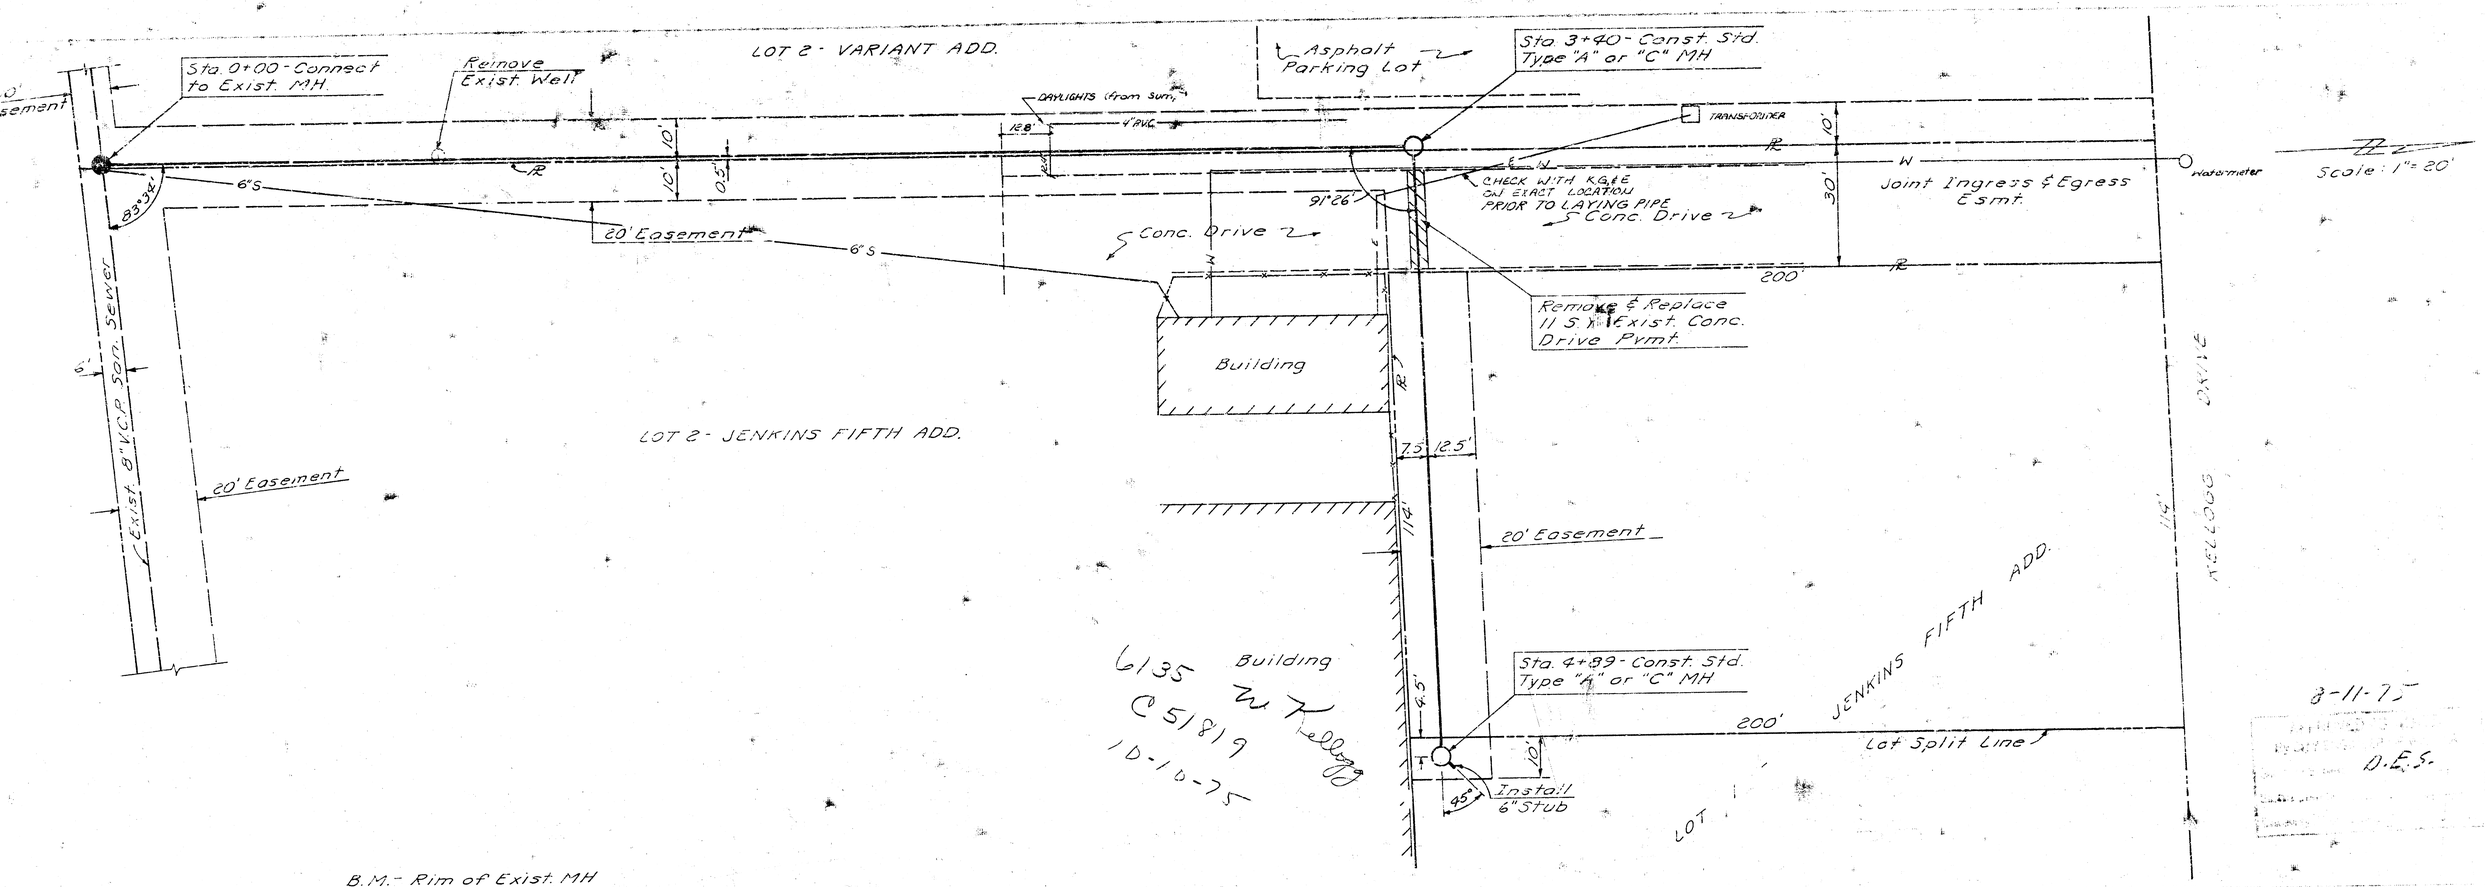

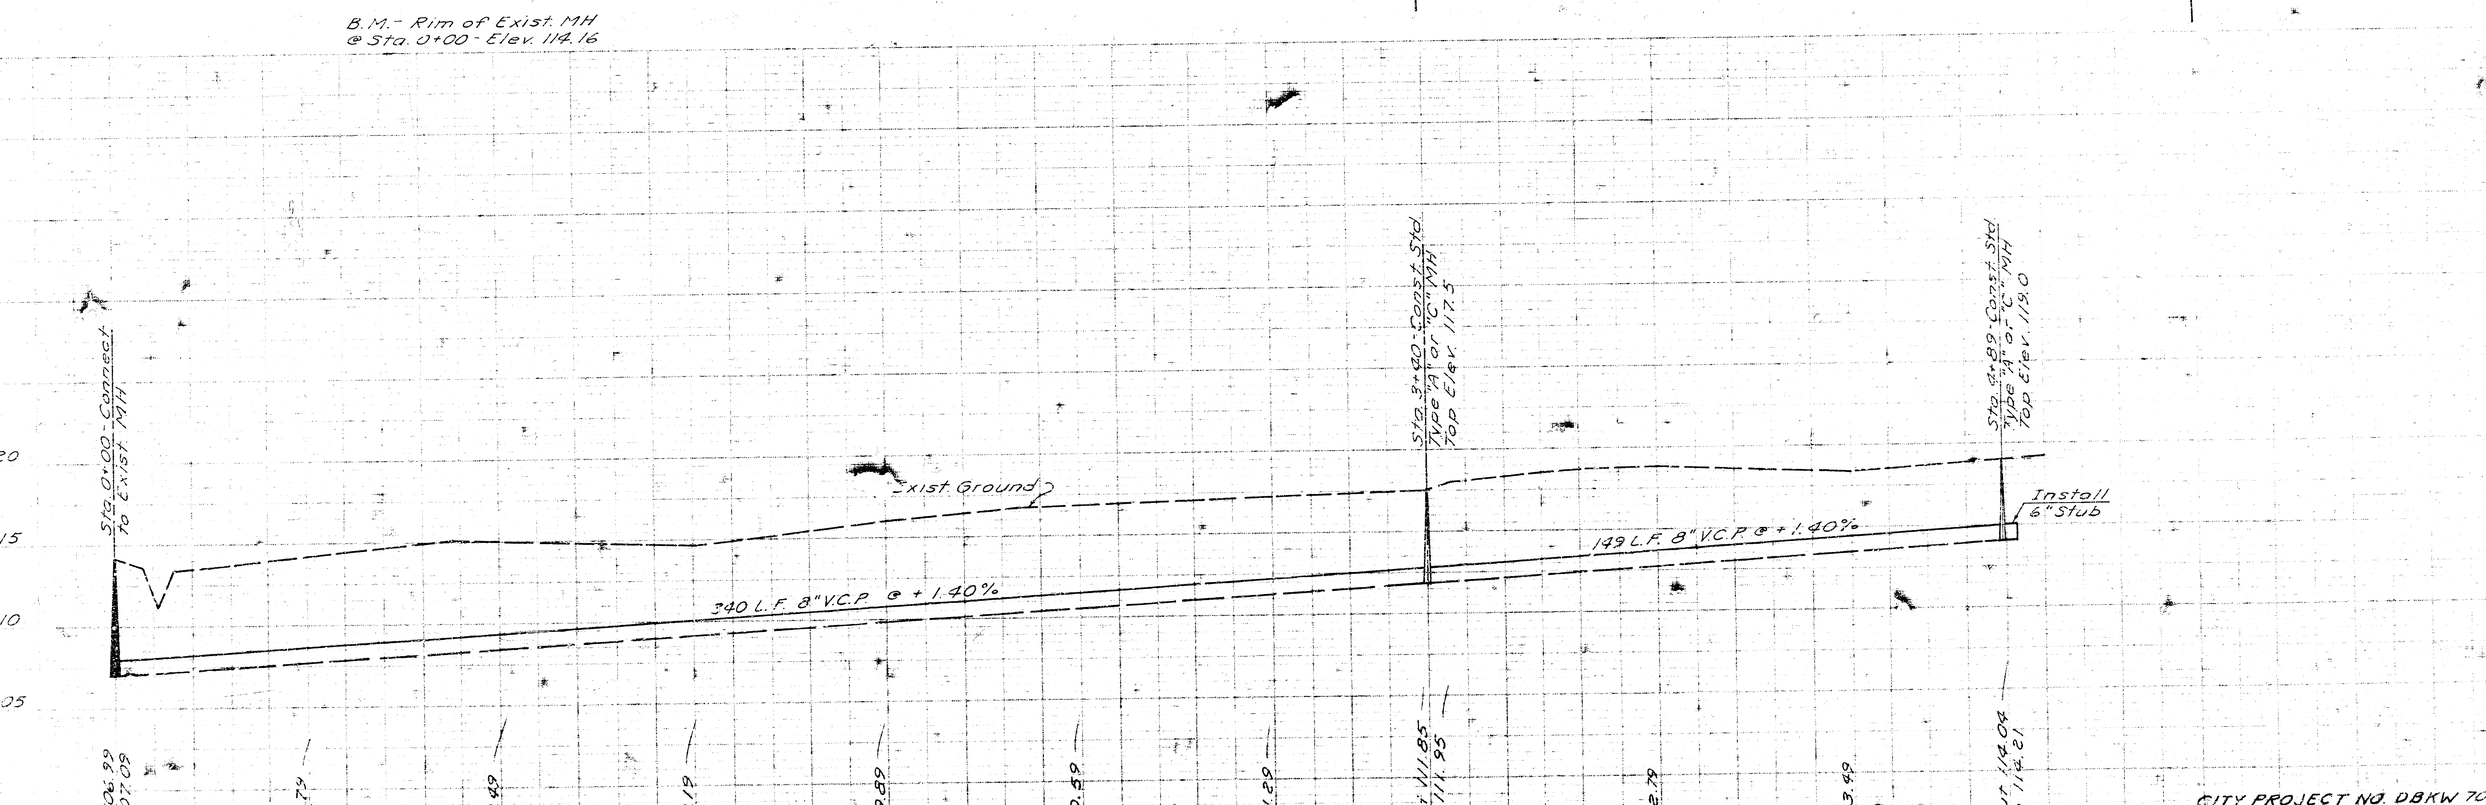

CITY PROJECT NO. DBKW 705022
LOT 1 - JENKINS FIFTH ADD.