
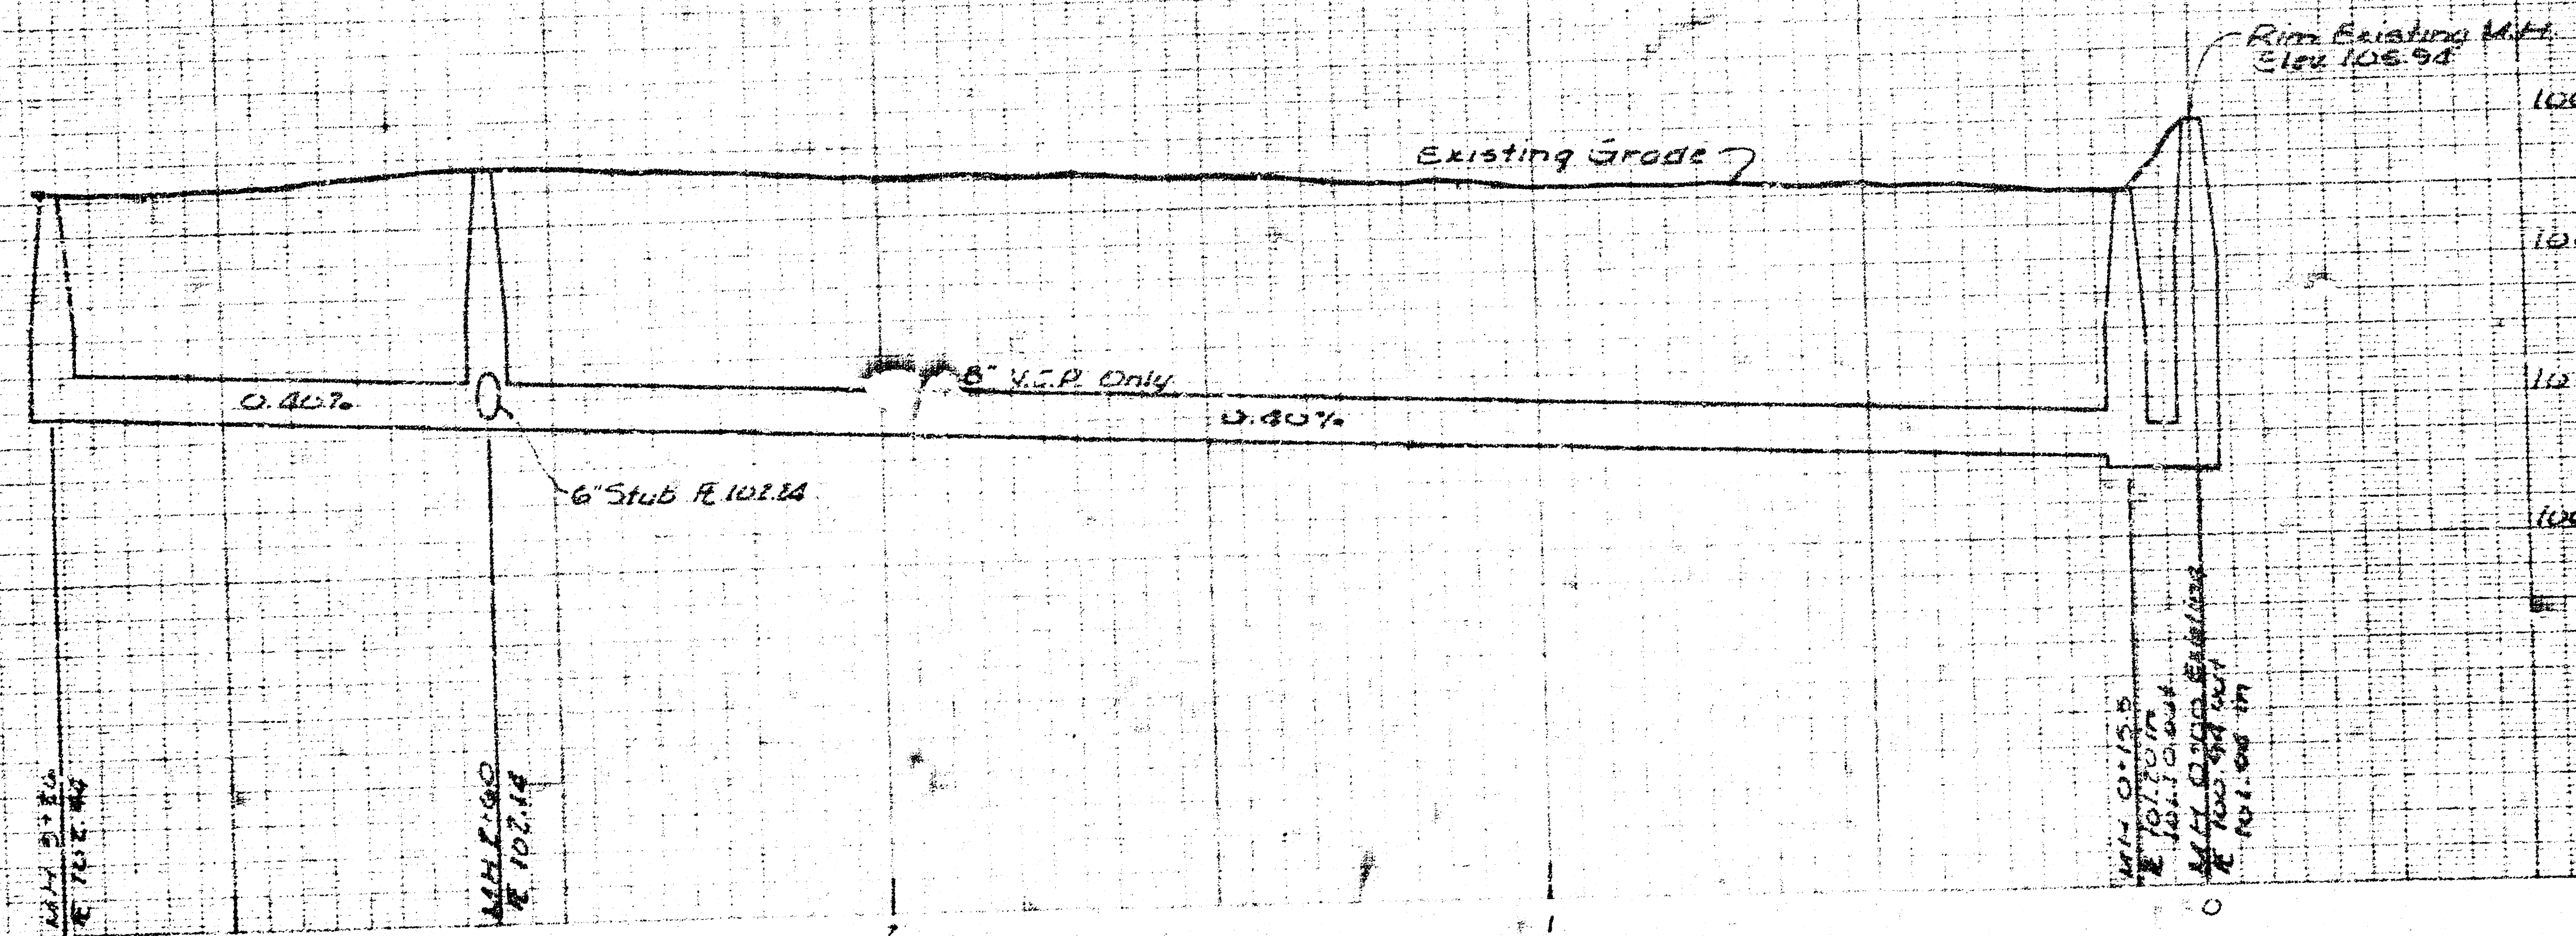



Sanitary Sewers \_\_\_\_\_  
Storm Sewers \_\_\_\_\_  
Driveway Approaches \_\_\_\_\_

- Intersection of A.T. & S.F. R.R.  
And West Street Near NE Cor.  
Sec 2, T28S, R1W

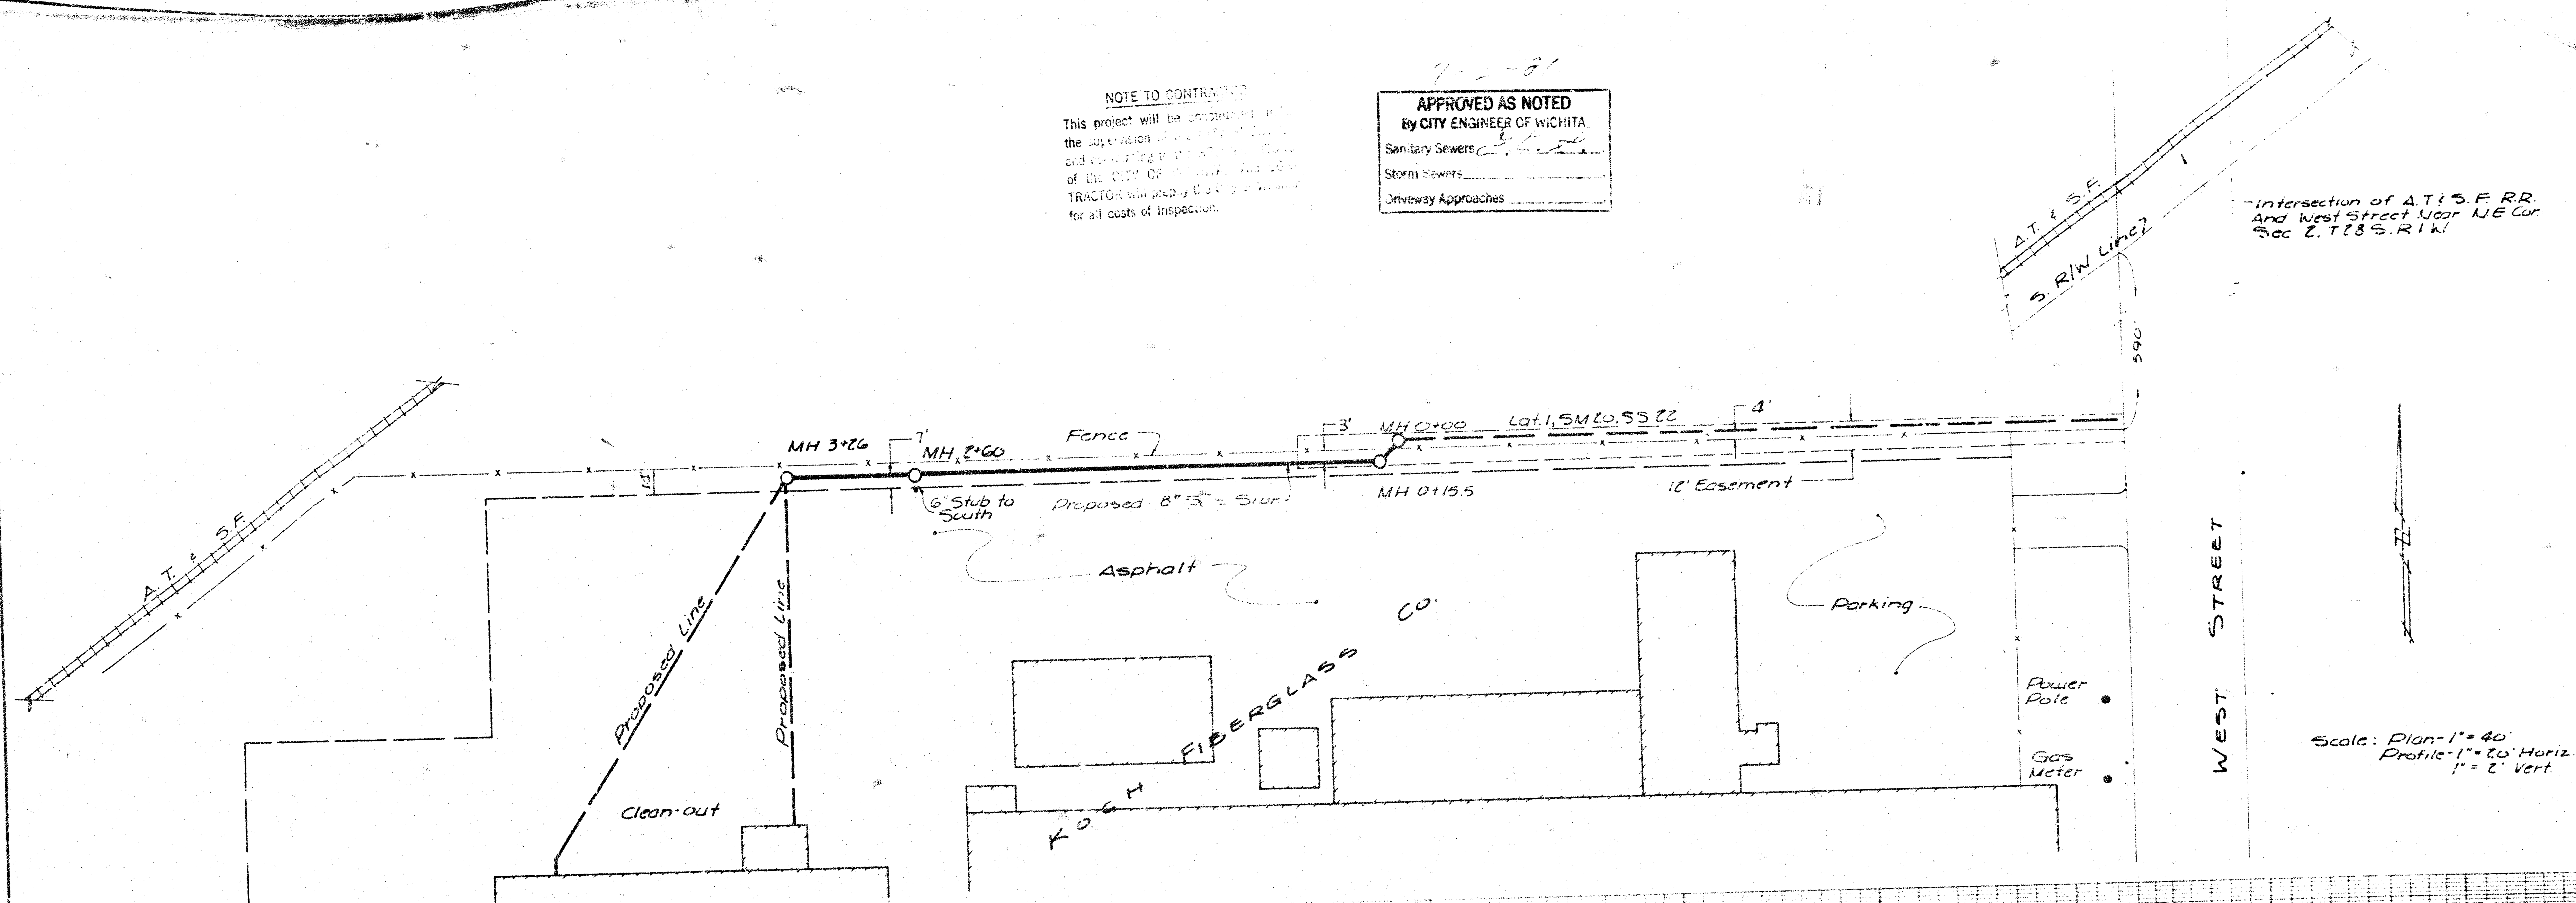

FILMED FROM THE BEST  
AVAILABLE COPY ....

REISS & GOODNESS ENGINEERS  
2100 WEST 21<sup>ST</sup> STREET  
WICHITA, KANSAS 67204  
(316) 832-0213

City of Wichita Project No 468-76-745-80000-000-000-008

**KOCH FIBERGLASS PRODUCTS COMPANY**

|       |         |             |
|-------|---------|-------------|
| SCALE | Given   | PROJECT NO. |
| DATE  | 6-29-81 | SHEET 1 OF  |