
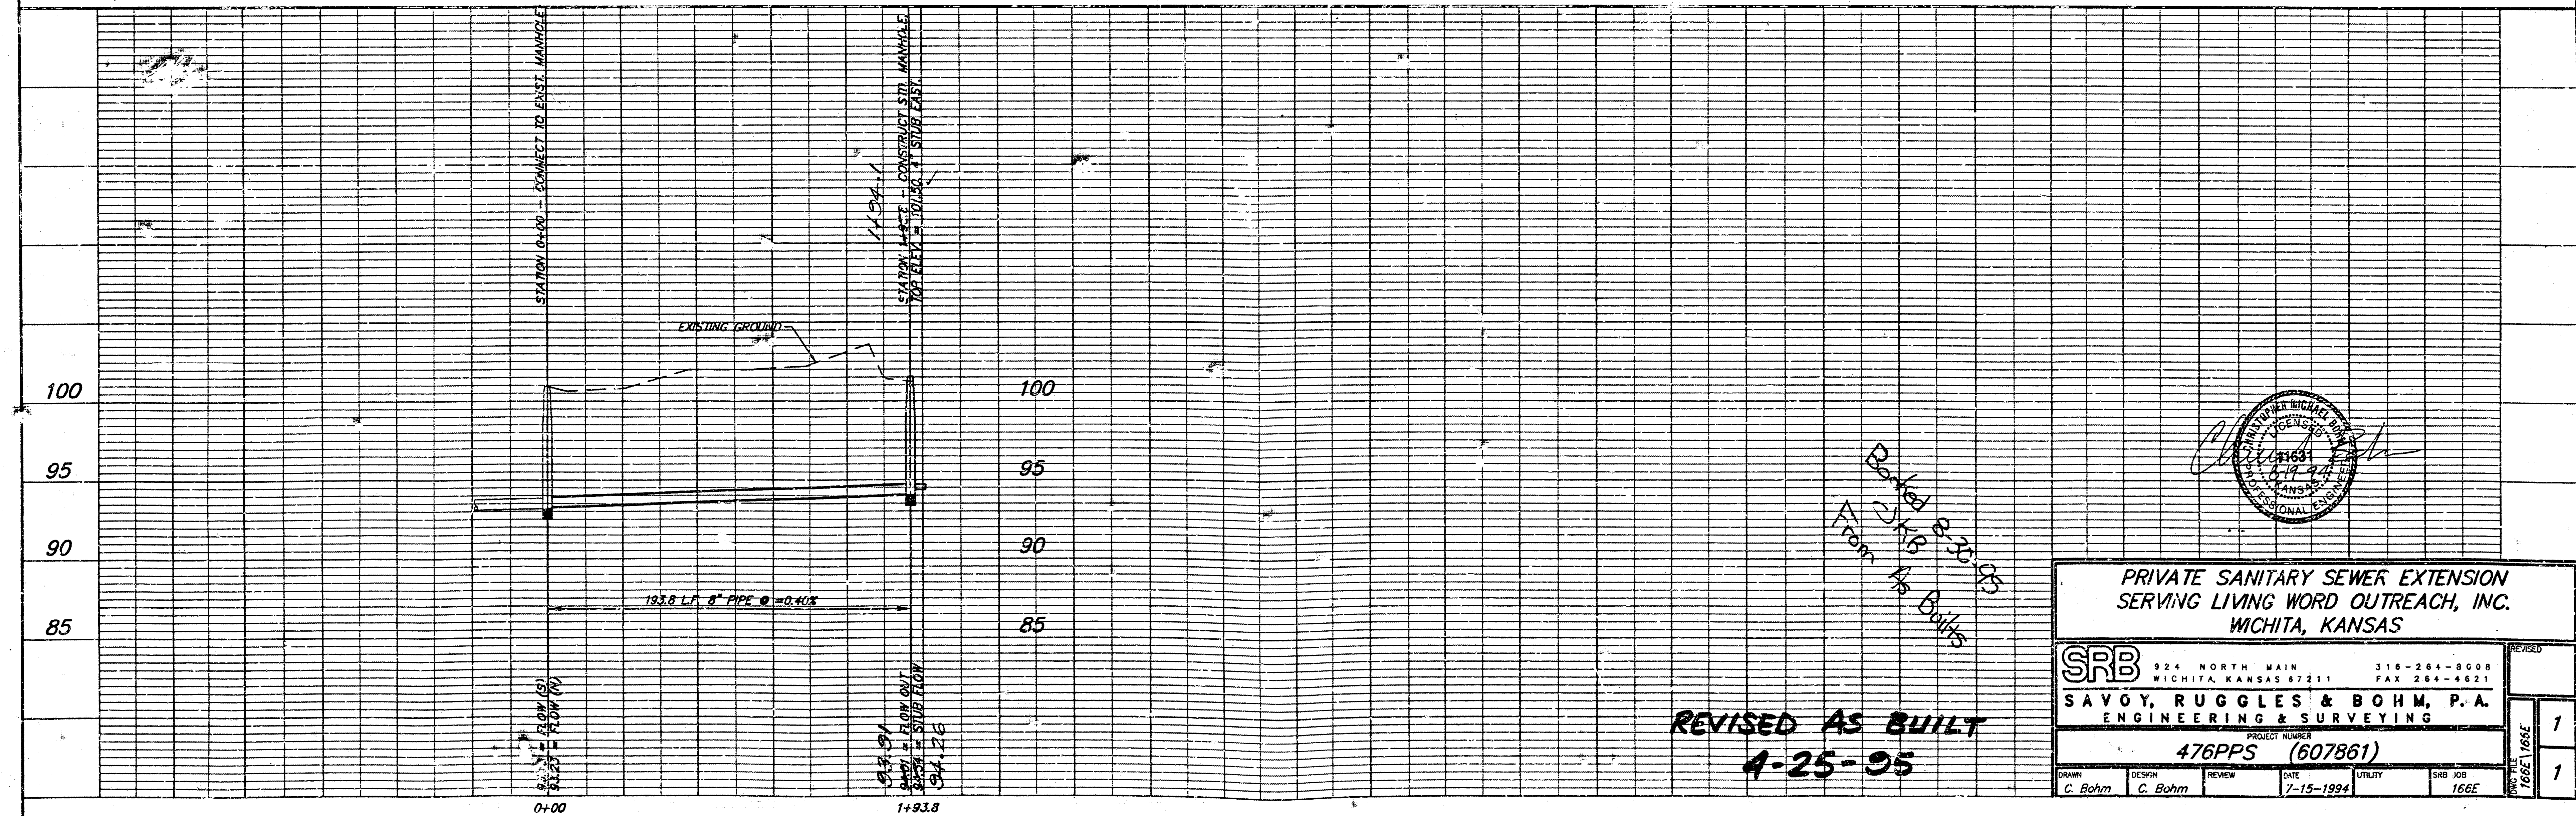


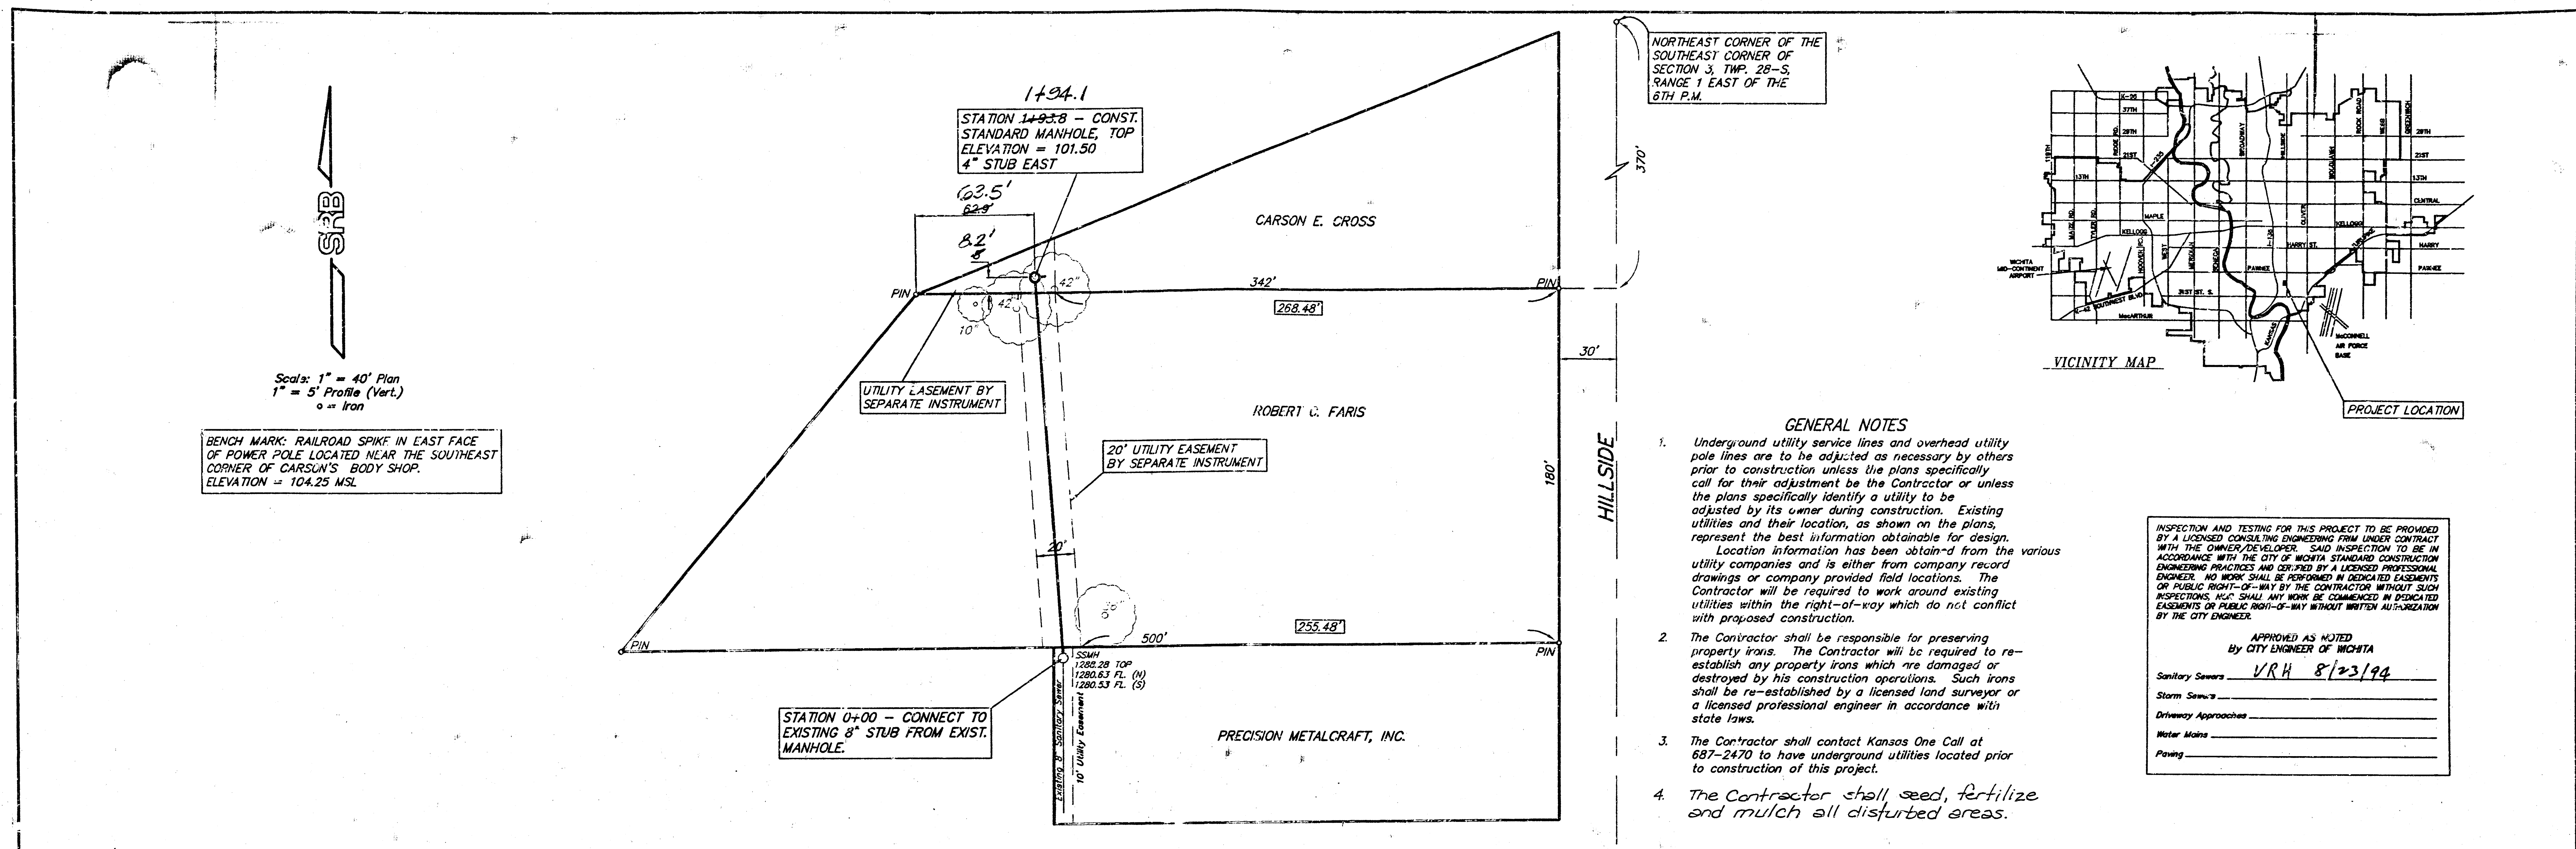

**PRIVATE SANITARY SEWER EXTENSION
SERVING LIVING WORD OUTREACH, INC.
WICHITA, KANSAS**

SRB 924 NORTH MAIN 316-264-8008
WICHITA, KANSAS 67211 FAX 264-4621

SAVOY, RUGGLES & BOHM, P.A.
ENGINEERING & SURVEYING

PROJECT NUMBER
476PPS (607861)

DRAWN C. Bohm	DESIGN C. Bohm	REVIEW	DATE 7-15-1994	UTILITY	SRB JOB 166E
------------------	-------------------	--------	-------------------	---------	-----------------

18-13-5-5