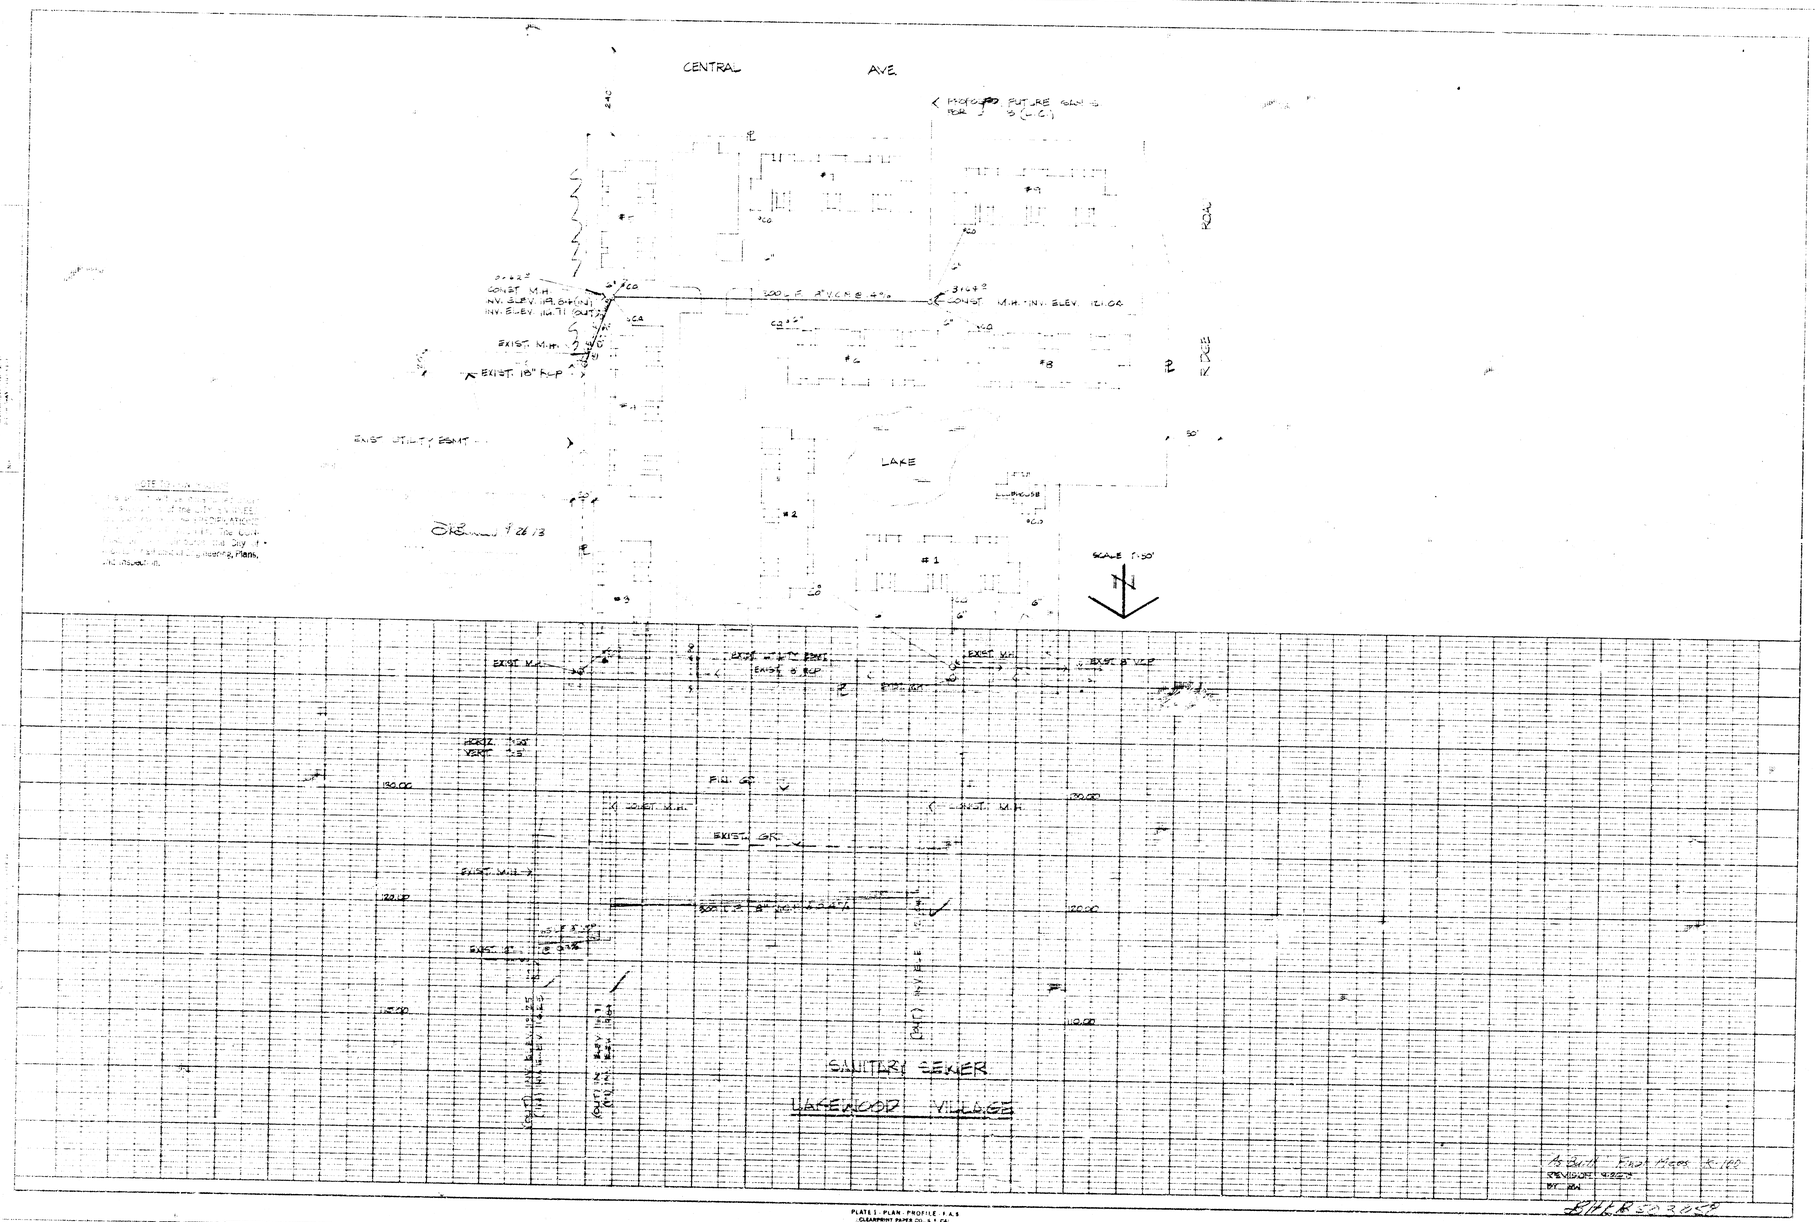
CENTRAL AVE.
PROPOSED FUTURE ROAD FOR S (L-C)
CONST. M.H.
INV. ELEV. 121.64 (IN)
INV. ELEV. 114.71 (OUT)
EXIST. M.H.
EXIST. 18" RCP
500 L.F. 8" VCP @ 4%
CONST. M.H. INV. ELEV. 121.00
EXIST. UTILITY EASMT.
LAKE
#1
#2
#3
#4
#5
#6
#7
#8
#9
HOUSE
SCALE 1"=50'
EXIST. M.H.
EXIST. UTILITY EASMT.
EXIST. 8" RCP
EXIST. 8" VCP
HORIZ. 1"=50'
VERT. 1"=5'
150.00
140.00
130.00
120.00
110.00
FIN. GR.
EXIST. GR.
CONST. M.H.
EXIST. WALK
EXIST. 12"
SANITARY SEWER
LAKEWOOD VILLAGE
As Built Final Plans R.W.
BY RM
PLATE 1 - PLAN - PROFILE - F.A.S.
CLEARPRINT PAPER CO., S.F. CAL.
NO. 1000R-1

14 2 4 (14)