 

MAP OF

REPLAT OF LAWN TERRACE

AND

KRUEGER'S ADD.

SEDGWICK CO KANSAS

WITH

SEWER WYES

AND

WATER CONNECTIONS

SCALE 1" = 100'

A CHITA 1960

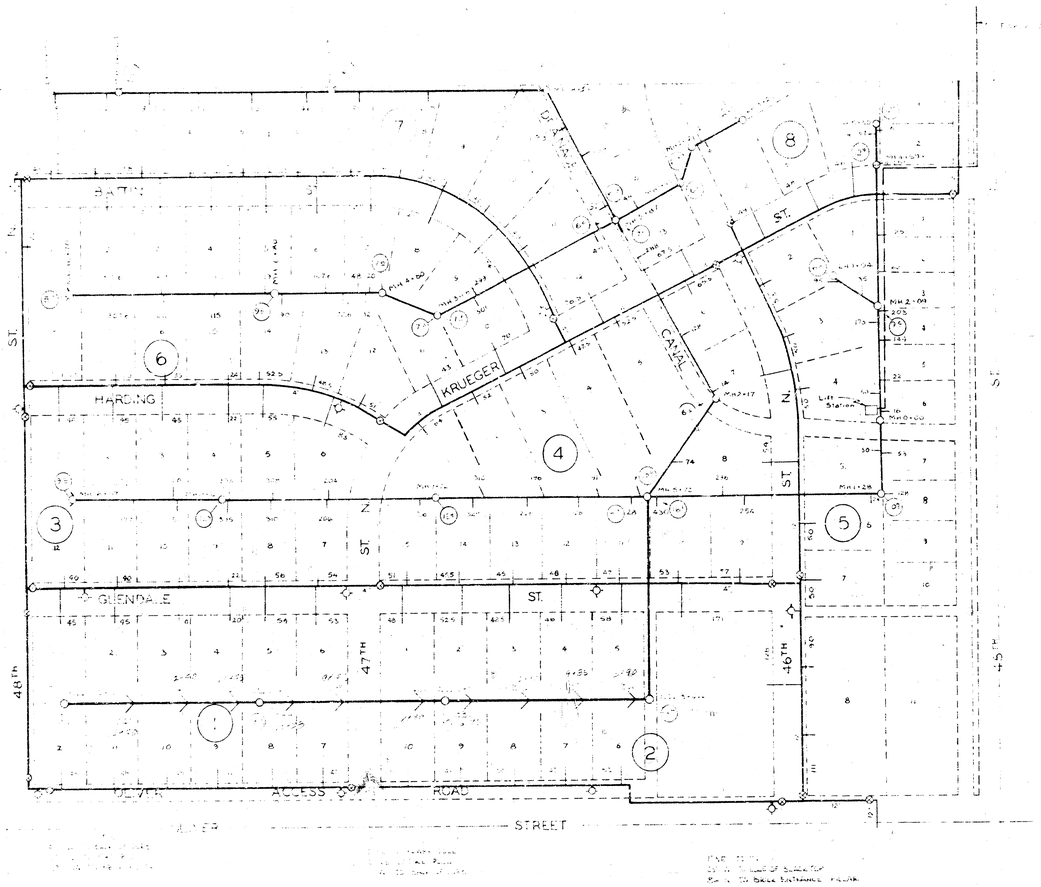

MAP OF

REPLAT OF LAWN TERRACE

AND

KRUEGER'S ADD.

SEDGWICK CO. KANSAS

WITH

SEWER WYES

AND

WATER CONNECTIONS

SCALE 1" = 100'

REISS AND GOODNESS

ENGINEERS

WICHITA 1960

JUL 5 1960

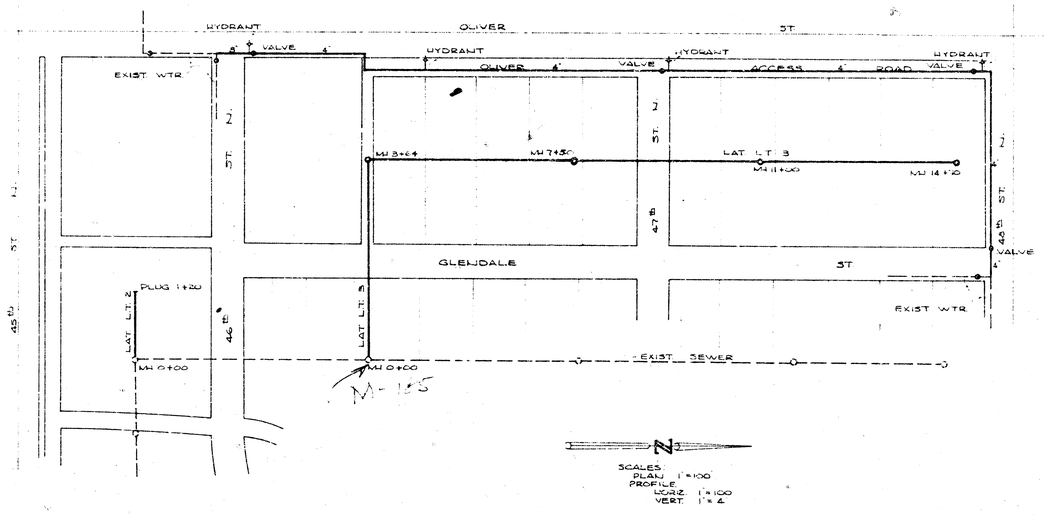

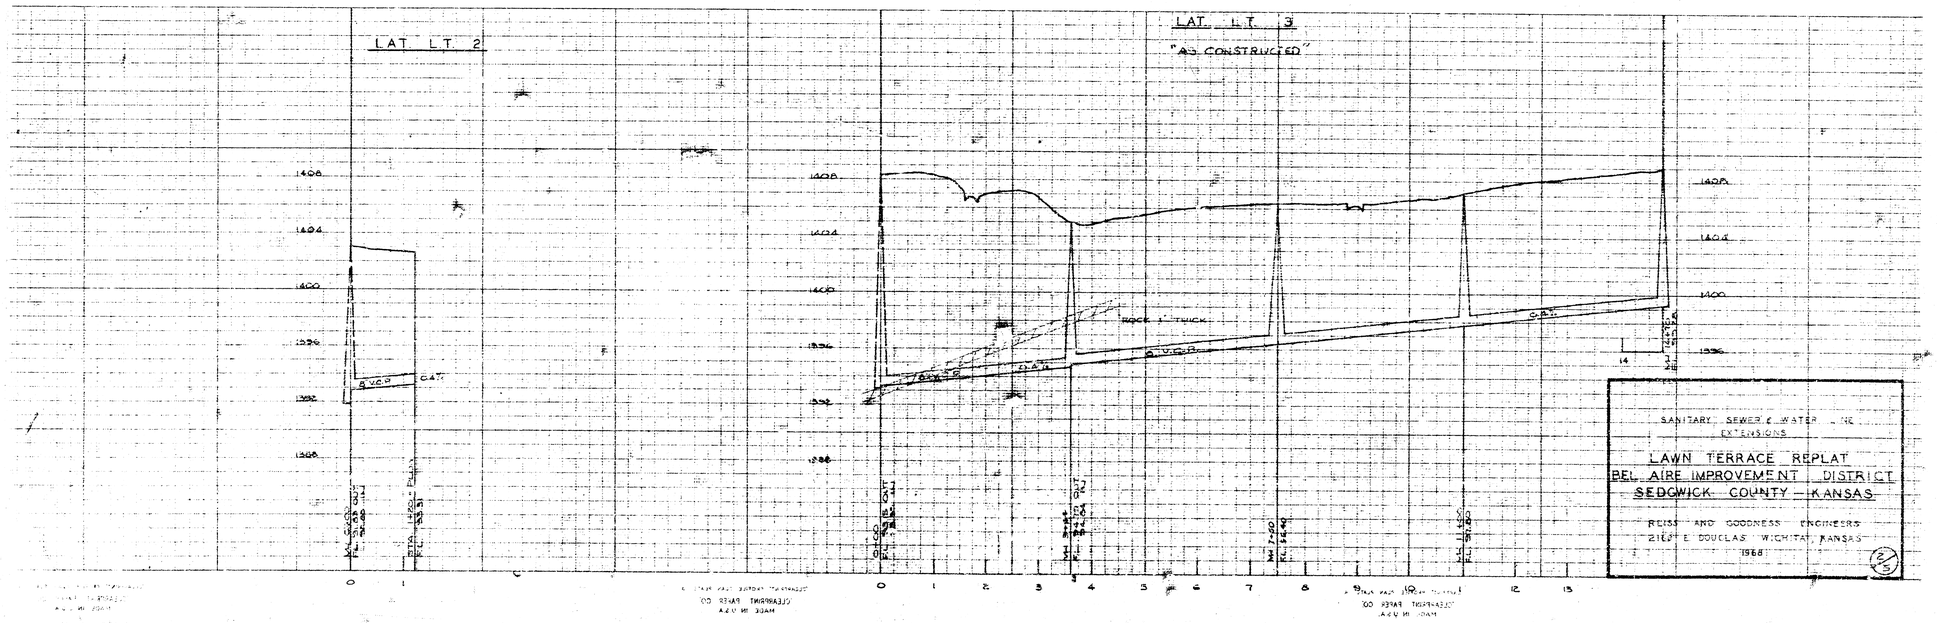

SANITARY SEWER & WATER LINE EXTENSIONS

LAWN TERRACE REPLAT
BEL AIRE IMPROVEMENT DISTRICT
SEDGWICK COUNTY — KANSAS

REISS AND GOODNESS ENGINEERS
215 E. DOUGLAS WICHITA, KANSAS
1968

(2/5)

JUL 5 1973