


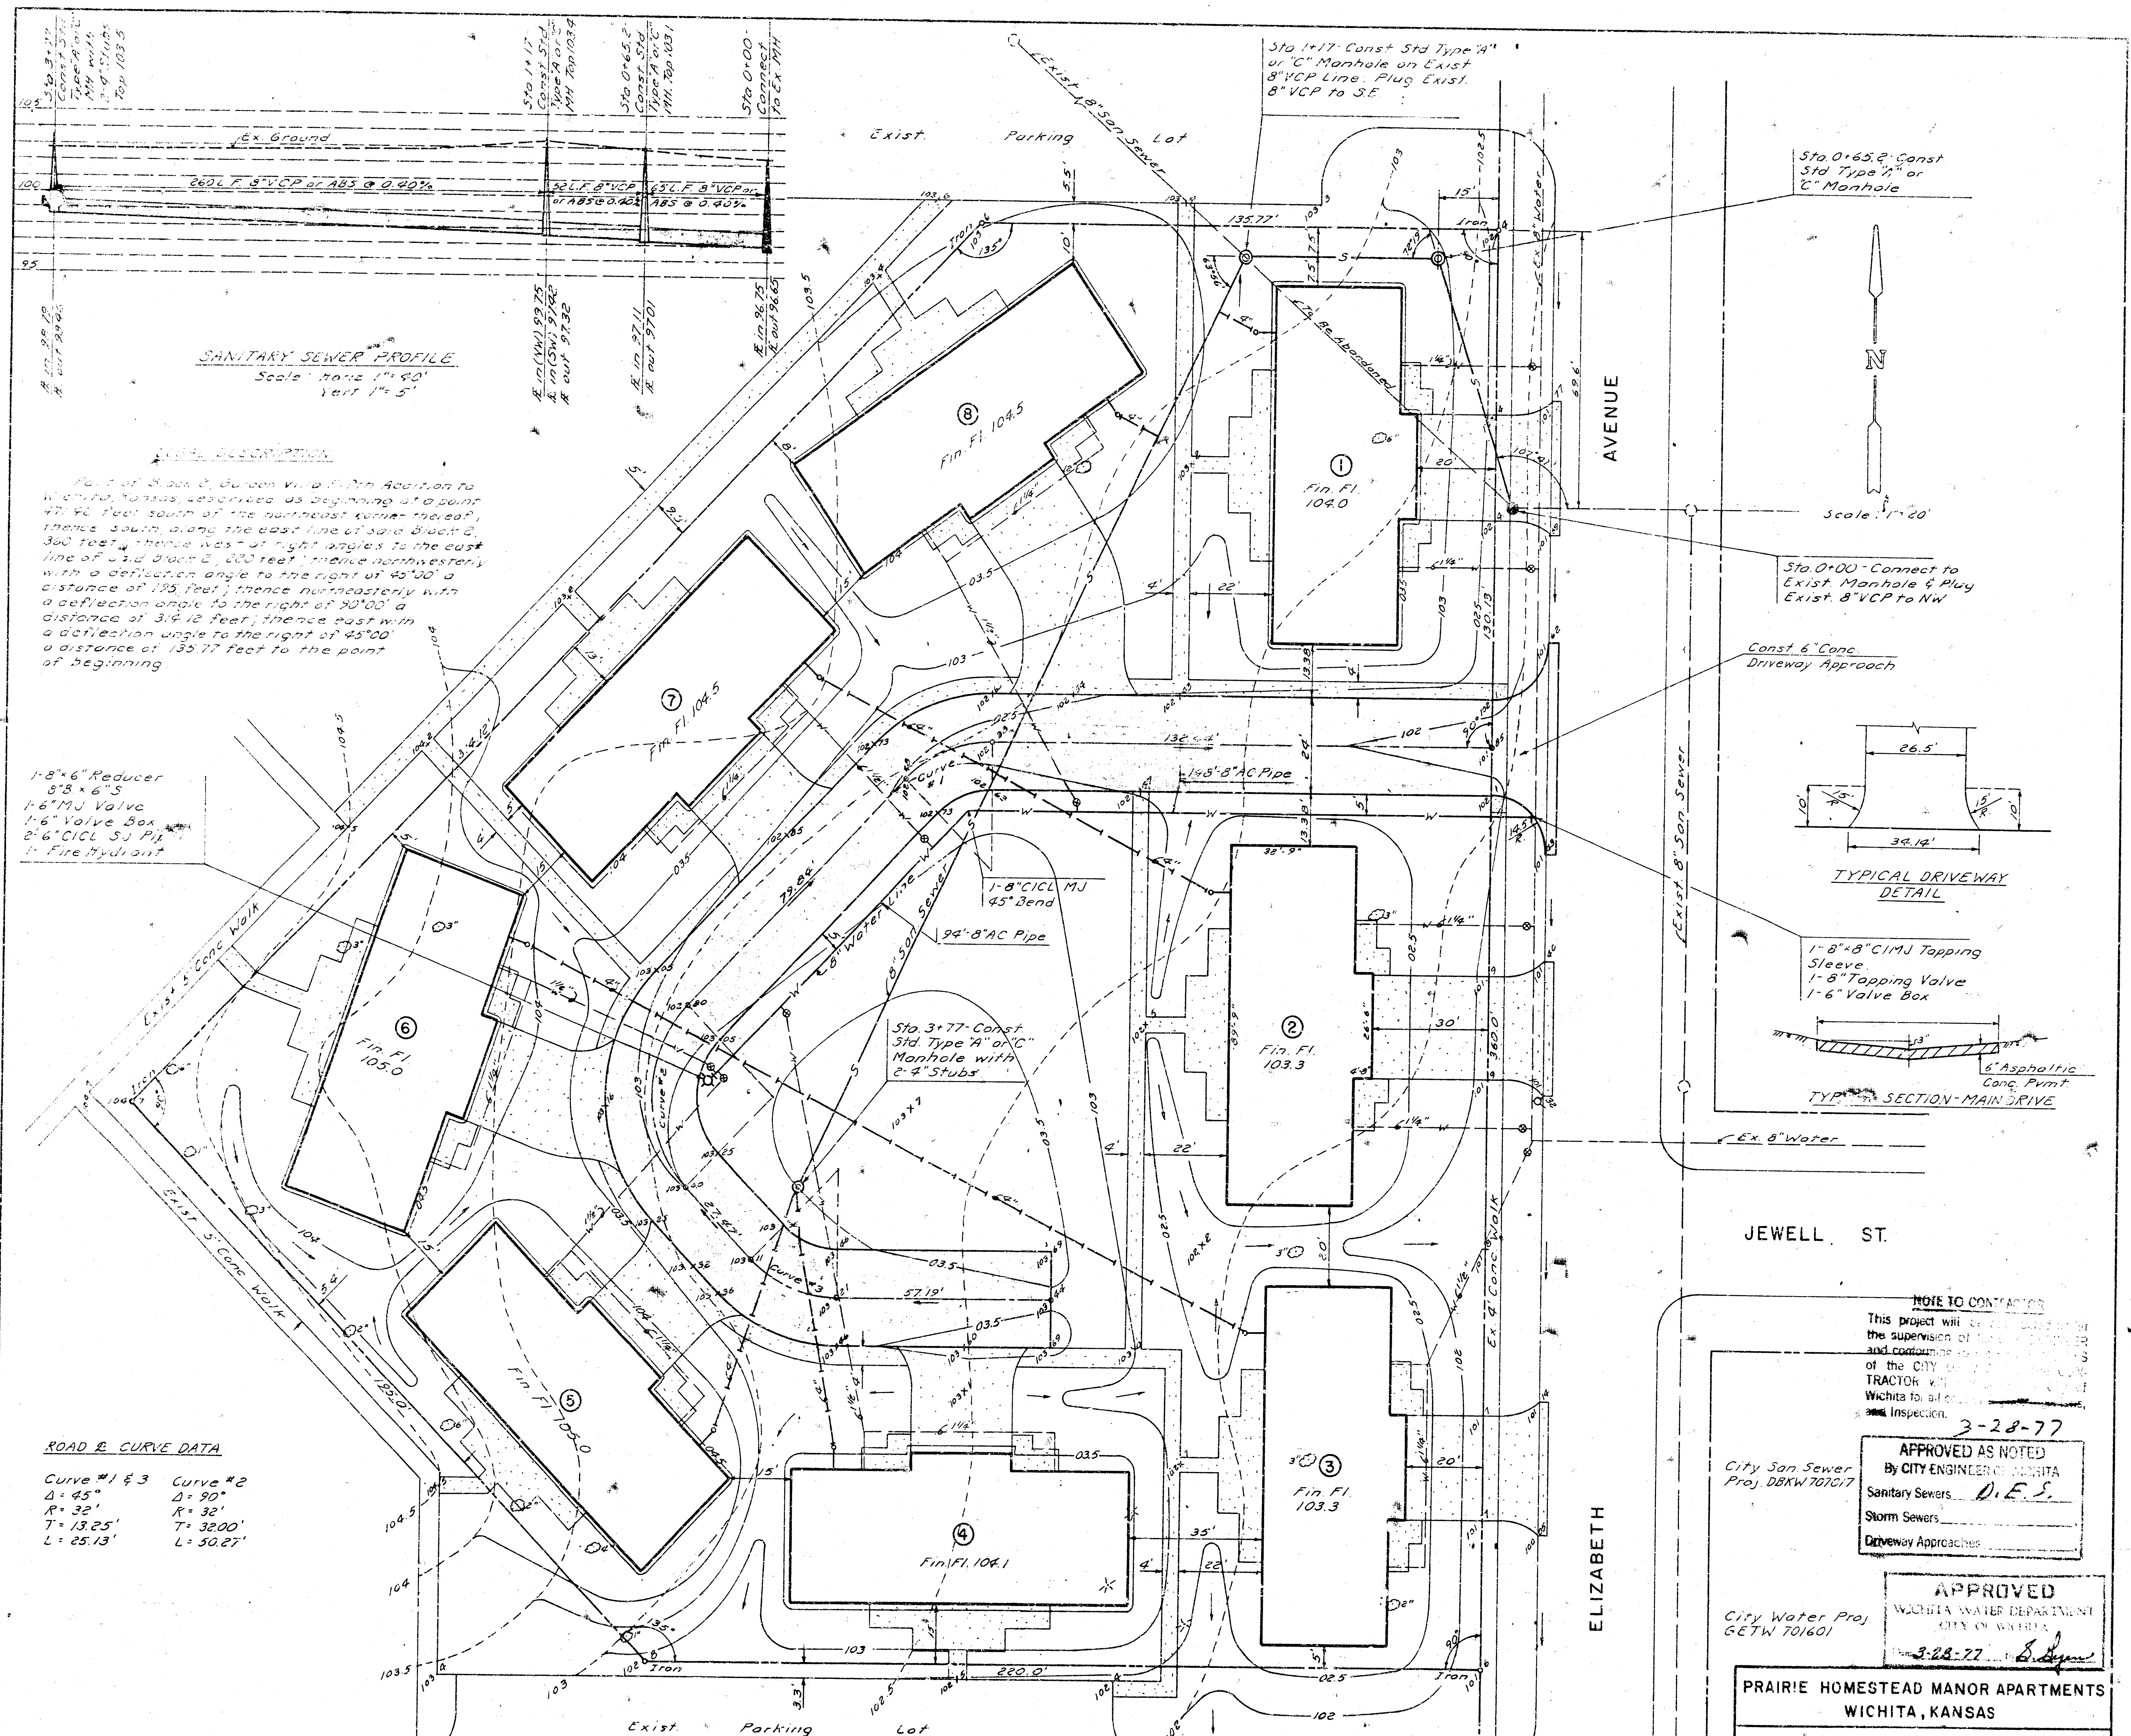

NOTE TO CONTRACTOR
This project will be not subject to the supervision of the City Engineer and contingency for the City of the CITY OF Wichita. The CONTRACTOR will be responsible for the City of Wichita for all other work not under inspection.

3-28-77

APPROVED AS NOTED
Sanitary Sewers D.E.S.
Storm Sewers _____
Driveway Approaches _____

City San Sewer
Proj. DBKW7070i7

APPROVED AS NOTED
Sanitary Sewers D.E.S.
Storm Sewers _____
Driveway Approaches _____

City Water Proj.
GETW 701601

APPROVED
WICHITA WATER DEPARTMENT
CITY OF WICHITA
3-28-77 *S. Lynn*

PRAIRIE HOMESTEAD MANOR APARTMENTS
WICHITA, KANSAS