



4091 R.R. spike in side, R. Pole on
S.W. cor. Woodchuck Ln. & Hendryx St.

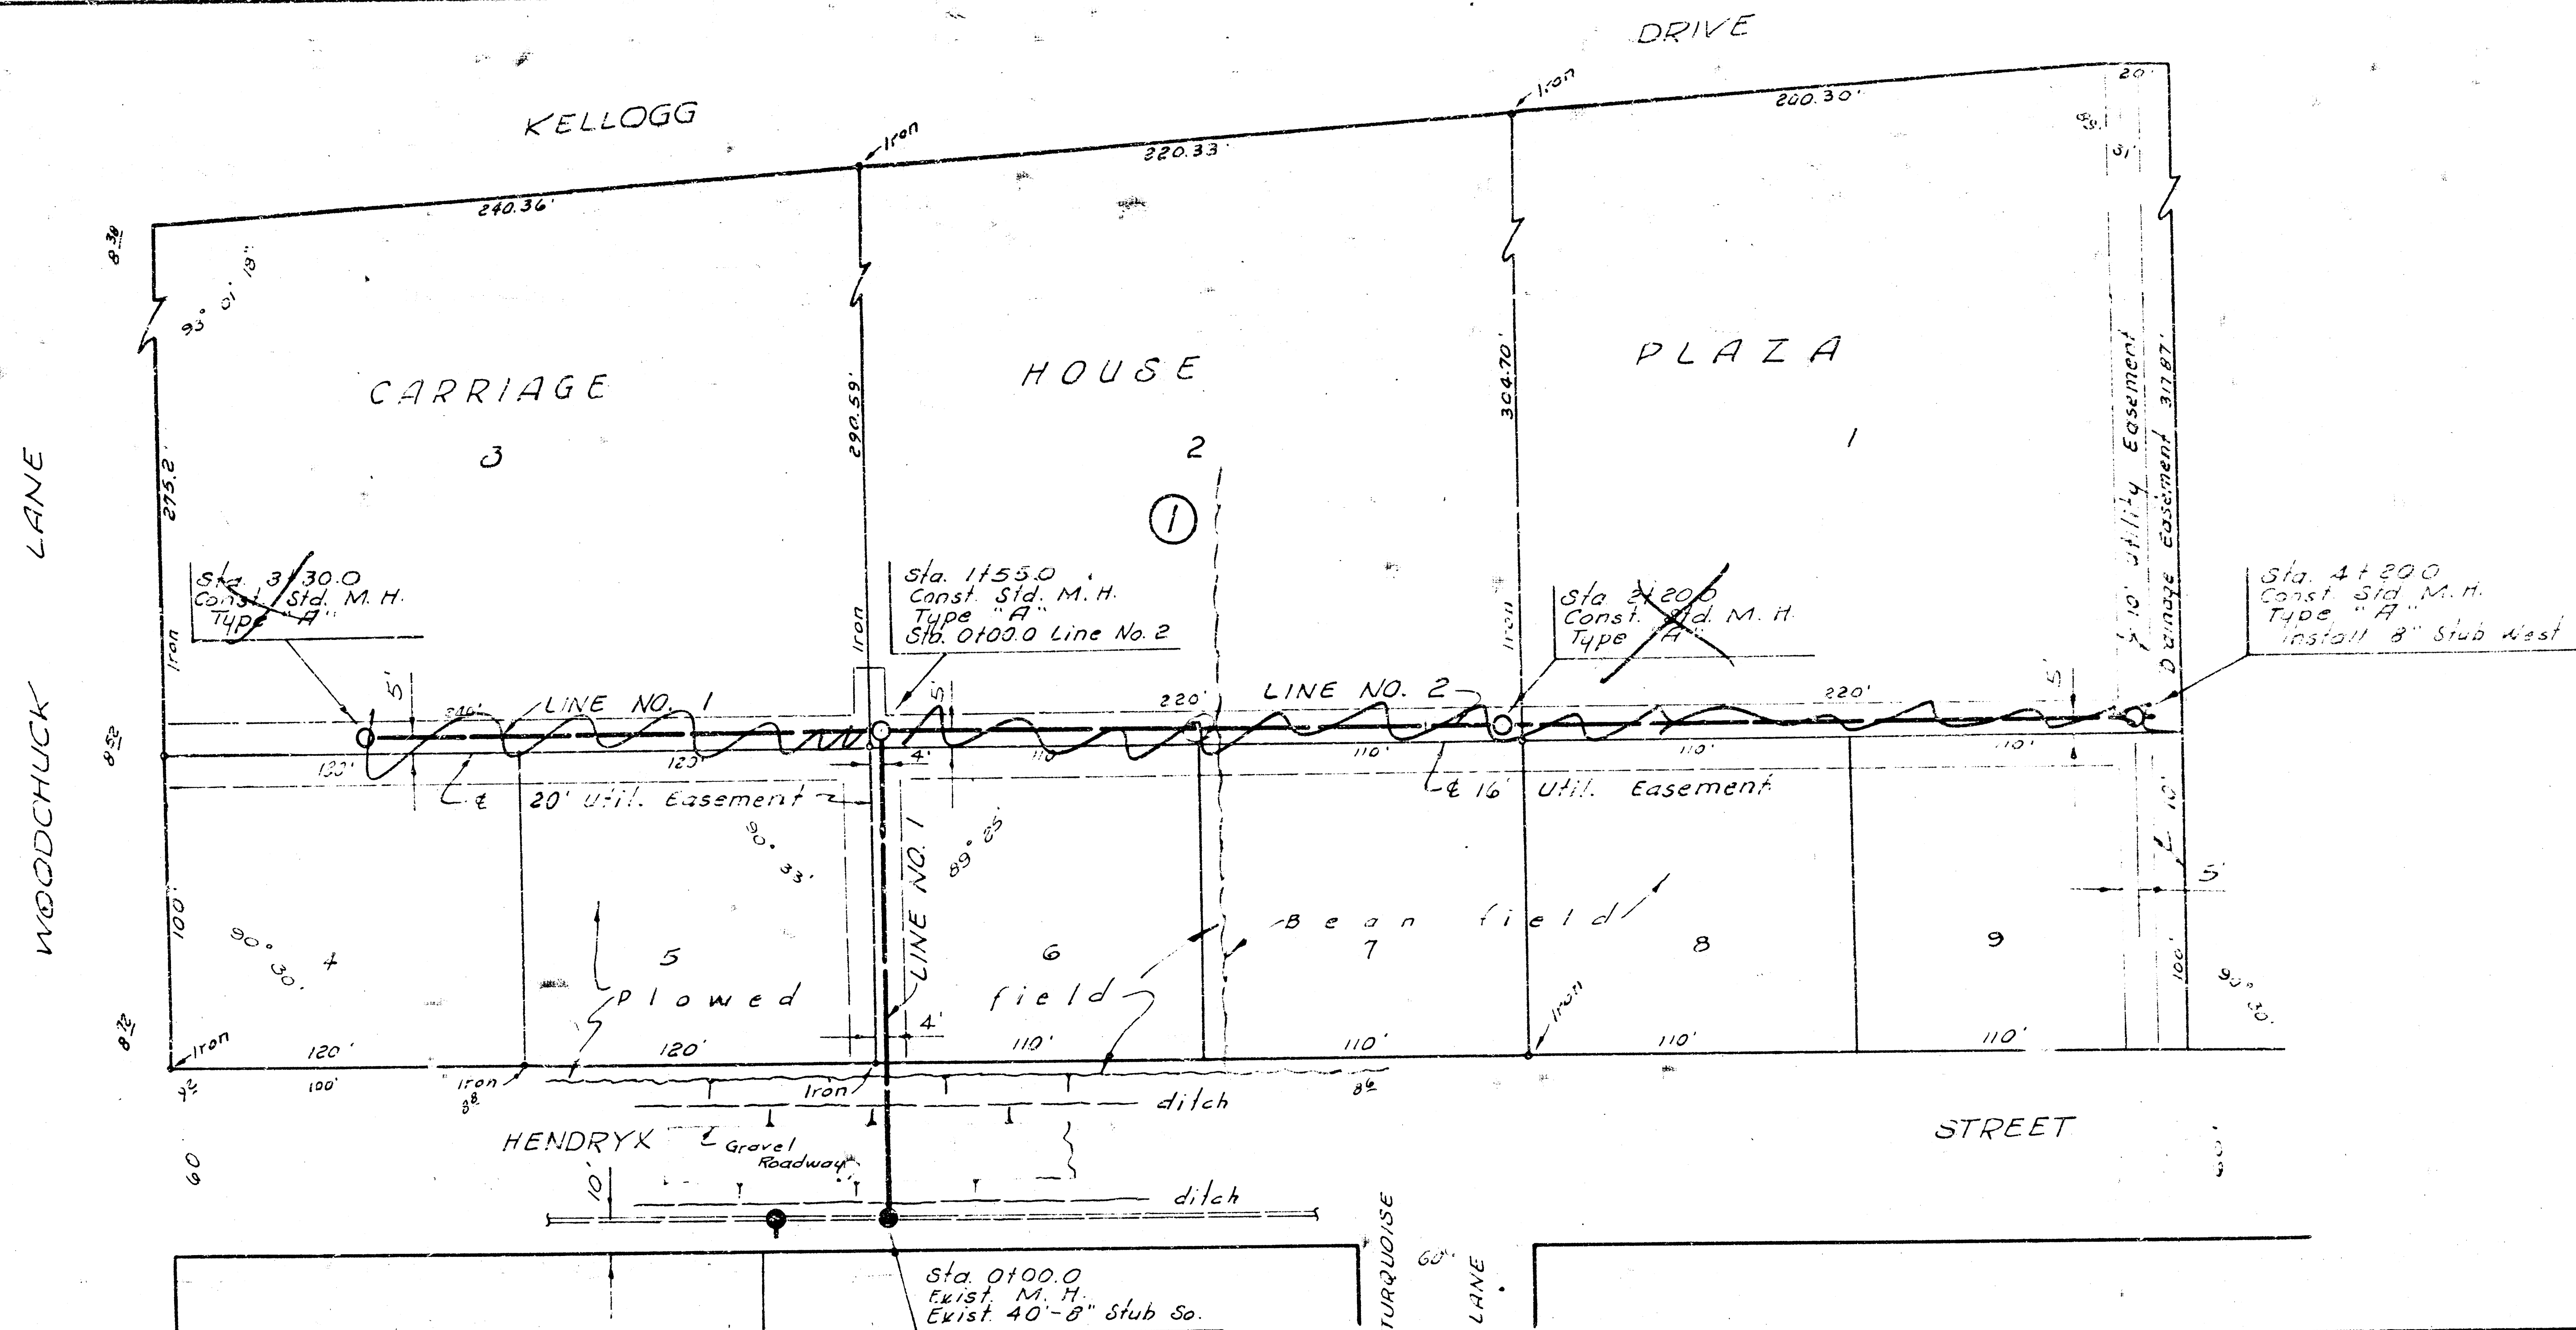

Plan Scale 1" = 40'
Profile Scale 1" = 10'

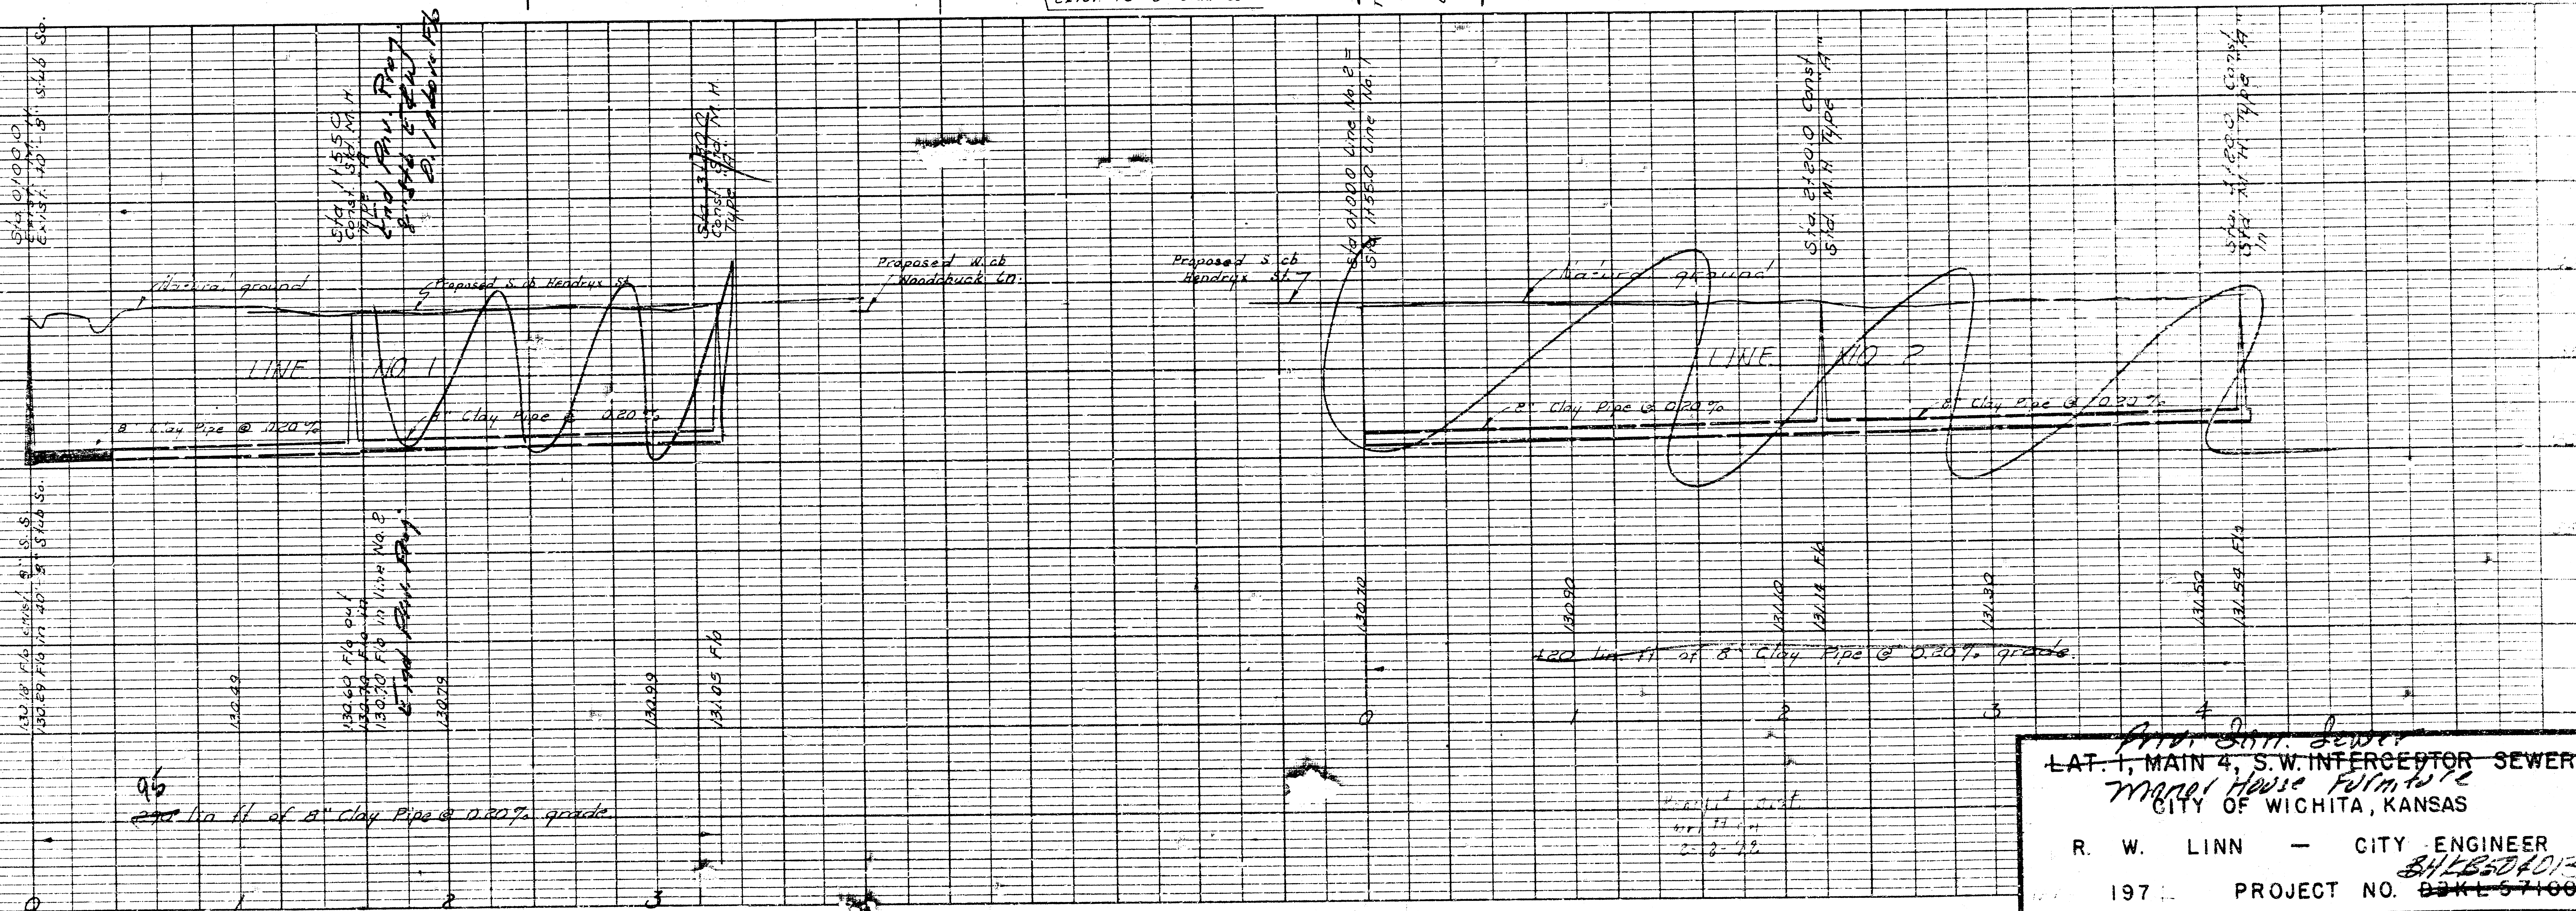

Lat. 1, Main 4, S.W. Interceptor Sewer
Municipal House Form
CITY OF WICHITA, KANSAS
R. W. LINN - CITY ENGINEER
197 PROJECT NO. 8415-57100