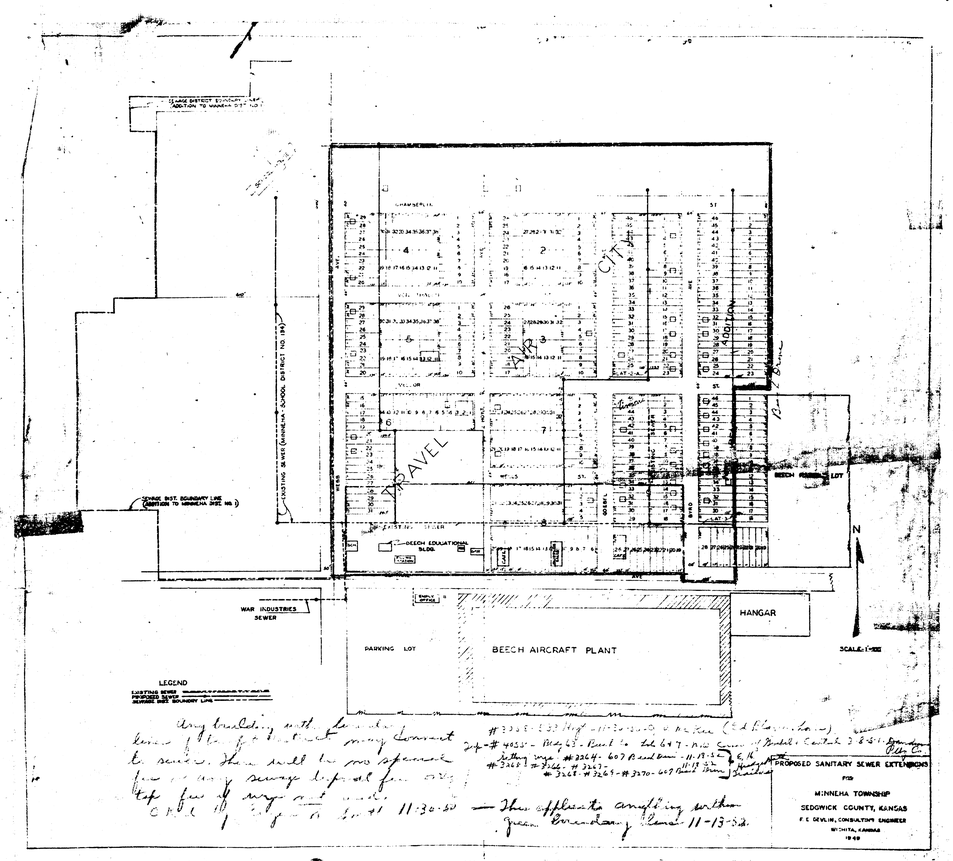
SCHOOL DIST. BOUNDARY LINE (ADDITION TO MINNEHA DIST. NO. 1)
EXISTING SEWER (MINNEHA SCHOOL DISTRICT NO. 1)
GRAVEL
CITY
ADDITION
BEECH EDUCATIONAL BLDG.
BEECH PARKING LOT
WAR INDUSTRIES SEWER
PARKING LOT
BEECH AIRCRAFT PLANT
HANGAR
N
SCALE: 1"=200'
LEGEND
EXISTING SEWER
PROPOSED SEWER
MINNEHA DIST. BOUNDARY LINE
PROPOSED SANITARY SEWER EXTENSIONS
FOR
MINNEHA TOWNSHIP
SEDGWICK COUNTY, KANSAS
F.E. DEVLIN, CONSULTING ENGINEER
WICHITA, KANSAS
1949

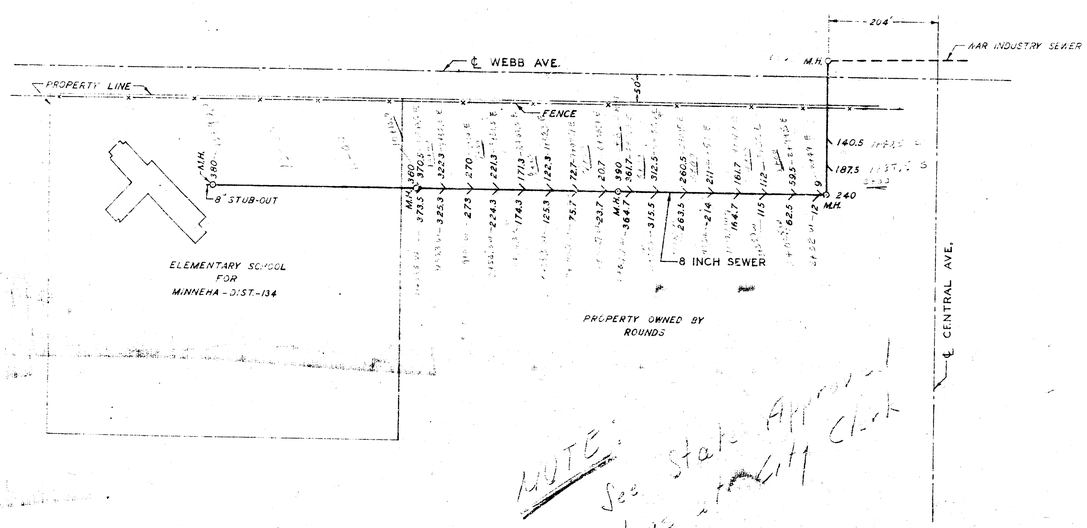

NOTE: See State Approval plans at City Clerk Office.

SCALE ~ 1" = 100'

WYE MAP
OF
SANITARY SEWER
MINNEHA-SCHOOL DIST. NO. 134
SEDGWICK COUNTY, KANSAS

F. E. DEVLIN, CONSULTING ENGINEER
WICHITA, KANSAS
1949

NOTE —

ALL WYE MEASUREMENTS TAKEN FROM
THE NEAREST DOWNSTREAM MANHOLE.

#779 - Inf - Minneha School - 7-6-49 - Omer Bros.
#5992 - Top " " 8-26-52 - [illegible]
#5973 - Top " " 8-26-52