

B.M. 108 ft. CITY STANDARD N.E. cor. HILLSIDE & DAWNEE 2.5'E Guy pole & 25' N. of 'X' on curb.

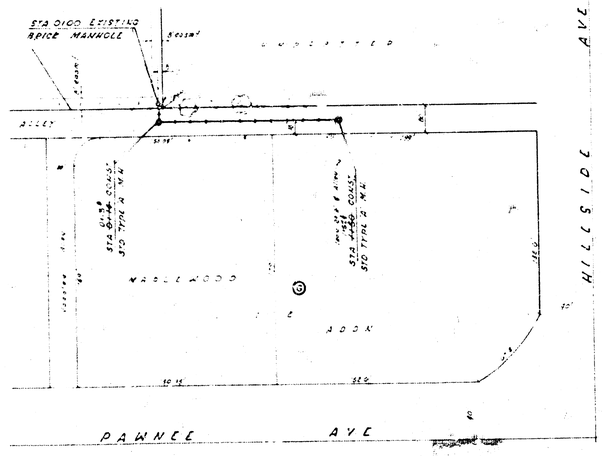

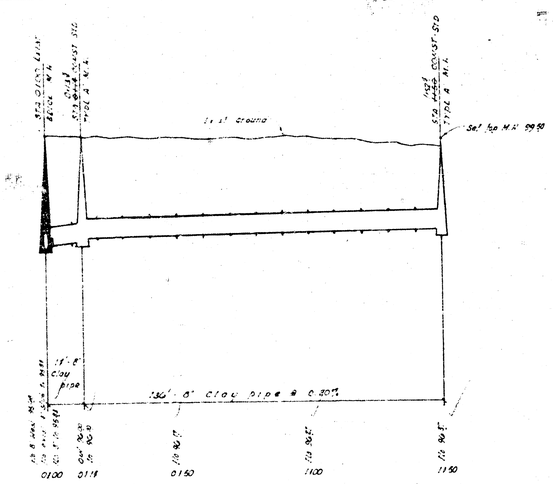

N

Note: Existing private sanitary line to be abandoned, and all service lines connected to private sewer to be re connected to new sewer construction. All costs for re connections to be incidental to project.

PLAN Scale 1"=50'
"PROFILE"
1"=5' VERT
1"=50' HORZ

NOTE TO CONTRACTOR

This project will be constructed under the supervision of the CITY ENGINEER and conforming to the SPECIFICATIONS of the CITY OF WICHITA. The CONTRACTOR will reimburse the City of Wichita for all cost of Engineering, Plans, and Inspection.

As Built Is Same Final Measurement in Ink

SANITARY SEWER
N.W. cor of HILLSIDE & DAWNEE-MOBIL OIL CO. (PRIVATE CONTRACT)
CITY OF WICHITA, KANSAS
R.W. LINN CITY ENGINEER
DATE SEPT. 1970 PROJECT NO. SAEB 502038

14 4 5 18